


REFERENCE DRAWING	DWG. NO.
SYMBOLS AND IDENTIFICATIONS	1208-01-PR-PID-051-01

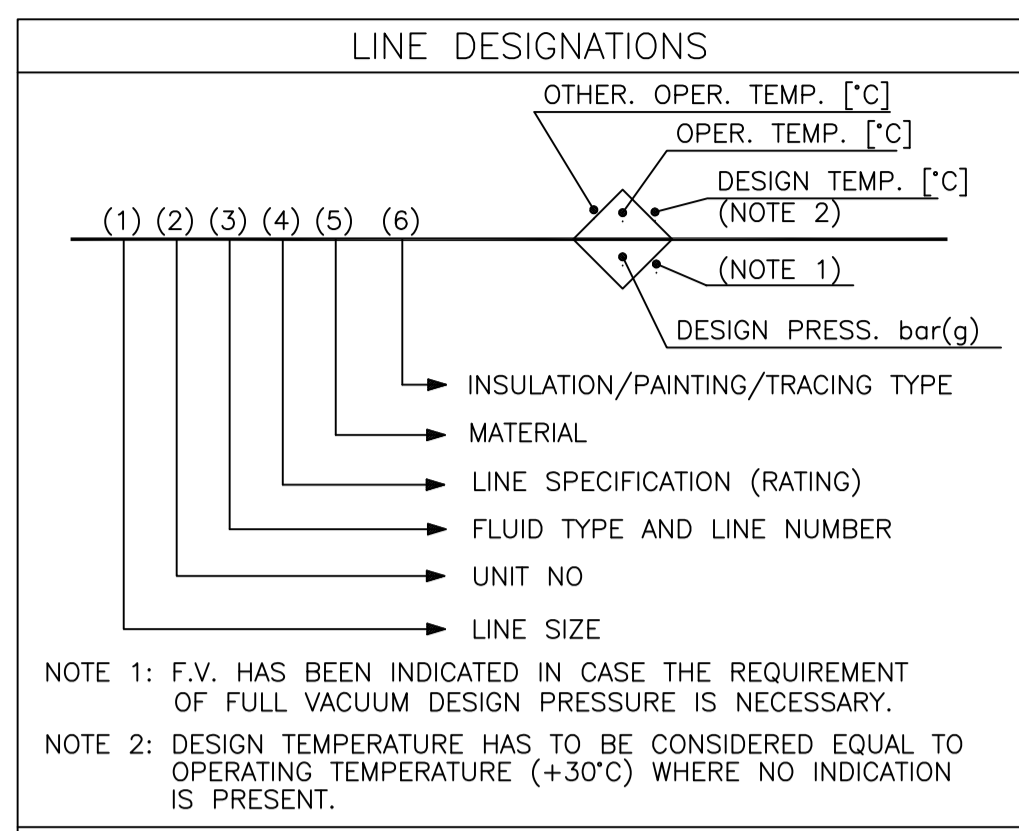

- ### FLUID TYPE
- UP = UREA PROCESS FLUIDS.
SA = PLANT AIR (SERVICE AIR)
CWS/CHR = CIRCULATING COOLING WATER SUPPLY/RETURN.
CY = CHEMICAL WATER (UREA).
OY = OIL SEWER.
SY = POTENTIALLY OILY CONTAMINATED WATER.
HS = HIGH PRESSURE SUPERHEATED STEAM (O.P.= 39 bar(g); O.T.= 370°C).
MS = MEDIUM PRESSURE SUPERHEATED STEAM (O.P.= 23.7 bar(g); O.T.= 327°C).
MSS = MEDIUM PRESSURE SATURATED STEAM (O.P.= 21.8 bar(g); O.T.= 219°C).
MLS = MEDIUM LOW PRESSURE SATURATED STEAM (O.P.= 5.5 bar(g); O.T.= 162°C).
LS = LOW PRESSURE SATURATED STEAM (O.P.= 3.4 bar(g); O.T.= 147°C).
CO2 = CARBON DIOXIDE (CO2 GAS).
NHG = AMMONIA GAS.
NHL = AMMONIA LIQUID.
NHH = HIGH PRESSURE AMMONIA LIQUID.
KW = HIGH PRESSURE WASHING CONDENSATE. (O.P.= 170 bar (g); O.T.=120°C).
HW = MEDIUM PRESSURE WASHING CONDENSATE. (O.P.= 24.5 bar (g); O.T.=120°C).
LW = LOW PRESSURE WASHING CONDENSATE. (O.P.= 8 bar (g); O.T.=120°C).
MC = MEDIUM PRESSURE CONDENSATE.
LC = LOW PRESSURE CONDENSATE.
CD = CLOSE DRAIN (TO 11-TK-104).
BD = BLOW DOWN.
FL = TO FLARE.
SW = SERVICE WATER.
DW = DEMI WATER / DEMINERALIZED WATER CLOSED CIRCUIT.
IA = INSTRUMENT AIR.
UD = UREA DUST.
UG = UREA GRANULATED
NG = NATURAL GAS
NIT = NITROGEN.
FG = FUEL GAS.
UF = UREA/FORMALDEHYDE/WATER SOLUTION.
OD = OPEN DRAIN (TO 11-TK-153).
AIR = ATMOSPHERIC AIR.
PC = PROCESS CONDENSATE.
CHM = AMMONIA SULPHATE. (CHEMICAL)
SAC = SULFURIC ACID.
VG = VENT GAS.
CDS = AMMONIA SULPHATE CLOSE DRAIN (TO 11-TK-158).
PW = POTABLE WATER
LO = LUBE OIL
VG = VENT GAS

- ### INSULATION/PAINTING/TRACING TYPE
- ET= ELECTRIC TRACED LINE
C= COLD INSULATED LINE (TEMP.: +5°C/-273°C)
H= HOT INSULATED LINE (TEMP.: +6°C AND ABOVE)
N= NOT PAINTED AND NOT INSULATED LINE
ST= STEAM TRACED LINE
DT= DOUBLE STEAM TRACED LINE
V= LINE WITH EXTERNAL PAINTING ONLY
SJ= JACKETED LINE
P= PERSONAL PROTECTION
UW= UNDER GROUND LINE

- ### INSTRUMENT LINE SYMBOLS
- = CONNECTION TO PROCESS
-x-x-x- = CAPILLARY TUBING (FILLED SYSTEM)
-// -// = PNEUMATIC SIGNAL
-L-L-L- = HYDRAULIC SIGNAL
-E-E-E- = ELECTRIC SIGNAL
-O-O-O- = INTERNAL SYSTEM LINK (SOFTWARE OR DATALINK)
AS → = AIR SUPPLY
ES → = ELECTRIC SUPPLY
GS → = GAS SUPPLY (EXCEPT AIR AND NITROGEN)
HS → = HYDRAULIC SUPPLY
NS → = NITROGEN SUPPLY
SS → = STEAM SUPPLY
WS → = WATER SUPPLY

- ### VALVES
- = GATE
 - = GLOBE
 - = CHECK
 - = PLUG
 - = BALL
 - = 3-WAY
 - = 4-WAY
 - = ANGLE
 - = DIAPHRAGM
 - = BUTTERFLY
 - = SINGLE BODY TYPE (WITH SINGLE THREE WAY PLUG)
 - = SINGLE BODY TYPE (WITH DOUBLE THREE WAY PLUG)
 - = PRESSURE RELIEF OR SAFETY VALVE ANGLE PATTERN. SPRING OR WEIGHT LOADED OR WITH INTEGRAL PILOT
 - = VACUUM BREAKER
 - = CONTROL VALVE DIAPHRAGM OPERATED
 - = CONTROL VALVE (WITH HAND ACTUATOR-SIDE MOUNTED)
 - = CONTROL VALVE (ON-OFF)
 - = ELECTRIC MOTOR OPERATED
 - = SOLENOID OPERATED
 - = CAR SEAL OPEN
 - = CAR SEAL CLOSED
 - = NORMALLY OPEN
 - = NORMALLY CLOSED
 - = NEEDLE VALVE
 - = BACKPRESSURE REGULATOR
 - = LOCKED OPEN
 - = LOCKED CLOSED
 - = AUTOMATIC NON RETURN/ MINIMUM FLOW VALVE (WITH NON RETURN VALVES IN BOTH DIRECTION)
 - = AUTOMATIC NON RETURN/ MINIMUM FLOW VALVE

- ### MISCELLANEOUS
- = STEAM TRAP (FLOATING TYPE)
 - = STEAM TRAP (THERMAL TYPE)
 - = Y STRAINER
 - = BASKET STRAINER HS = HOSE STATION
 - = T STRAINER SES = SAFETY SHOWER
 - = SPECTABLE BLIND CB = CATCH BASIN
 - = DRIP RING MO = MANHOLE
 - = SINGLE BLIND DU = DUCT
 - = BLIND FLANGE
 - = CAP (BUTT WELD)
 - = SCREWED CAP
 - = REDUCER
 - = HOSE CONNECTION
 - = SPECIAL LENS GASKET (USED IN HIGH PRESSURE SECTION)
 - = SPECIAL LENS GASKET WITH NIPPLE (USED IN HIGH PRESSURE SECTION)
 - = OPEN SEWER (FUNNEL)
 - = EXPANSION JOINT

- ### PIPING REQUIREMENT (REFER TO DOC. ZA-E-06667)
- SLOPE (XXX) = SLOPED PIPE (WITH SPECIFIC SLOPE REQUIREMENT)
 - NO POCKET = NO LOW POINT LINE
 - LPT = LOWEST POINT
 - HPT = HIGHEST POINT


- ### INSTRUMENTS INDICATIONS
- = LOCAL FIELD INSTRUMENT
 - = INSTRUMENT ON PANEL OR HARD CONSOLE IN CENTRAL CONTROL ROOM
 - = INSTRUMENT ON LOCAL PANEL
 - = LOCAL INSTRUMENT FOR MORE THAN ONE FUNCTION
 - = DISTRIBUTED CONTROL SYSTEM (DCS) FUNCTION IN CENTRAL CONTROL ROOM
 - = DCS AUXILIARY INTERFACE DEVICE
 - = SHUTDOWN LOGIC ON ESD
 - = LOGIC ON DCS
 - = INSTRUMENT PURGE
 - = INSTRUMENT LOCATED IN THE BACK BOARD
 - = LAMP ON DCS

- ### INSTRUMENTS ELEMENTS
- PIPING ASSEMBLY NUMBER FOR INSTRUMENTATION (REFER TO DOC. GA-E-60902) (NOTE 8)
- = ORIFICE PLATE WITH FLANGE OR CORNER TAPS
 - = PITOT TUBE OR ANNUBAR
 - = TURBINE TYPE PRIMARY ELEMENT
 - = POSITIVE DISPLACEMENT TYPE FLOW TOTALIZING INDICATOR
 - = ROTAMETER
 - = FLOW STRAIGHTENING VANES
 - = VENTURI TUBE OR FLOW NOZZLE
 - = RESTRICTION ORIFICE
 - = RUPTURE DISK OR SAFETY HEAD FOR PRESSURE RELIEF
 - = FLOW SIGHT GLASS
 - = MAGNETIC FLOW METER
 - = MASS FLOW METER
 - = DIAPHRAGM SEAL
 - = PULSATION DAMPNER

- ### CONTROL VALVES
- ACTUATOR ACTION IN EVENT OF ACTUATOR POWER FAILURE:
- FO = FAIL OPEN
 - FC = FAIL CLOSED
 - FL (...) = FAIL LOCKED (AS IT IS)
- FINAL POSITION:
C = CLOSED
O = OPEN

INSTRUMENTS (as per ISA S 5.1)

MEASURED VARIABLE	TYPICAL INSTRUMENT NAMES (IDENTIFICATION LETTERS)															
	ANALYSIS	DENSITY	FLOW	HAND	LEVEL	CURRENT	PRESSURE	DIFFERENTIAL PRESSURE	SPEED	TEMPERATURE	MULTIVARIABLE	VISCOSITY	POSITION			
ALARM	HIGH LOW	AAH AAL			LAH LAL	IAH IAL	PAH PAL	PDH PDL			UA					
CONTROLLER		AC	FC	HC	LC	PC	PDC	SC	TC				ZC			
CONTROL VALVE		AV	FV	HV	LV	PV	PDV	SV	TV							
SELF ACTUATED CONTROL VALVE		ACV	FCV	HCV	LCV	PCV	PDCV	SCV	TCV							
PRIMARY ELEMENT		AE	DE	FE	LE	PE	PDE	SE	TE				ZE			
GLASS			FG	LG												
INDICATOR		AI	DI	FI	LI	II	PI	PDI	SI	TI	UI	VI	ZI			
INDICATING - CONTROLLER		AIC	FIC	HIC	LIC		PIC	PDIC	SIC	TIC						
INTEGRATOR			FQ													
RATIO RELAY		AFY	FFY	LFY		PFY	PDFY		TFY							
RESTRICTION ORIFICE			FO													
COMPUTING RELAY, SOLENOID VALVE, CONVERTER, ETC.		AY	FY	HY	LY	PY	PDY	SY	TY				ZY			
RUPTURE DISK						PSE										
SAFETY VALVE						PSV										
SWITCH		AS	FS	HS	LS	PS	PDS	SS	TS				ZS			
HIGH SWITCH		ASH	FSH	LSH	PSH	PDSH	SSH	TSH					ZSH			
HIGH HIGH SWITCH (WITH CONNECTION TO INTERLOCK SYSTEM (ESD))		ASXH	FSXH	LSXH	ISXH	PSXH	PDSXH	TSXH					ZSXH			
LOW SWITCH		ASL	FSL	LSL	PSL	PDSL	SSL	TSL					ZSL			
LOW LOW SWITCH (WITH CONNECTION TO INTERLOCK SYSTEM (ESD))		ASXL	FSXL	LSXL	ISXL	PSXL	PDSL	TSXL					ZSXL			
TRANSMITTER		AT	DT	FT	LT	IT	PT	PDT	ST	TT		VT	ZT			
WELL										TW						
INDICATING LIGHT		AL	FL	LL	PL	PDL	SL	TL	EL	ZL						
LIMIT SWITCH (HIGH POSITION)													ZSH			
LIMIT SWITCH (LOW POSITION)													ZSL			
ON-OFF VALVE (WITH CONNECTION TO INTERLOCK SYSTEM (ESD))													XV			
HAND SWITCH FORCED				HSF												

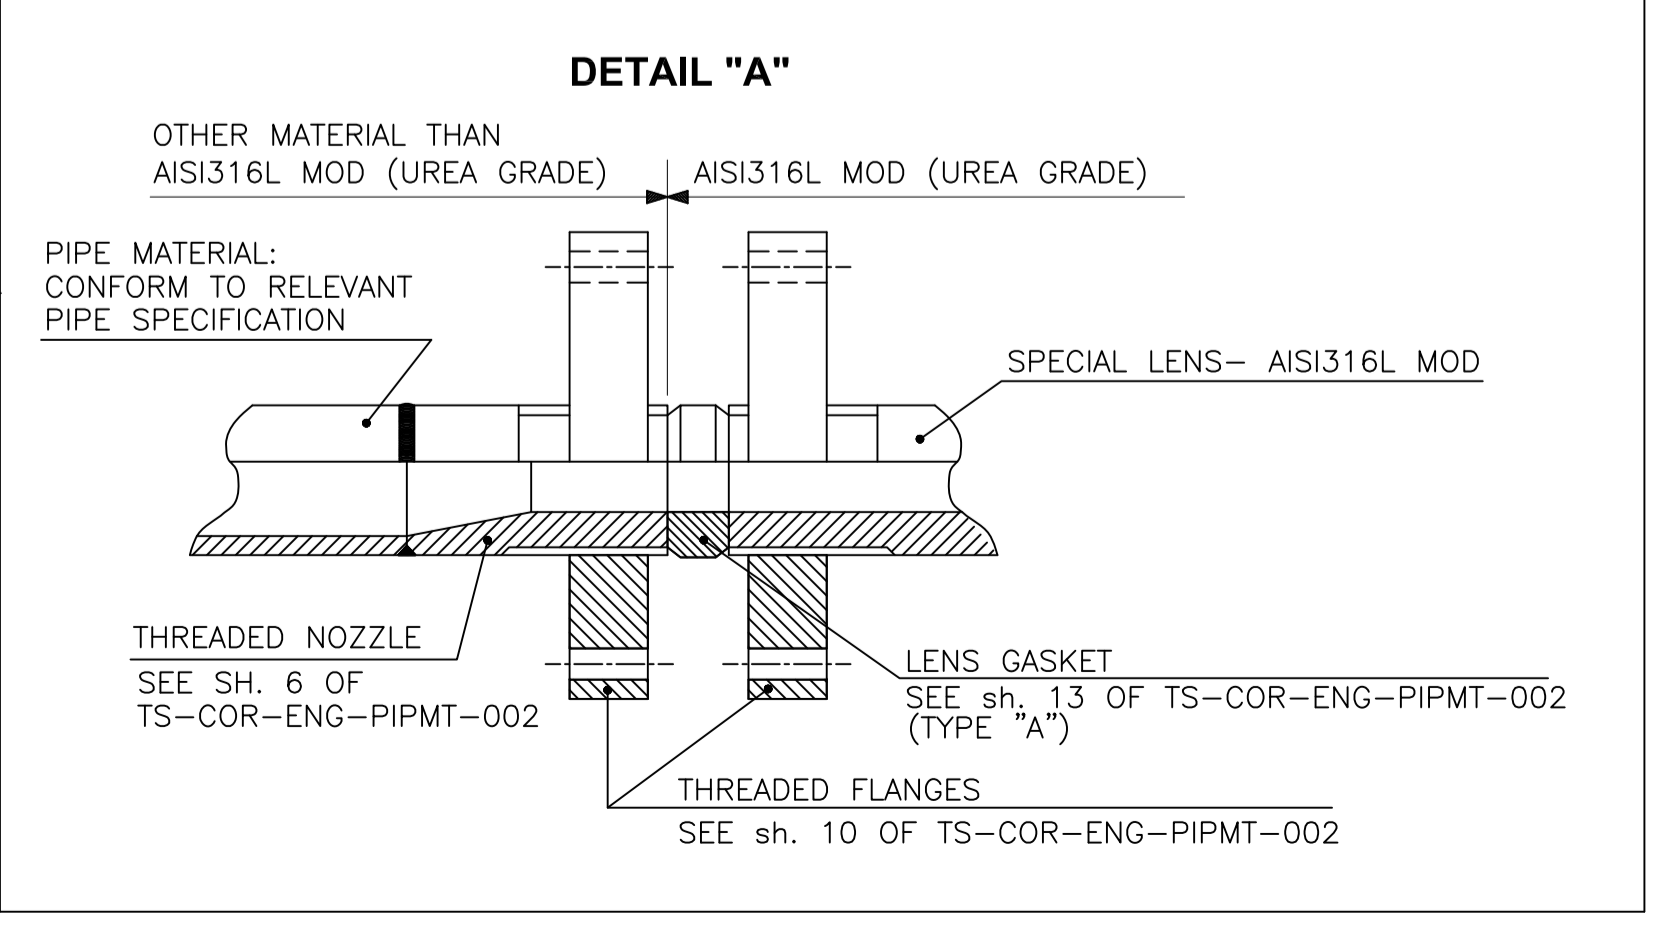


- ### GENERAL NOTES:
- = BATTERY OR PACKAGE UNIT
 - CONTRACTOR MANUFACTURER/SUPPLIER
 - MIN = WHERE IT'S INDICATED "MIN" OR "MINIMUM DISTANCE" THE LENGTH OF THE INTERESTED PIPE TO BE KEPT AS SHORT AS POSSIBLE (ABOUT ONE HUNDRED MILLIMETERS) IN ORDER TO PREVENT DEAD ZONES AND CONSEQUENT CRYSTALLIZATION PROBLEMS.
 - CONVERTER IS AN INTEGRAL PART OF ELECTRO-PNEUMATIC POSITIONER (4-20mA OR FIELD BUS FOUNDATION AS APPLICABLE) ALONG WITH THE VALVE.
 - LT ON UPSTREAM VESSELS TO BE VISIBLE FORM LV BYPASS VALVE.
 - TAG NUMBER OF FLOW ELEMENT WILL BE THE SAME OF TAG INSTRUMENTS SHOWN IN P&IDs.
 - FOR SAMPLE CONNECTION DETAIL IN UREA SYNTHESIS AND GRANULATION REFER TO 1208-11-PR-PID-080/081.
 - ALL PRESSURE TRANSMITTERS ARE EQUIPPED WITH ISOLATING VALVES EXCEPT FOR ASSEMBLY NUMBERS 20J AND 20K. FOR MORE DETAIL REFER TO DOCUMENT GA-E-60902.

PIPING MATERIALS

04 = GALVANIZED
24 = CS
26 = CS (PTFE LINED)
40 = SS304L
42 = SS316L
43 = SS316L (ALLOY TRIM)
70 = ALLOY 20
14U = LOW TEMP. CS
40U = SS304L (UREA GRADE)
42U = SS316L (UREA GRADE)
L90 = UREA GRADE SS (AISI 316L MOD.)
M90 = UREA GRADE SS (AISI 316L MOD.)
K90 = (AISI 316L MOD. MEDIUM PRESSURE)

FIRST LETTER INDICATES FLANGE RATING:
B = 150 #
D = 300 #
F = 600 #
G = 900 #
H = 1500 #
J = 2500 #

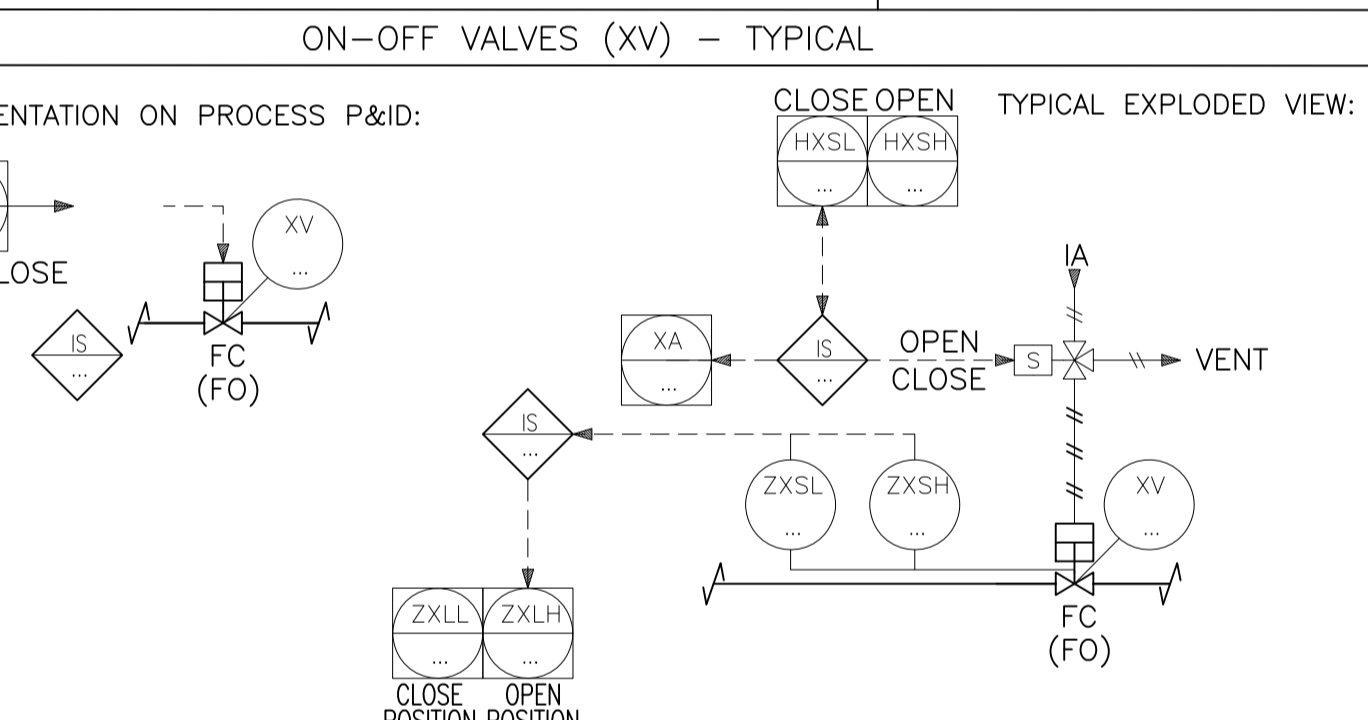

LICENSOR REF. : P40

DE	EXT	AFC	A
Eng. Phase	Purpose of Distribution (POD)	Purpose of Issue (POI)	Owner's Action
03	31.12.2023	APPROVED FOR CONSTRUCTION	M.Fakhraei A.Azma A.Azma M.Saremi
02	04.09.2023	APPROVED FOR CONSTRUCTION	M.Fakhraei A.Azma A.Azma M.Saremi
01	13.06.2018	APPROVED FOR CONSTRUCTION	M.Yazdarpour A.Azma A.Azma M.Saremi
00	21.01.2018	ISSUED FOR ENGINEERING	F.Mirzale A.Habibi A.Azma M.Saremi

THIS DOCUMENT IS THE PROPERTY OF HFC. IT IS CONFIDENTIAL AND ALL RIGHTS RESERVED. NEITHER THE WHOLE NOR PART OF THIS DOCUMENT MAY BE DISCLOSED TO ANY THIRD PARTY. REPRODUCED, STORED IN ANY RETRIEVAL SYSTEM OR TRANSMITTED IN ANY FORM OR BY ANY MEANS WITHOUT THE PRIOR WRITTEN CONSENT OF HFC.

OWNER:

MC:

EPCC CONTRACTOR:

PROJECT: HENGAM FERTILIZER PROJECT

TITLE: PIPING AND INSTRUMENTATION DIAGRAM SYMBOLS AND IDENTIFICATION FOR UREA SYNTHESIS AND GRANULATION PLANT

SCALE: N.T.S

OWNER PROJECT NO.: NA

DWG. NO.: 1208-01-PR-PID-051



REV. 03

SIZE: A1

SH. 1 OF 2

PIDEC PROJECT NO.: 1208

TYPICAL MOTOR TYPE

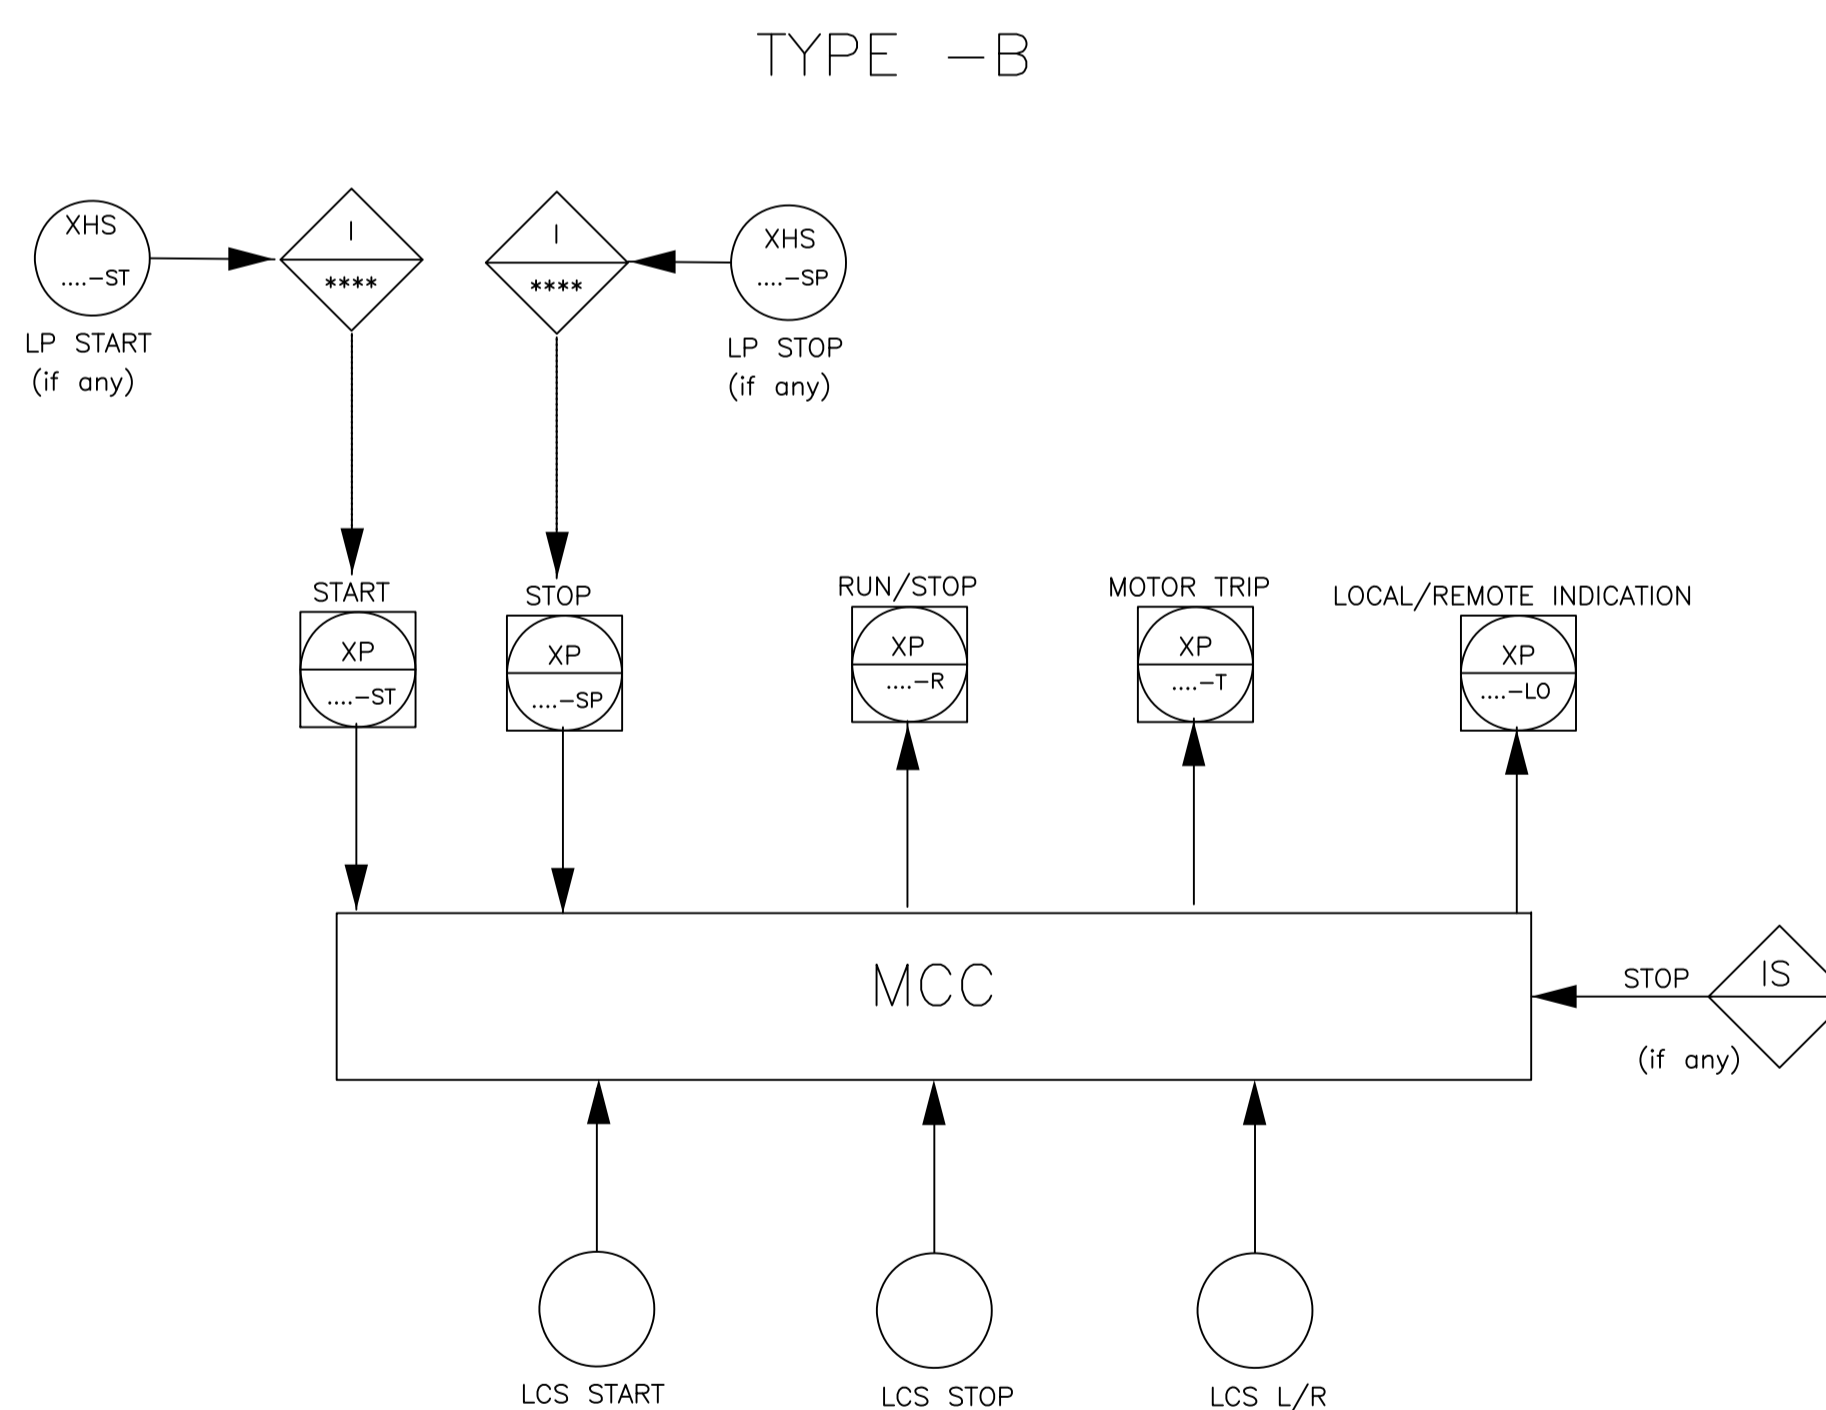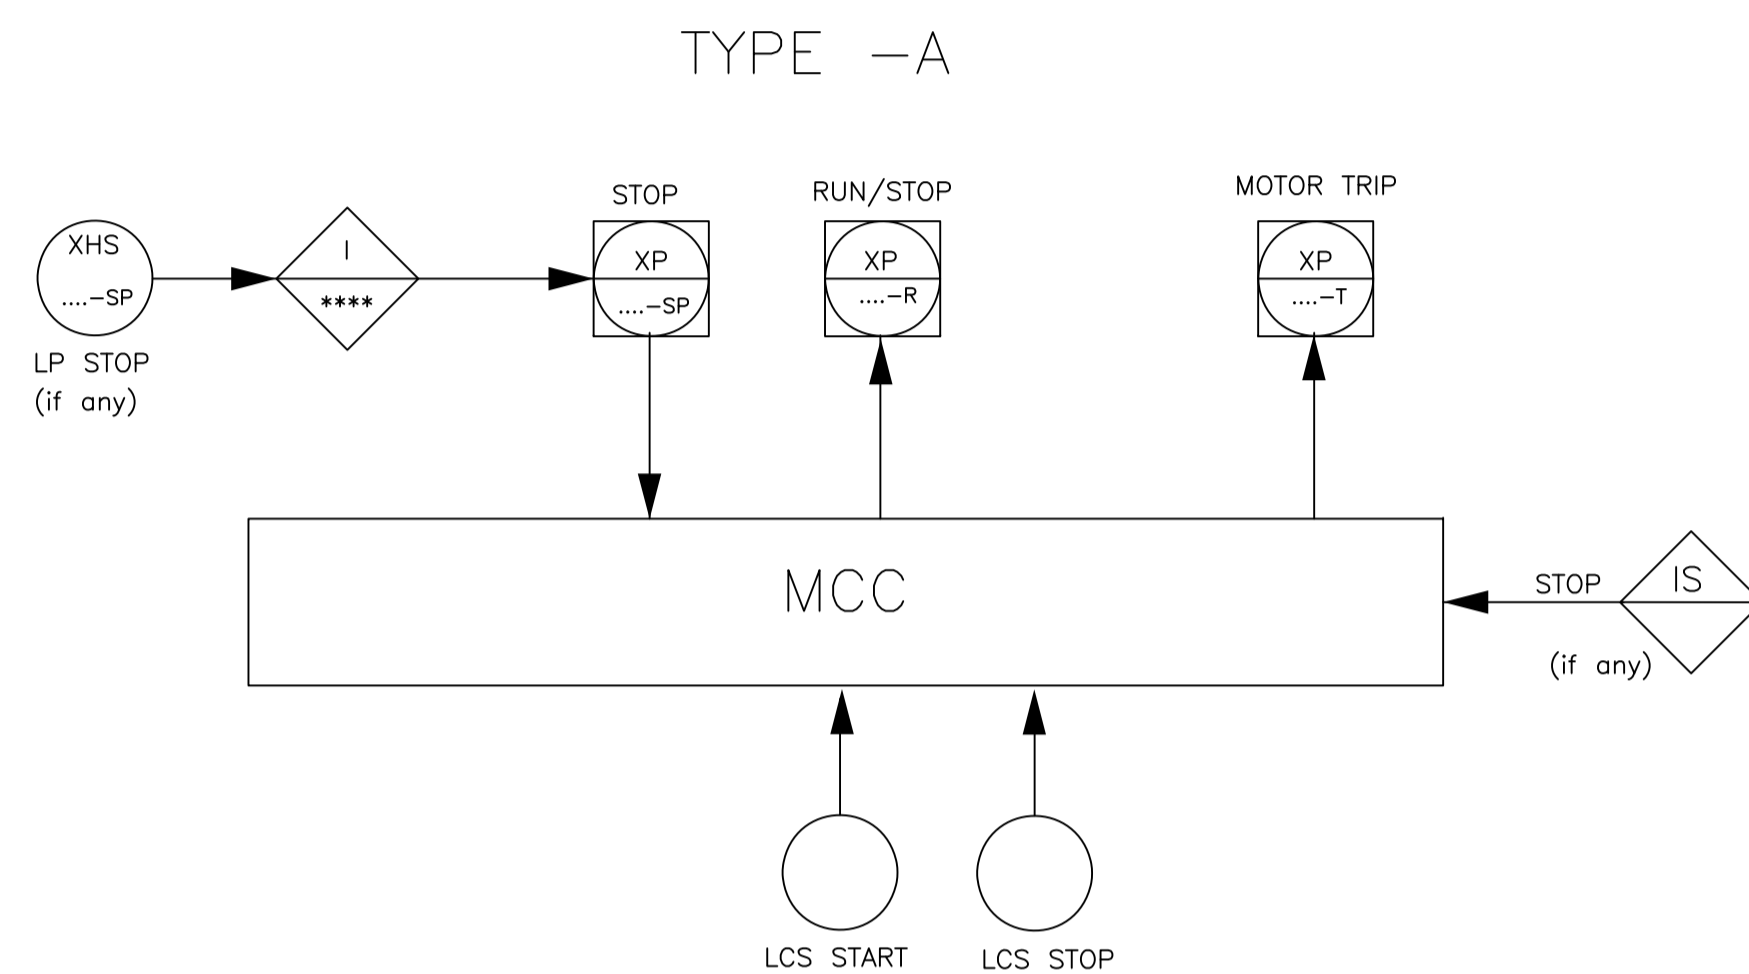

LIST OF PROCESS & INSTRUMENTATION DIAGRAM

1208-01-PR-PID-051 (SHEET 1 & 2)	PIPING AND INSTRUMENTATION DIAGRAM SYMBOLS AND IDENTIFICATION FOR UREA SYNTHESIS AND GRANULATION PLANT
1208-11-PR-PID-051	PIPING AND INSTRUMENTATION DIAGRAM AMMONIA HIGH PRESSURE PUMPS
1208-11-PR-PID-052	PIPING AND INSTRUMENTATION DIAGRAM CARBAMATE HIGH PRESSURE PUMPS
1208-11-PR-PID-053	PIPING AND INSTRUMENTATION DIAGRAM HIGH PRESSURE SECTION 1 OF 4
1208-11-PR-PID-054	PIPING AND INSTRUMENTATION DIAGRAM HIGH PRESSURE SECTION 2 OF 4
1208-11-PR-PID-055	PIPING AND INSTRUMENTATION DIAGRAM HIGH PRESSURE SECTION 3 OF 4
1208-11-PR-PID-056	PIPING AND INSTRUMENTATION DIAGRAM HIGH PRESSURE SECTION 4 OF 4
1208-11-PR-PID-057	PIPING AND INSTRUMENTATION DIAGRAM MEDIUM PRESSURE SECTION 1 OF 4
1208-11-PR-PID-058	PIPING AND INSTRUMENTATION DIAGRAM MEDIUM PRESSURE SECTION 2 OF 4
1208-11-PR-PID-059	PIPING AND INSTRUMENTATION DIAGRAM MEDIUM PRESSURE SECTION 3 OF 4
1208-11-PR-PID-060	PIPING AND INSTRUMENTATION DIAGRAM MEDIUM PRESSURE SECTION 4 OF 4
1208-11-PR-PID-061	PIPING AND INSTRUMENTATION DIAGRAM LOW PRESSURE SECTION 1 OF 3
1208-11-PR-PID-062	PIPING AND INSTRUMENTATION DIAGRAM LOW PRESSURE SECTION 2 OF 3
1208-11-PR-PID-063	PIPING AND INSTRUMENTATION DIAGRAM LOW PRESSURE SECTION 3 OF 3
1208-11-PR-PID-064	PIPING AND INSTRUMENTATION DIAGRAM VACUUM EVAPORATION SECTION 1 OF 5
1208-11-PR-PID-065	PIPING AND INSTRUMENTATION DIAGRAM VACUUM EVAPORATION SECTION 2 OF 5
1208-11-PR-PID-066	PIPING AND INSTRUMENTATION DIAGRAM VACUUM EVAPORATION SECTION 3 OF 5
1208-11-PR-PID-067	PIPING AND INSTRUMENTATION DIAGRAM VACUUM EVAPORATION SECTION 4 OF 5
1208-11-PR-PID-068	PIPING AND INSTRUMENTATION DIAGRAM VACUUM EVAPORATION SECTION 5 OF 5
1208-11-PR-PID-069	PIPING AND INSTRUMENTATION DIAGRAM PROCESS CONDENSATE TREATMENT SECTION 1 OF 4
1208-11-PR-PID-070	PIPING AND INSTRUMENTATION DIAGRAM PROCESS CONDENSATE TREATMENT SECTION 2 OF 4
1208-11-PR-PID-071	PIPING AND INSTRUMENTATION DIAGRAM PROCESS CONDENSATE TREATMENT SECTION 3 OF 4
1208-11-PR-PID-072	PIPING AND INSTRUMENTATION DIAGRAM PROCESS CONDENSATE TREATMENT SECTION 4 OF 4
1208-11-PR-PID-073	PIPING AND INSTRUMENTATION DIAGRAM STEAM CONDENSATE RECOVERY SYSTEM
1208-11-PR-PID-074 (SHEET 1 & 2)	PIPING AND INSTRUMENTATION DIAGRAM WASHING SYSTEM
1208-11-PR-PID-075	PIPING AND INSTRUMENTATION DIAGRAM STEAM SYSTEM 1 OF 2
1208-11-PR-PID-076	PIPING AND INSTRUMENTATION DIAGRAM STEAM SYSTEM 2 OF 2
1208-11-PR-PID-077	PIPING AND INSTRUMENTATION DIAGRAM OFF SPEC TANK AND PUMPS
1208-11-PR-PID-078	PIPING AND INSTRUMENTATION DIAGRAM DEMINERALIZED WATER CLOSED CIRCUIT
1208-11-PR-PID-079	PIPING AND INSTRUMENTATION DIAGRAM BLOW DOWN SYSTEM
1208-11-PR-PID-080	PIPING AND INSTRUMENTATION DIAGRAM SAMPLE CONNECTION DETAIL
1208-11-PR-PID-081	PIPING AND INSTRUMENTATION DIAGRAM SAMPLE CONNECTION DETAIL
1208-18-PR-PID-051	PIPING AND INSTRUMENTATION DIAGRAM GRANULATOR FEED SYSTEM
1208-18-PR-PID-052	PIPING AND INSTRUMENTATION DIAGRAM GRANULATOR
1208-18-PR-PID-053	PIPING AND INSTRUMENTATION DIAGRAM GRANULATOR EXTRACTOR
1208-18-PR-PID-054	PIPING AND INSTRUMENTATION DIAGRAM GRANULATOR FLUIDIZATION AIR
1208-18-PR-PID-055	PIPING AND INSTRUMENTATION DIAGRAM GRANULATOR ATOMIZATION AIR
1208-18-PR-PID-056	PIPING AND INSTRUMENTATION DIAGRAM FIRST FLUID BED COOLER
1208-18-PR-PID-057	PIPING AND INSTRUMENTATION DIAGRAM ELEVATORS
1208-18-PR-PID-058	PIPING AND INSTRUMENTATION DIAGRAM SCREENING 1
1208-18-PR-PID-059	PIPING AND INSTRUMENTATION DIAGRAM SCREENING 2
1208-18-PR-PID-060	PIPING AND INSTRUMENTATION DIAGRAM ROLL CRUSHERS
1208-18-PR-PID-061	PIPING AND INSTRUMENTATION DIAGRAM FINAL FLUID BED COOLER
1208-18-PR-PID-062	PIPING AND INSTRUMENTATION DIAGRAM GRANULATOR DUST SCRUBBER
1208-18-PR-PID-063	PIPING AND INSTRUMENTATION DIAGRAM COOLER SCRUBBER
1208-18-PR-PID-064	PIPING AND INSTRUMENTATION DIAGRAM GRANULATION STACK
1208-18-PR-PID-065	PIPING AND INSTRUMENTATION DIAGRAM UREA SOLUTION RECYCLE
1208-18-PR-PID-066	PIPING AND INSTRUMENTATION DIAGRAM GRANULATION CONDENSATE RECOVERY SYSTEM
1208-18-PR-PID-067	PIPING AND INSTRUMENTATION DIAGRAM UF-85 STORAGE TANKS AND PUMPS
1208-18-PR-PID-068	PIPING AND INSTRUMENTATION DIAGRAM NH3 CHILLING SEPARATORS
1208-18-PR-PID-069	PIPING AND INSTRUMENTATION DIAGRAM SULPHURIC ACID STORAGE TANK AND PUMPS
1208-18-PR-PID-070	PIPING AND INSTRUMENTATION DIAGRAM GRANULATOR AMMONIA SCRUBBER
1208-18-PR-PID-071	PIPING AND INSTRUMENTATION DIAGRAM AMMONIUM SULPHATE CLOSE DRAIN
1208-18-PR-PID-072	PIPING AND INSTRUMENTATION DIAGRAM AMMONIUM SULPHATE STORAGE TANKS AND PUMPS
1208-18-PR-PID-073	PIPING AND INSTRUMENTATION DIAGRAM GRANULATOR UREA HEADERS DRAINS
1208-18-PR-PID-074	PIPING AND INSTRUMENTATION DIAGRAM GRANULATION DETAILS
1208-18-PR-PID-075	PIPING AND INSTRUMENTATION DIAGRAM START-UP BIN

LICENSOR REF. : P--

DE	EXT	AFC	A
Eng. Phase	Purpose of Distribution (POD)	Purpose of Issue (POI)	Owner's Action

REV.	ISSUE DATE	DESCRIPTION	PREPARED BY	CHECKED BY	APPROVED BY	PROJECT
03	31.12.2023	APPROVED FOR CONSTRUCTION	M.Fakhrabi	A.Azma	A.Azma	M.Saremi
02	04.09.2023	APPROVED FOR CONSTRUCTION	M.Fakhrabi	A.Azma	A.Azma	M.Saremi
01	13.06.2018	APPROVED FOR CONSTRUCTION	M.Yazdipour	A.Azma	A.Azma	M.Saremi
00	21.01.2018	ISSUED FOR ENGINEERING	F.Mirzale	A.Habibi	A.Azma	M.Saremi

OWNER:



MC:

EPCC CONTRACTOR:

PROJECT: HENGAM FERTILIZER PROJECT

TITLE: PIPING AND INSTRUMENTATION DIAGRAM SYMBOLS AND IDENTIFICATION FOR UREA SYNTHESIS AND GRANULATION PLANT

- NOTES:
- ALL SIGNALS WILL BE REPEATED IN FCS (BY REDUNDANT MODBUS)
 - TT(S) AND TG(S) ARE 1 1/2" FLANGE TYPE AND ACCORDING TO ANSI B16.5 EXCEPT FOR RATING 1500# AND HIGHER THAT ARE WELDED TYPE (IF ANY)
 - TEMPORARY STRAINER.
 - AXIAL NON-SLAM CHECK VALVE
 - ALL INSTRUMENT TAG NUMBER HAVE PREFIX OF NO. 11 FOR EXAMPLE 11-TG-10154
 - THE UPSTREAM AND DOWNSTREAM OF FE IS 12D AND 4D.
 - AS CLOSE AS POSSIBLE TO COMPRESSOR SUCTION.
 - LSH-10130 TO 10133 A/B/C HAVE SEPARATE NOZZLE CONNECTION FOR INSTALLING ON VESSEL
 - ALL THE MANUAL & CHECK VALVE IS STANDARD TYPE OF VALVE.
 - FYHS-10131 WILL SEND HIGHER INPUT VALUE TO CONTROL VALVE AUTOMATICALLY OR MANUALLY SELECTABLE VALUE BY OPERATOR.
 - TRIM LINE FOR:
 - 11-E-119A: 11-CWR11070-B24-V (SHELL SIDE); 11-CO211070-D24-N (TUBE SIDE)
 - 11-E-119B: 11-CWR11071-B24-V (SHELL SIDE); 11-CO211071-D50-N (TUBE SIDE)
 - 11-E-119C: 11-CWR11072-B24-V (SHELL SIDE); 11-CO211072-G50-N (TUBE SIDE)
 - TUBE RAPTURE
 - SAMPLING DEVICE

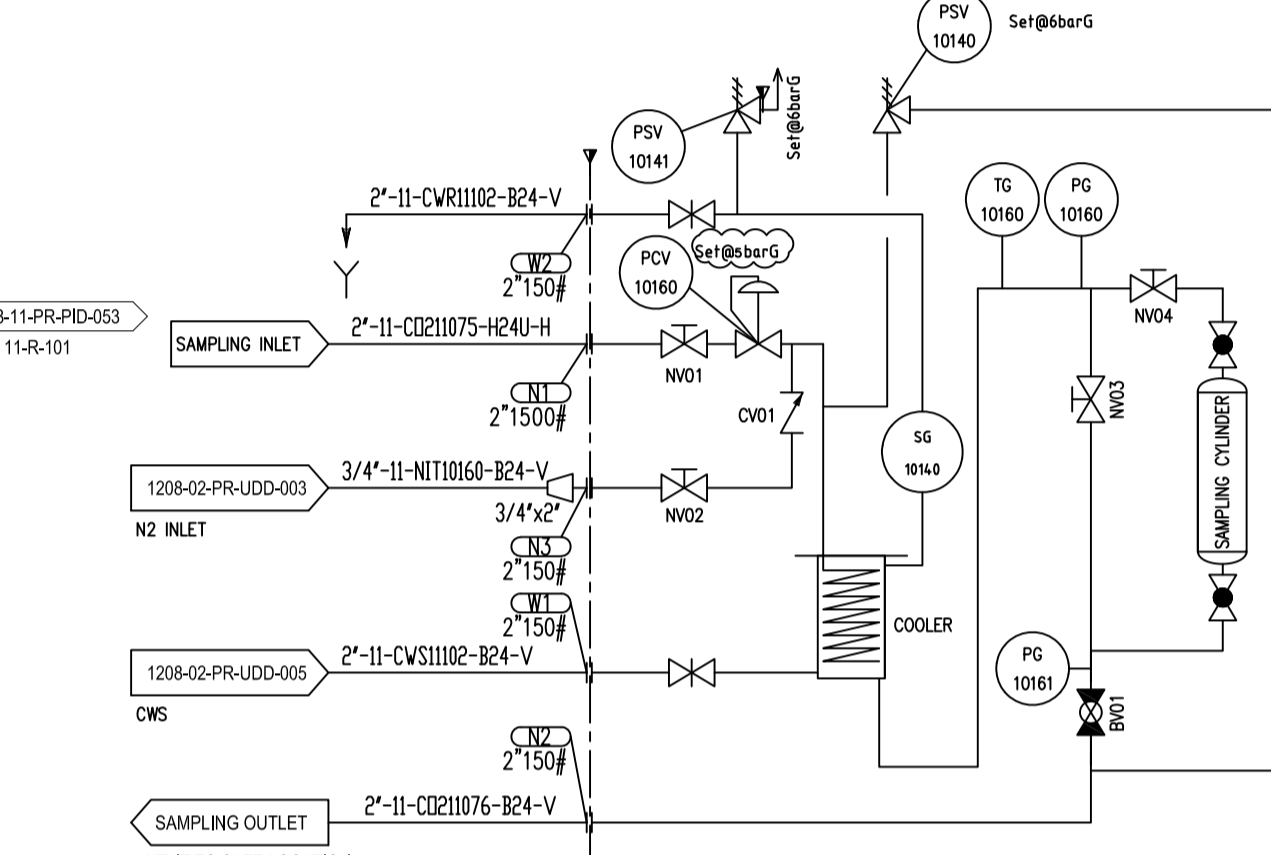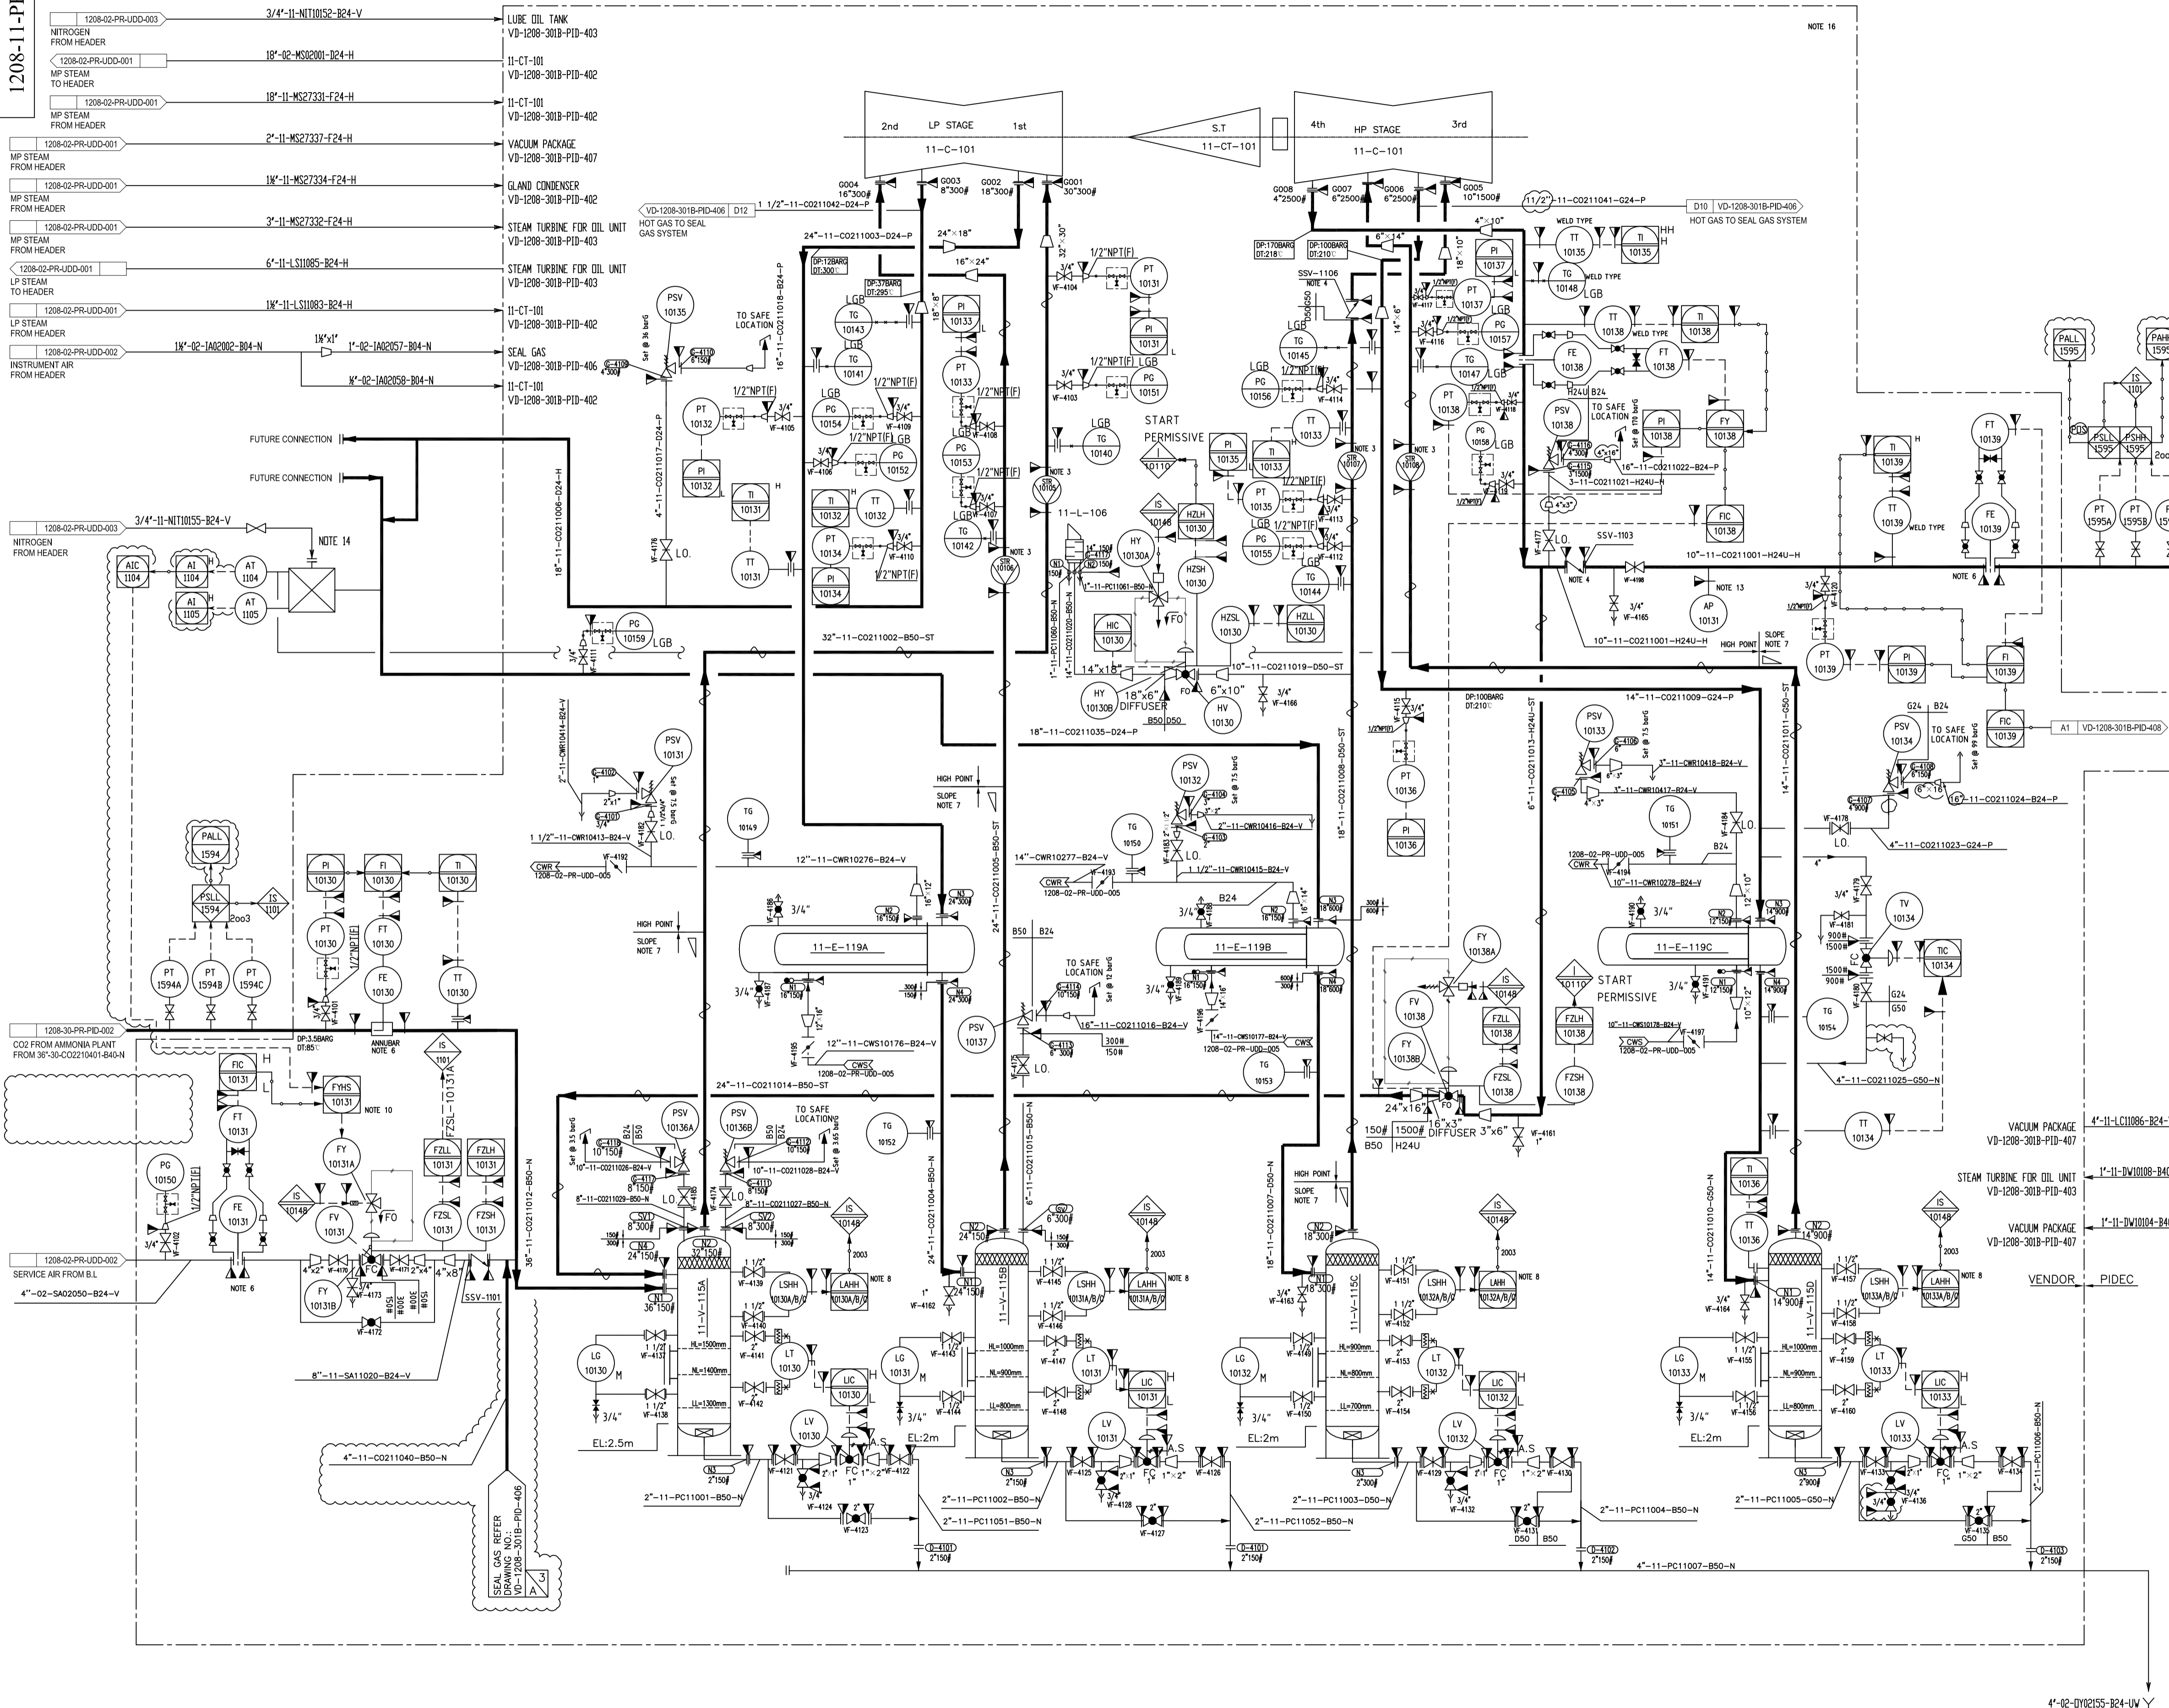

- 14- DIFFUSER FOR:
 11-HV-10130: 6"x10", 10"x14", 14"x18", CONNECTION DELIVER @ 18" BW
 11-FV-10138: 3"x4", 4"x6", 6"x10", 10"x16", CONNECTION DELIVER @ 16" BW
- 15- COMPRESSOR VENDOR SCOPE OF DESIGN / SUPPLY.
- 16- FOR COMPRESSOR VENDOR P&IDS REFER TO VD-1208-301B-PID-401 TO 408.

EQUIPMENT LIST

11-L-106	11-C-101	11-V-115A
11-E-119A	11-V-115B	
11-E-119B	11-V-115C	
11-E-119C	11-V-115D	

DE	EXT	AFC	A
Eng. Phase	Purpose of Distribution (POD)	Purpose of Issue (POI)	Owner's Action
04	13.09.2023	APPROVED FOR CONSTRUCTION	M.Fahrhadi, A.Azma, A.Azma, M.Sarangi
03	12.05.2021	APPROVED FOR CONSTRUCTION	M.Fahrhadi, A.Azma, A.Azma, M.Sarangi
02	07.04.2014	ISSUED FOR ENGINEERING	A.Panavas, A.Azma, A.Azma, S.Roopatour
01	18.03.2013	ISSUED FOR ENGINEERING	B.Jafar, A.Azma, A.Azma, S.Roopatour
00	17.10.2012	ISSUED FOR ENGINEERING	M.Khademi, A.Azma, A.Azma, S.Roopatour

REV.	ISSUE DATE	DESCRIPTION	PREPARED BY	CHECKED BY	APPROVED BY	PROJECT
01						

OWNER: MC: EPCC CONTRACTOR:


PROJECT: HENGAM FERTILIZER PROJECT

TITLE: PIPING AND INSTRUMENTATION DIAGRAM CO2 COMPRESSION PACKAGE

11-C-101 (11-C-101) CO2 COMPRESSOR	11-E-119A CO2 COMPRESSOR 1st STAGE COOLER	11-E-119B CO2 COMPRESSOR 2nd STAGE COOLER	11-E-119C CO2 COMPRESSOR 3rd STAGE COOLER	11-V-115A CO2 COMPRESSOR 1st STAGE SEPARATOR	11-V-115B CO2 COMPRESSOR 2nd STAGE SEPARATOR	11-V-115C CO2 COMPRESSOR 3rd STAGE SEPARATOR	11-V-115D CO2 COMPRESSOR 4th STAGE SEPARATOR	11-L-106 CO2 VENT SILENCER
RATED CAPACITY : 58712 Nm ³ /hr	SHELL LENGTH : 4600 mm	SHELL LENGTH : 5300 mm	SHELL LENGTH : 5300 mm	I.D. x T.L.T. : 3600 x 4600 mm	I.D. x T.L.T. : 2300 x 3200 mm	I.D. x T.L.T. : 1600 x 2800 mm	I.D. x T.L.T. : 1300 x 2500 mm	CAPACITY : 114.8 T/hr
RATED POWER : 14.511 MW	SHELL I.D. : 1600 mm	SHELL I.D. : 1400 mm	SHELL I.D. : 1000 mm	DESIGN PRESS. : 3.35 barg	DESIGN PRESS. : 12 barg	DESIGN PRESS. : 40 barg	DESIGN PRESS. : 100 barg	DESIGN PRESS. : 3.35 barg
TYPE : CENTRIFUGAL	DESIGN PRESS. S/T : 7.5 / 12 barg	DESIGN PRESS. S/T : 7.5 / 37 barg	DESIGN PRESS. S/T : 7.5 / 100 barg	DESIGN TEMP. : 85 °C	DESIGN TEMP. : 85 °C	DESIGN TEMP. : 85 °C	DESIGN TEMP. : 85 °C	DESIGN TEMP. : 85 °C
SUCTION PRESS. / TEMP. : 0.6 barg / 49°C	DESIGN TEMP. S/T : 85 / 300 °C	DESIGN TEMP. S/T : 85 / 295 °C	DESIGN TEMP. S/T : 85 / 210 °C	INSULATION : ND	INSULATION : ND	INSULATION : ND	INSULATION : ND	INSULATION : ND
DISCHARGE PRESS. / TEMP. : 162 barg / 126°C	INSULATION : ND	INSULATION : ND	INSULATION : ND	TRIM LINE : 11-CO211050-B50-N	TRIM LINE : 11-CO211051-B50-N	TRIM LINE : 11-CO211052-D50-N	TRIM LINE : 11-CO211052-G50-N	INSULATION : ND

FOR 11-P-101A/B DETAIL REFER TO:

VD-1208-307A-PID-111 (SHEET 6)	P&ID FOR SEAL FLUSHING
VD-1208-307A-PID-111 (SHEET 7 & 8)	P&ID FOR LUBE OIL UNIT
VD-1208-307A-PID-111 (SHEET 4 & 5)	P&ID FOR HP AMMONIA PUMPS

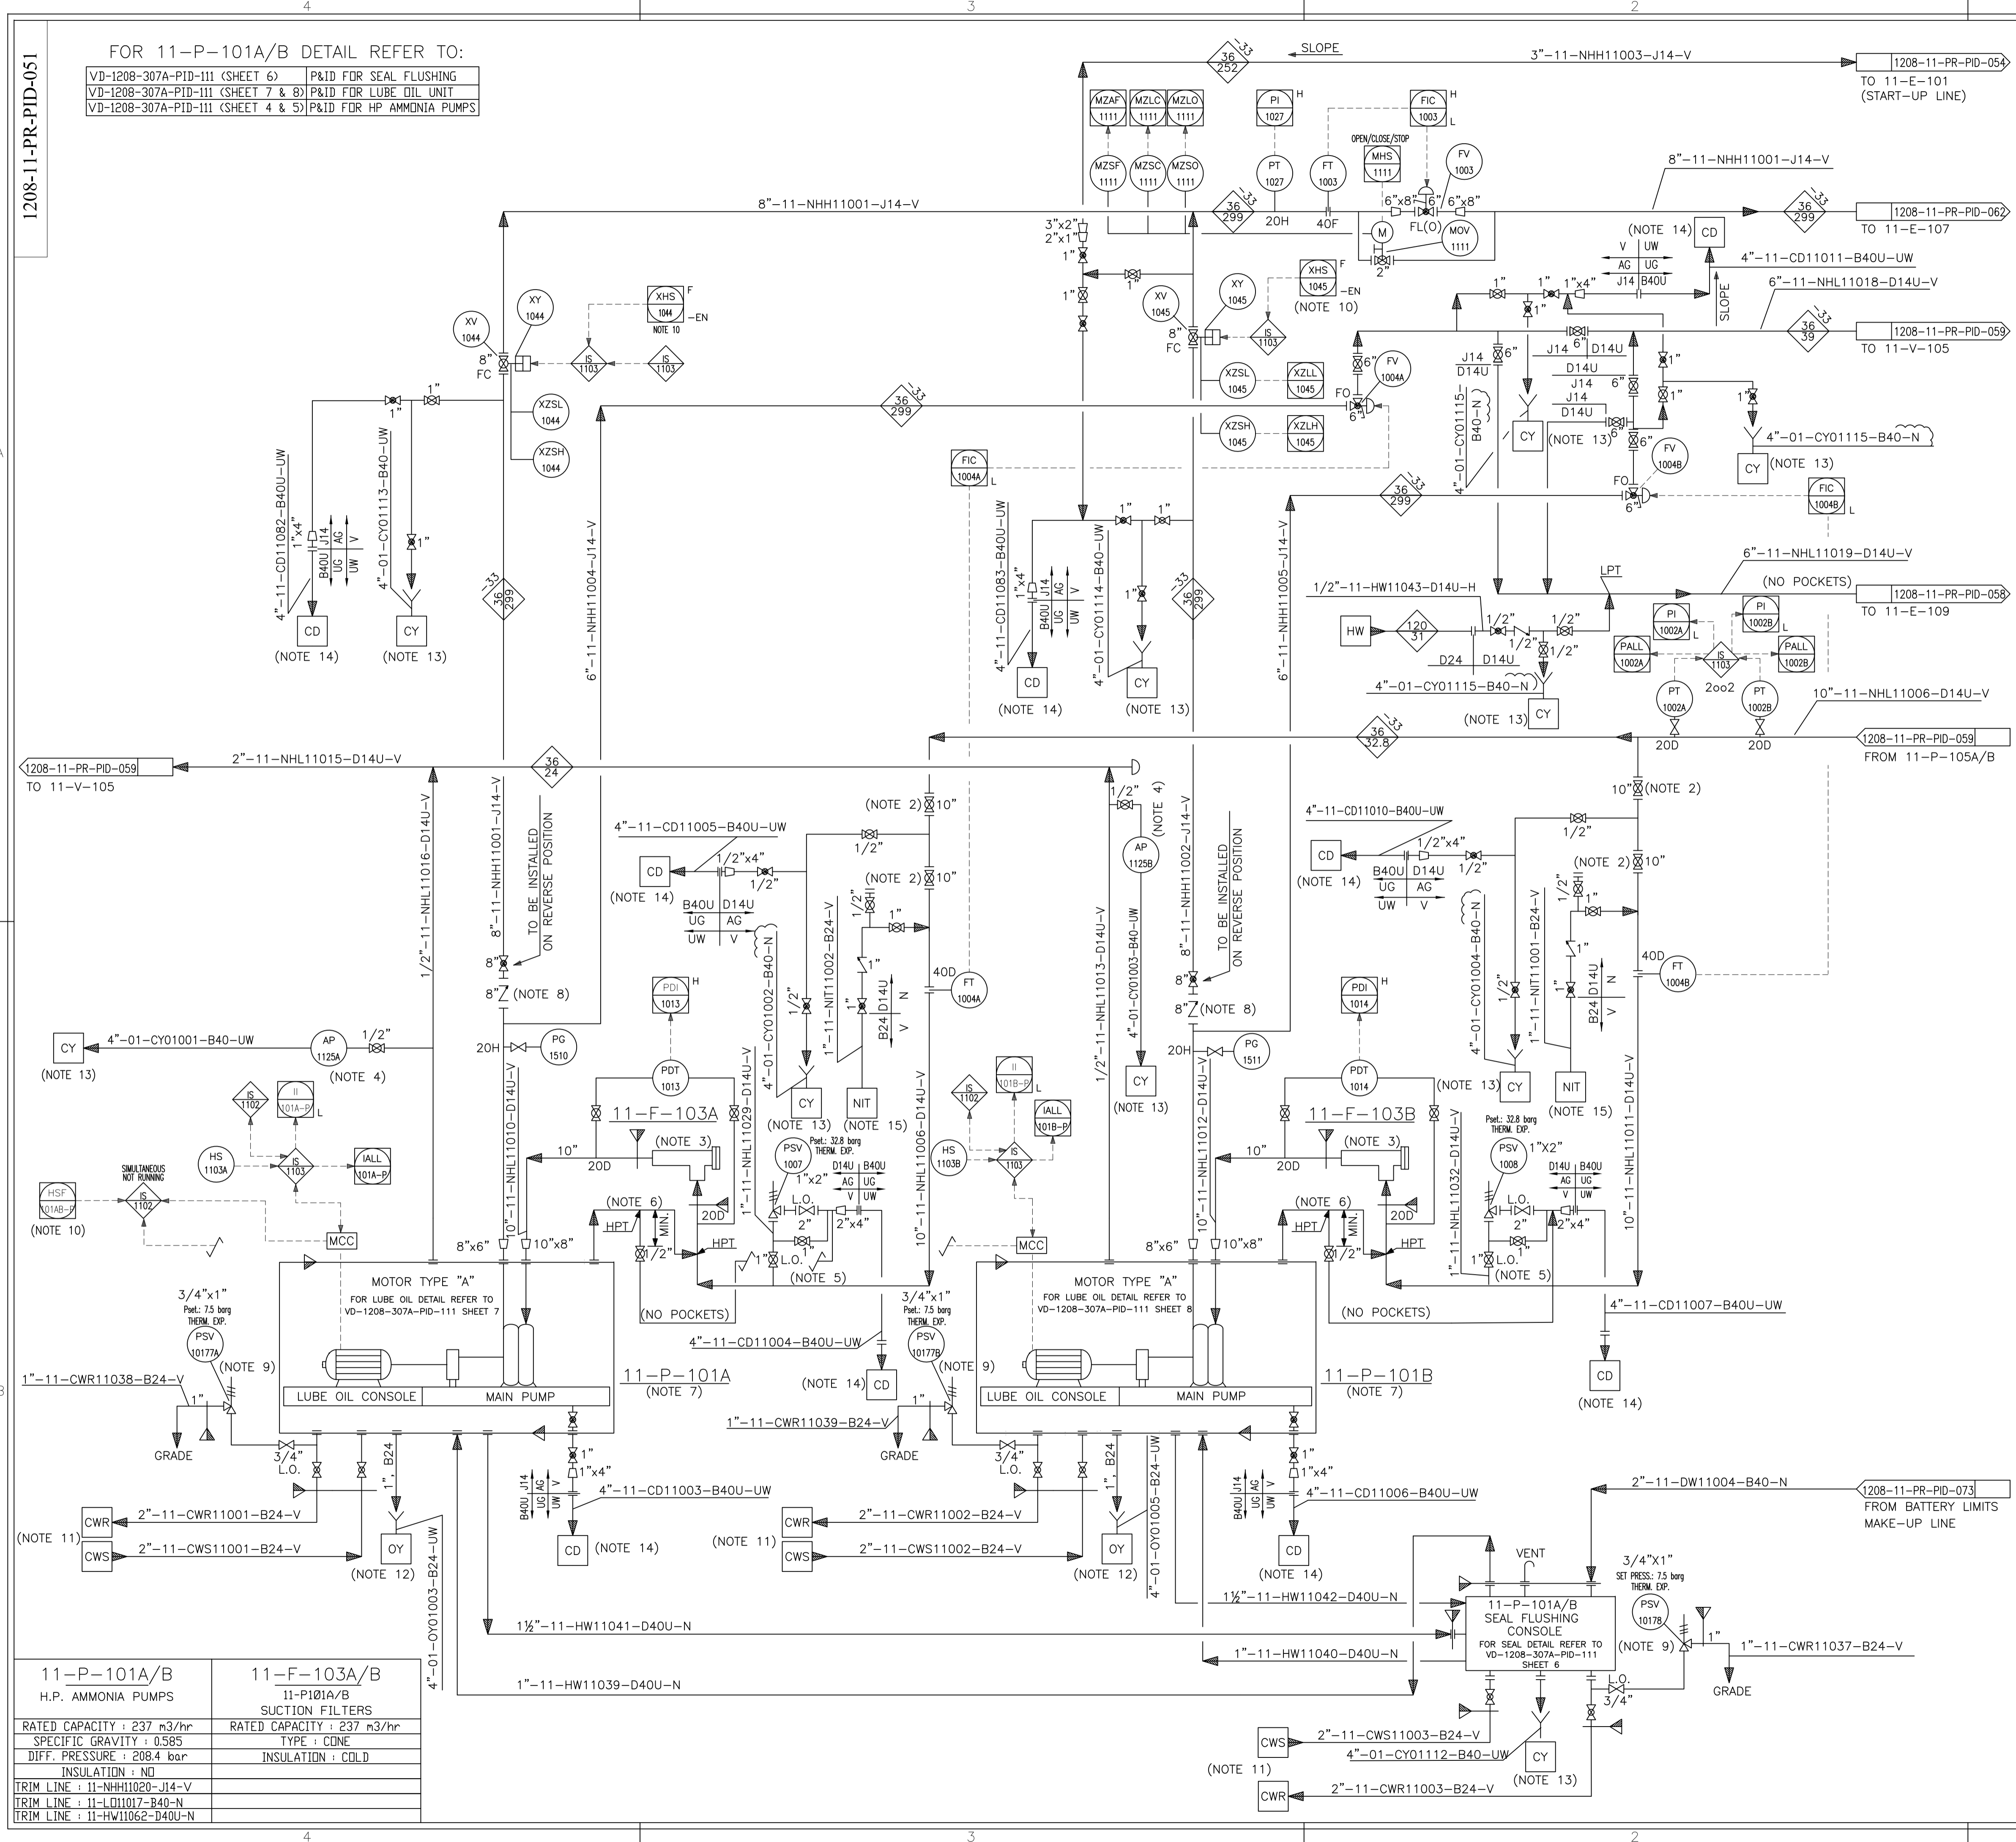

REFERENCE DRAWING	DWG. NO.
SYMBOLS AND IDENTIFICATIONS	1208-01-PR-PID-051-01

- NOTES:**
- 1) FOR THIS SYSTEM -33 °C IS POSSIBLE ONLY AT ATMOSPHERIC PRESSURE DURING DEPRESSURIZATION.
 - 2) FULL BORE BALL VALVE.
 - 3) MESH SIZE TO BE DEFINED BY 11-P-101A/B MFR.
 - 4) FOR SAMPLE CONNECTIONS DETAILS AND PIPING ARRANGEMENT REFER TO P&ID 1208-11-PR-PID-080 & 1208-11-PR-PID-081.
 - 5) STRAIGHT HORIZONTAL LINE.
 - 6) BALANCE LINE TO BE CONFIRMED BY 11-P-101A/B PUMP MFR.
 - 7) ALL PUMPS CONNECTIONS DEFINED AS PER MFR SELECTION.
 - 8) MOCKVELD CHECK VALVE TYPE.
 - 9) PSV-10178 TO BE SUPPLIED BY PUMP VENDOR.
 - 10) FOR FUNCTION OF HSF, PLEASE REFER TO C&E DOCUMENT.

- GENERAL NOTES:**
- 1) FOR SYMBOLS AND OTHER DETAILS PLEASE REFER TO PID, 1208-01-PR-PID-051
 - 2) FOR ALL "CD" LINES THE FLANGES ARE TO BE LOCATED AT MINIMUM DISTANCE FROM GRADE. ALL "CD" LINES SHALL HAVE SLOPE TO ENSURE FREE DRAINING TOWARDS 11-TK-104 TANK.
 - 3) SAFETY AND CONTROL VALVE IN/OUT LINES AND RELATED BY-PASS LINE SIZE TO BE VERIFIED DURING ENGINEERING PHASE, AFTER CONTROL VALVES AND SAFETY VALVES SELECTION.
 - 4) CONTRACTOR
 - 5) WHERE IT'S INDICATED "MIN" OR "MINIMUM DISTANCE" THE LENGTH OF THE INTERESTED PIPE TO BE KEPT AS SHORT AS POSSIBLE (ABOUT ONE HUNDRED MILLIMETERS) IN ORDER TO PREVENT DEAD ZONE.
 - 6) FOR THE DESCRIPTION OF ATTRIBUTES OF HYDRAULIC CONSTRAINTS OF LINES (SELF DRAINING, SLOPE, GRAVITY FLOW, ETC.) REFER TO DOC. "GENERAL REQUIREMENTS FOR PIPING" (ZA-E-06667) WHERE SPECIFIC REQUIREMENTS ARE INDICATED THAT PIPING SHALL FOLLOW. NO EXCEPTIONS ARE ALLOWED.
 - 7) ALL DRIP RINGS MUST BE INSTALLED TO HAVE THE RELEVANT TAPPING IN THE BOTTOM PART (THE LOWEST POINT). NO EXCEPTIONS ARE ALLOWED.
 - 8) ALL CHECK VALVES HAVE TO BE INSTALLED IN VERTICAL POSITION, UNLESS VENDOR DIFFERENT INDICATIONS.
 - 9) MECHANIZATION OF PIPING AND INSTRUMENTATION HAS BEEN PERFORMED ACCORDING WITH LICENSOR'S STANDARDS AS MINIMUM REQUIREMENT AND IT SHALL BE COMPLETED BY ENGINEERING CONTRACTOR.
 - 10) ALL INSTRUMENT IN THIS PAGE HAVE PREFIX NO. OF 11. FOR EXAMPLE 11-FV-102B
 - 11) FOR COOLING WATER SUPPLY/RETURN CONTINUATION REFER TO DWG.: 1208-01-PR-UDD-053.
 - 12) FOR OILY WATER DRAINAGE CONTINUATION REFER TO DWG.: 1208-01-PR-UDD-055.
 - 13) FOR CHEMICAL DRAINAGE CONTINUATION REFER TO DWG.: 1208-01-PR-UDD-056.
 - 14) FOR CLOSE DRAINAGE CONTINUATION REFER TO DWG.: 1208-01-PR-UDD-057.
 - 15) FOR NITROGEN LINES CONNECTION REFER DWG.: 1208-01-PR-UDD-052.




HOLD
 - DELETED
 - DELETED

EQUIPMENT LIST	
11-P-101A/B	
11-F-103A/B	

LICENSOR REF. : P41

DE	EXT	AFC	A
Eng. Phase	Purpose of Distribution (POD)	Purpose of Issue (POI)	Owner's Action

THIS DOCUMENT IS THE PROPERTY OF HFC. IT IS CONFIDENTIAL AND ALL RIGHTS RESERVED. NEITHER THE WHOLE NOR PART OF THIS DOCUMENT MAY BE DISCLOSED TO ANY THIRD PARTY, REPRODUCED, STORED IN ANY RETRIEVAL SYSTEM OR TRANSMITTED IN ANY FORM OR BY ANY MEANS WITHOUT THE PRIOR WRITTEN CONSENT OF HFC.


OWNER:  MC:  EPCC CONTRACTOR: 

PROJECT: HENGAM FERTILIZER PROJECT

TITLE: PIPING AND INSTRUMENTATION DIAGRAM AMMONIA HIGH PRESSURE PUMPS

SCALE: N.T.S	OWNER PROJECT NO.: NA	DWG. NO.:	REV.:	SIZE:
1 OF 1	PIDEC PROJECT NO.: 1208	1208-11-PR-PID-051	04	A1

11-P-101A/B	11-F-103A/B
H.P. AMMONIA PUMPS	11-P101A/B SUCTION FILTERS
RATED CAPACITY : 237 m ³ /hr	RATED CAPACITY : 237 m ³ /hr
SPECIFIC GRAVITY : 0.585	TYPE : CONE
DIFF. PRESSURE : 208.4 bar	INSULATION : COLD
INSULATION : ND	
TRIM LINE : 11-NHH1020-J14-V	
TRIM LINE : 11-L01017-B40-N	
TRIM LINE : 11-HW11062-D40U-N	

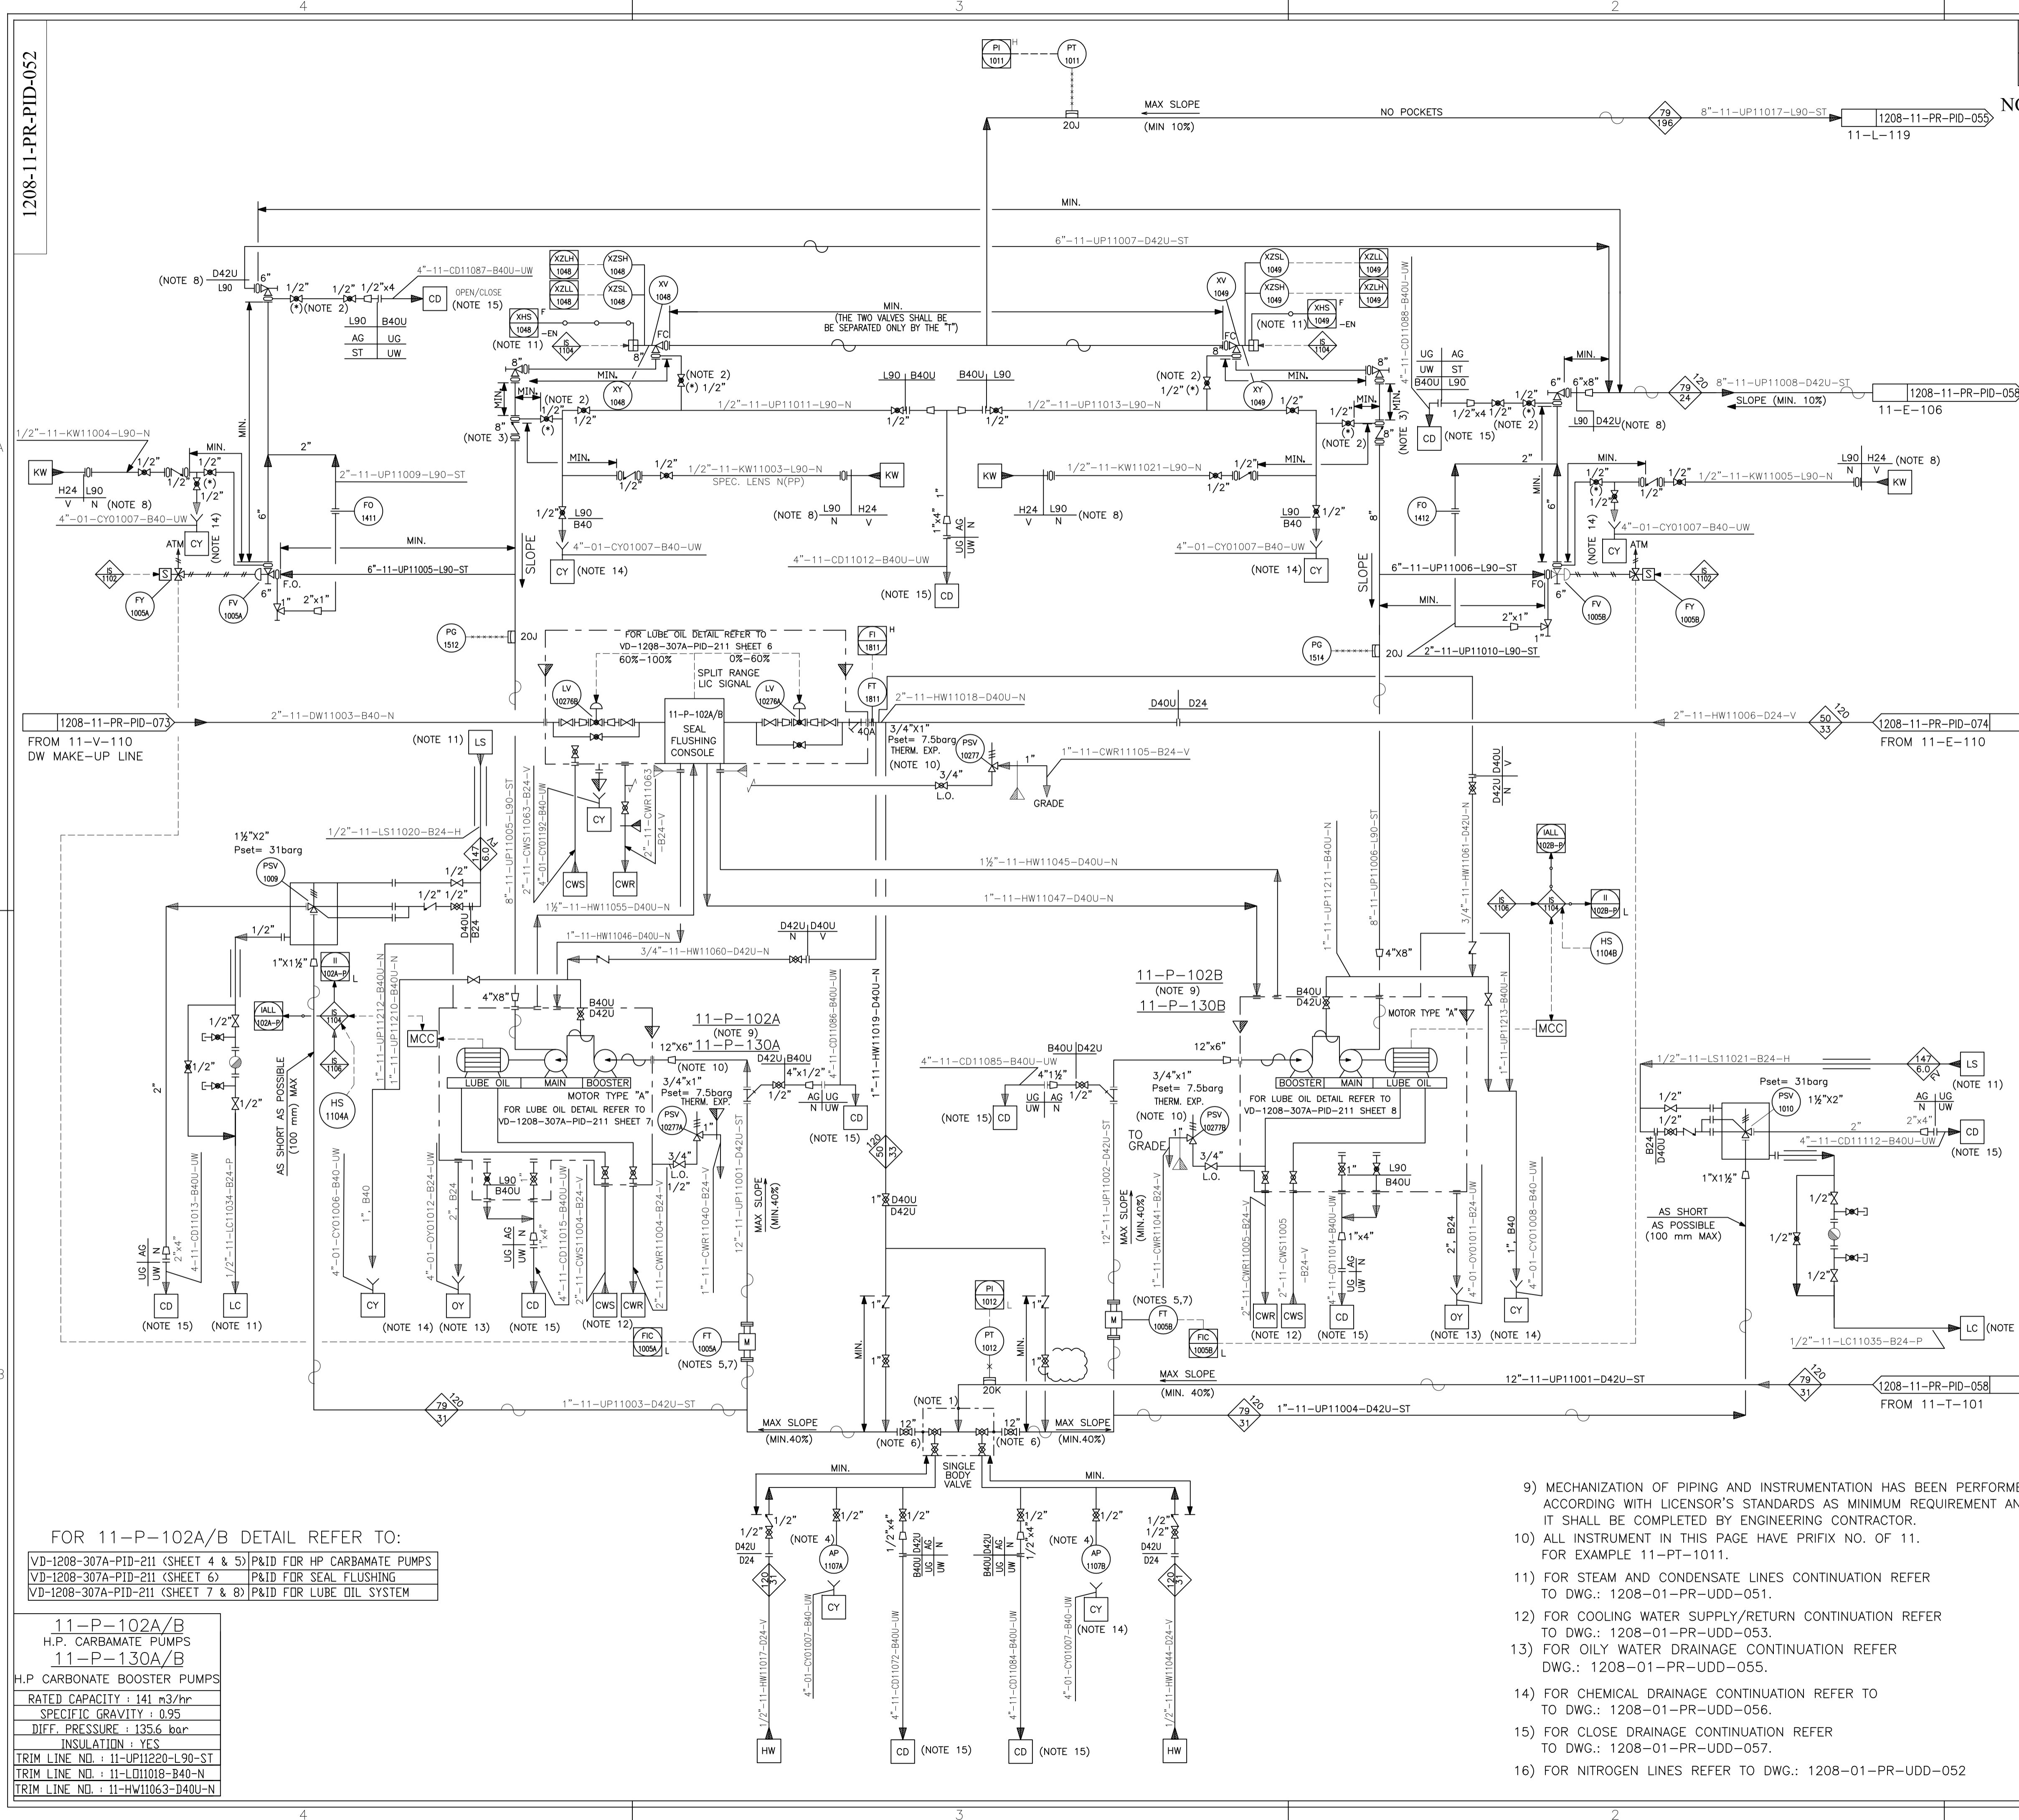

REFERENCE DRAWING	DWG. NO.
SYMBOLS AND IDENTIFICATIONS	1208-01-PR-PID-051-01

- NOTES:**
- OPERATING POSITION OF 12" AT 11-P-102A/B SUCTION:
 - BLOCK VALVES MARKED WITH (*) ARE TO BE INSTALLED AT MINIMUM DISTANCE FROM PROCESS LINE WITH THE PLUG FACING THE PROCESS FLUID.
 - CHECK VALVE TO BE INSTALLED ON VERTICAL POSITION/UNLESS VENDOR DIFFERENT INDICATION.
 - FOR SAMPLE CONNECTION DETAILS AND PIPING ARRANGEMENT, REFER TO P&ID 1208-11-PR-PID-080 AND 1208-11-PR-PID-081.
 - UPSTREAM STRAIGHT RUN FIVE TIMES FLOW METER INLET DIAMETER, DOWN STREAM STRAIGHT RUN TWO TIMES FLOW METER OUTLET DIAMETER.
 - FULL BORE BALL VALVE.
 - STEAM TRACING SHALL BE AVOIDED AROUND THE FLOWMETERS 11-FV-1005A/B.
 - REFER TO DETAIL "A" ON P&ID 1208-01-PR-PID-051.
 - ALL PUMPS CONNECTIONS DEFINED AS PER MFR SELECTION.
 - PSV TO BE SUPPLIED BY PUMP VENDOR.
 - FOR FUNCTION OF HSF, PLEASE REFER TO C&E DOCUMENT.

- GENERAL NOTES:**
- FOR SYMBOLS AND OTHER DETAILS PLEASE REFER TO 1208-01-PR-PID-051.
 - FOR ALL "CD" LINES THE FLANGES ARE TO BE LOCATED AT MINIMUM DISTANCE FROM GRADE. ALL "CD" LINES SHALL HAVE SLOPE TO ENSURE FREE DRAINING TOWARDS 11-TK-104 TANK.
 - SAFETY AND CONTROL VALVE IN/OUT LINES AND RELATED BY-PASS LINE SIZE TO BE VERIFIED DURING ENGINEERING PHASE, AFTER CONTROL VALVES AND SAFETY VALVES SELECTION.
 - MFR CONTRACTOR
 - WHERE IT'S INDICATED "MIN" OR "MINIMUM DISTANCE" THE LENGTH OF THE INTERESTED PIPE TO BE KEPT AS SHORT AS POSSIBLE (ABOUT ONE HUNDRED MILLIMETERS) IN ORDER TO PREVENT DEAD ZONE.
 - FOR THE DESCRIPTION OF ATTRIBUTES OF HYDRAULIC CONSTRAINTS OF LINES (SELF DRAINING, SLOPE, GRAVITY FLOW, ETC.) REFER TO DOC. "GENERAL REQUIREMENTS FOR PIPING" WHERE SPECIFIC REQUIREMENTS ARE INDICATED THAT PIPING SHALL FOLLOW. NO EXCEPTIONS ARE ALLOWED.
 - ALL DRIP TRAPS MUST BE INSTALLED TO HAVE THE RELEVANT TAPPING IN THE BOTTOM PART (THE LOWEST POINT). NO EXCEPTIONS ARE ALLOWED.
 - ALL CHECK VALVES HAVE TO BE INSTALLED IN VERTICAL POSITION, UNLESS VENDOR DIFFERENT INDICATIONS.

HOLD
 - DELETED
 - DELETED

EQUIPMENT LIST

11-P-102A/B
11-P-130A/B

LICENSOR REF. : P42

DE	EXT	AFC	A
Eng. Phase	Purpose of Distribution (POD)	Purpose of Issue (POI)	Owner's Action

THIS DOCUMENT IS THE PROPERTY OF HFC. IT IS CONFIDENTIAL AND ALL RIGHTS RESERVED. NEITHER THE WHOLE NOR PART OF THIS DOCUMENT MAY BE DISCLOSED TO ANY THIRD PARTY, REPRODUCED, STORED IN ANY RETRIEVAL SYSTEM OR TRANSMITTED IN ANY FORM OR BY ANY MEANS WITHOUT THE PRIOR WRITTEN CONSENT OF HFC.

04	26.12.2023	APPROVED FOR CONSTRUCTION	M.Fahrasi	A.Azma	A.Azma	M.Saromi
03	26.08.2023	APPROVED FOR CONSTRUCTION	M.Fahrasi	A.Azma	A.Azma	M.Saromi
02	12.11.2022	APPROVED FOR CONSTRUCTION (WITH HOLD)	M.Fahrasi	M.Yadavpanahi	A.Azma	M.Saromi
01	12.06.2018	APPROVED FOR CONSTRUCTION (WITH HOLD)	M.Yadavpanahi	A.Azma	A.Azma	M.Saromi
00	13.03.2017	ISSUED FOR ENGINEERING	F.Mizaki	A.Habibi	A.Azma	M.Saromi

OWNER:

PROJECT: **HENGAM FERTILIZER PROJECT**

TITLE: **PIPING AND INSTRUMENTATION DIAGRAM**
CARBAMATE HIGH PRESSURE PUMPS

SCALE: 1:1
 OWNER PROJECT NO.: NA
 DWG. NO.: 1208-11-PR-PID-052
 REV. DATE: 04
 SIZE: A1

FOR 11-P-102A/B DETAIL REFER TO:

- VD-1208-307A-PID-211 (SHEET 4 & 5) P&ID FOR HP CARBAMATE PUMPS
- VD-1208-307A-PID-211 (SHEET 6) P&ID FOR SEAL FLUSHING
- VD-1208-307A-PID-211 (SHEET 7 & 8) P&ID FOR LUBE OIL SYSTEM

11-P-102A/B
H.P. CARBAMATE PUMPS
11-P-130A/B
H.P. CARBONATE BOOSTER PUMPS
RATED CAPACITY : 141 m ³ /hr
SPECIFIC GRAVITY : 0.95
DIFF. PRESSURE : 135.6 bar
INSULATION : YES
TRIM LINE NO. : 11-UP11220-L90-ST
TRIM LINE NO. : 11-LD11018-B40-N
TRIM LINE NO. : 11-HW11063-D40U-N

- MECHANIZATION OF PIPING AND INSTRUMENTATION HAS BEEN PERFORMED ACCORDING WITH LICENSOR'S STANDARDS AS MINIMUM REQUIREMENT AND IT SHALL BE COMPLETED BY ENGINEERING CONTRACTOR.
- ALL INSTRUMENT IN THIS PAGE HAVE PREFIX NO. OF 11. FOR EXAMPLE 11-PT-1011.
- FOR STEAM AND CONDENSATE LINES CONTINUATION REFER TO DWG.: 1208-01-PR-UPD-051.
- FOR COOLING WATER SUPPLY/RETURN CONTINUATION REFER TO DWG.: 1208-01-PR-UPD-053.
- FOR OILY WATER DRAINAGE CONTINUATION REFER DWG.: 1208-01-PR-UPD-055.
- FOR CHEMICAL DRAINAGE CONTINUATION REFER TO TO DWG.: 1208-01-PR-UPD-056.
- FOR CLOSE DRAINAGE CONTINUATION REFER TO DWG.: 1208-01-PR-UPD-057.
- FOR NITROGEN LINES REFER TO DWG.: 1208-01-PR-UPD-052

- NOTES:**
- BLOCK VALVES MARKED WITH (*) ARE TO BE INSTALLED AT MINIMUM DISTANCE FROM PROCESS LINE WITH THE PLUG FACING THE PROCESS FLUID
 - TWO PHASE FLOW-REINFORCED SUPPORT.
 - FOR SAMPLE CONNECTIONS DETAILS AND PIPING ARRANGEMENTS REFER TO P&ID 1208-11-PR-PID-080 AND 1208-11-PR-PID-081.
 - CHECK VALVE TO BE INSTALLED ON VERTICAL POSITION.
 - HV-1006 IS A DRILLED VALVE LOCATED NOT LESS THAN 2000mm FROM 11-E-101 INLET NOZZLE.
 - SAFETY VALVE & VENT VALVE ON CO2 LINE TO BE INSTALLED AS NEAR AS POSSIBLE TO 11-C-101 DISCHARGE (COMPRESSOR HOUSE BATTERY LIMITS).
 - DELETED.
 - PV-1017 LINE SHALL BE DOUBLE STEAM TRACED UPSTREAM AND DOWNSTREAM.
 - REFER TO DETAIL "A" ON P&ID 1208-01-PR-PID-051.
 - DELETED.
 - FOR FUNCTION OF HSF, PLEASE REFER TO C&E DOCUMENT.

- GENERAL NOTES:**
- FOR SYMBOLS AND OTHER DETAILS PLEASE REFER TO PID. 1208-01-PR-PID-051.
 - FOR ALL "CD" LINES THE FLANGES ARE TO BE LOCATED AT MINIMUM DISTANCE FROM GRADE. ALL "CD" LINES SHALL HAVE SLOPE TO ENSURE FREE DRAINING TOWARDS 11-TK-104 TANK.
 - SAFETY AND CONTROL VALVE IN/OUT LINES AND RELATED BY-PASS LINE SIZE TO BE VERIFIED DURING ENGINEERING PHASE, AFTER CONTROL VALVES AND SAFETY VALVES SELECTION.
 - MFR CONTRACTOR
 - WHERE IT'S INDICATED "MIN" OR "MINIMUM DISTANCE" THE LENGTH OF THE INTERESTED PIPE TO BE KEPT AS SHORT AS POSSIBLE (ABOUT ONE HUNDRED MILLIMETERS) IN ORDER TO PREVENT DEAD ZONE.
 - FOR THE DESCRIPTION OF ATTRIBUTES OF HYDRAULIC CONSTRAINTS OF LINES (SELF DRAINING, SLOPE, GRAVITY FLOW, ETC.) REFER TO DOC. "GENERAL REQUIREMENTS FOR PIPING" WHERE SPECIFIC REQUIREMENTS ARE INDICATED THAT PIPING SHALL FOLLOW. NO EXCEPTIONS ARE ALLOWED.
 - ALL DRIP RINGS MUST BE INSTALLED TO HAVE THE RELEVANT TAPPING IN THE BOTTOM PART (THE LOWEST POINT). NO EXCEPTIONS ARE ALLOWED.
 - ALL CHECK VALVES HAVE TO BE INSTALLED IN VERTICAL POSITION, UNLESS VENDOR DIFFERENT INDICATIONS.
 - MECHANIZATION OF PIPING AND INSTRUMENTATION HAS BEEN PERFORMED ACCORDING WITH LICENSOR'S STANDARDS AS MINIMUM REQUIREMENT AND IT SHALL BE COMPLETED BY ENGINEERING CONTRACTOR.
 - ALL INSTRUMENT IN THIS PAGE HAVE PREFIX NO. OF 11. FOR EXAMPLE 11-FT-1006.
 - FOR STEAM AND CONDENSATE LINES CONTINUATION REFER TO DWG.: 1208-01-PR-UDD-051.
 - FOR CHEMICAL DRAINAGE CONTINUATION REFER TO DWG.: 1208-01-PR-UDD-056.
 - FOR CLOSE DRAINAGE CONTINUATION REFER TO DWG.: 1208-01-PR-UDD-057.

HOLD
- DELETED

EQUIPMENT LIST	
11-L-111	11-R-101

LICENSOR REF. : P43


DE	EXT	AFC	A
Eng. Phase	Purpose of Distribution (POD)	Purpose of Issue (POI)	Owner's Action
04	26.12.2023	APPROVED FOR CONSTRUCTION	M.Fakhrzad A.Arma A.Arma M.Saremi
03	28.08.2023	APPROVED FOR CONSTRUCTION	M.Fakhrzad A.Arma A.Arma M.Saremi
02	05.11.2022	APPROVED FOR CONSTRUCTION (WITH HOLD)	M.Fakhrzad M.Yandapanahli A.Arma M.Saremi
01	12.06.2018	APPROVED FOR CONSTRUCTION (WITH HOLD)	M.Yandapanahli A.Arma A.Arma M.Saremi
00	13.03.2017	ISSUED FOR ENGINEERING	F.Mizale A.Habibi A.Arma M.Saremi

REV.	DATE	DESCRIPTION	PREPARED BY	CHECKED BY	APPROVED BY	PROJECT
OWNER:	MC:	EPCC CONTRACTOR:				


PROJECT: HENGAM FERTILIZER PROJECT

TITLE: PIPING AND INSTRUMENTATION DIAGRAM
HIGH PRESSURE SECTION 1 of 4

SCALE: NTS	OWNER PROJECT NO.: NA	DWG. NO.:	REV. SIZE:
SHT.: 1 OF 1	PIDEC PROJECT NO.: 1208	1208-11-PR-PID-053	04 A1

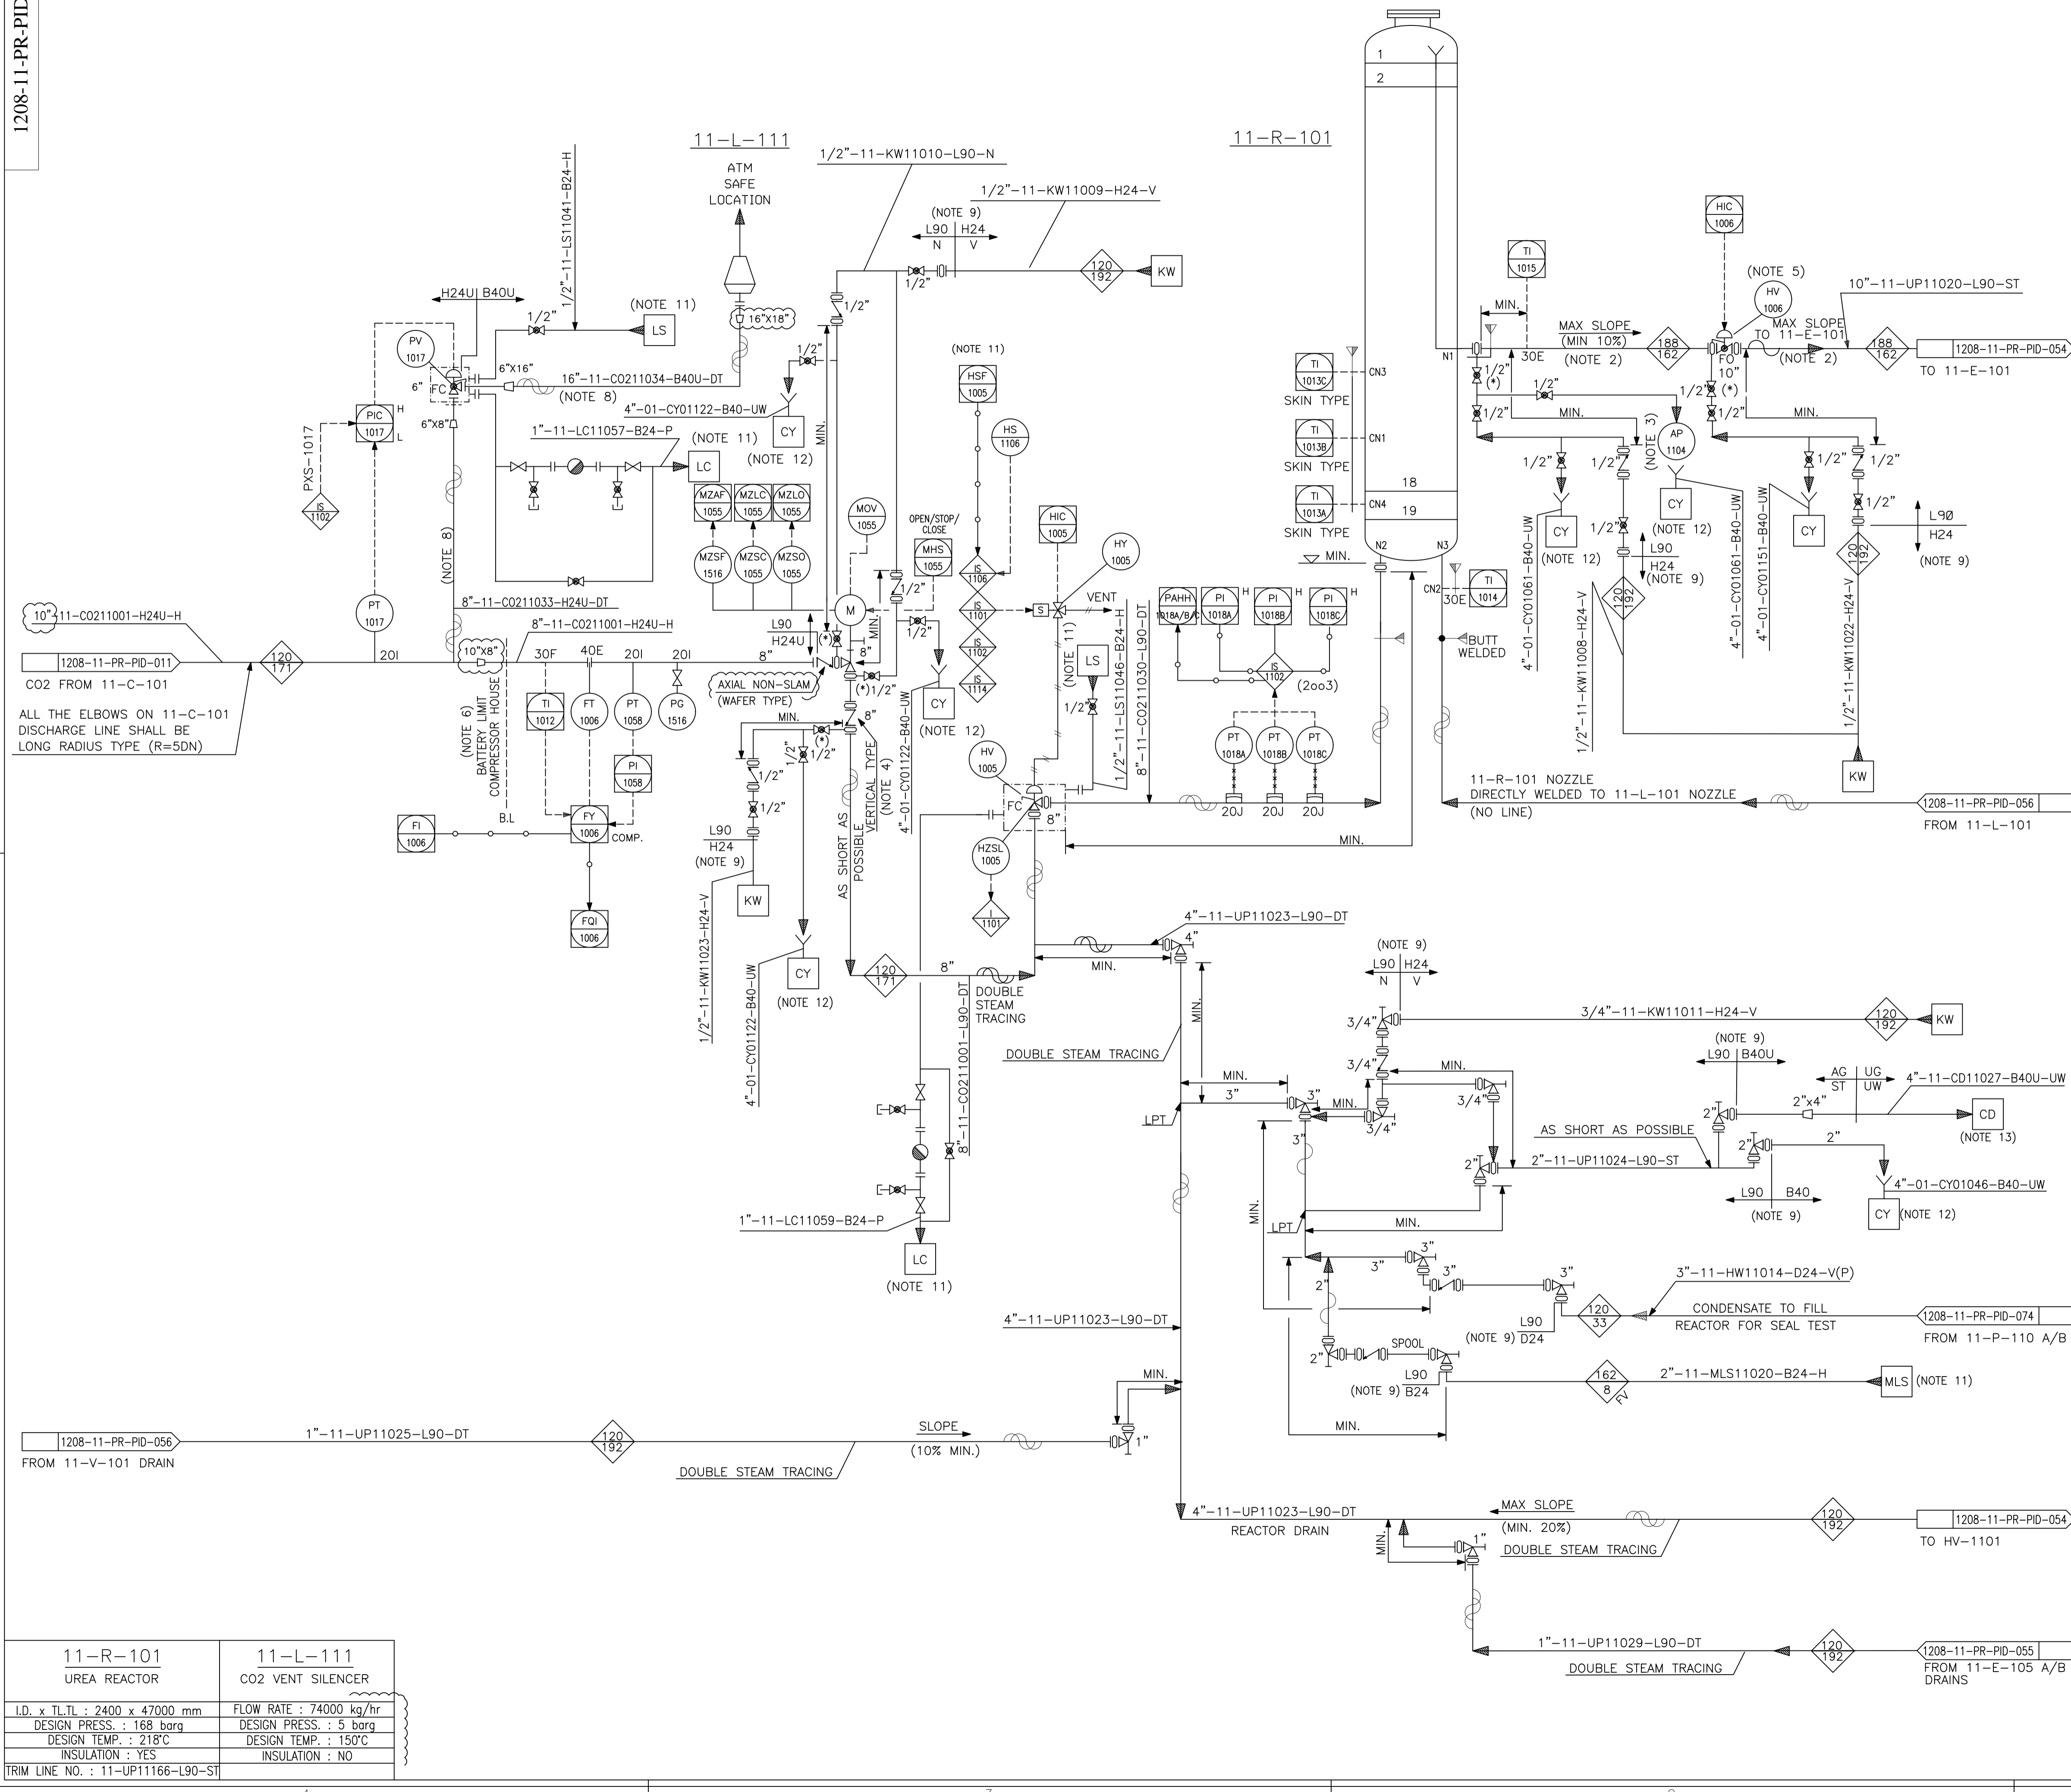

11-R-101	11-L-111
UREA REACTOR	CO2 VENT SILENCER
I.D. x T.L.TL : 2400 x 47000 mm	FLOW RATE : 74000 kg/hr
DESIGN PRESS. : 168 barg	DESIGN PRESS. : 5 barg
DESIGN TEMP. : 218°C	DESIGN TEMP. : 150°C
INSULATION : YES	INSULATION : NO
TRIM LINE NO. : 11-UP11166-L90-ST	

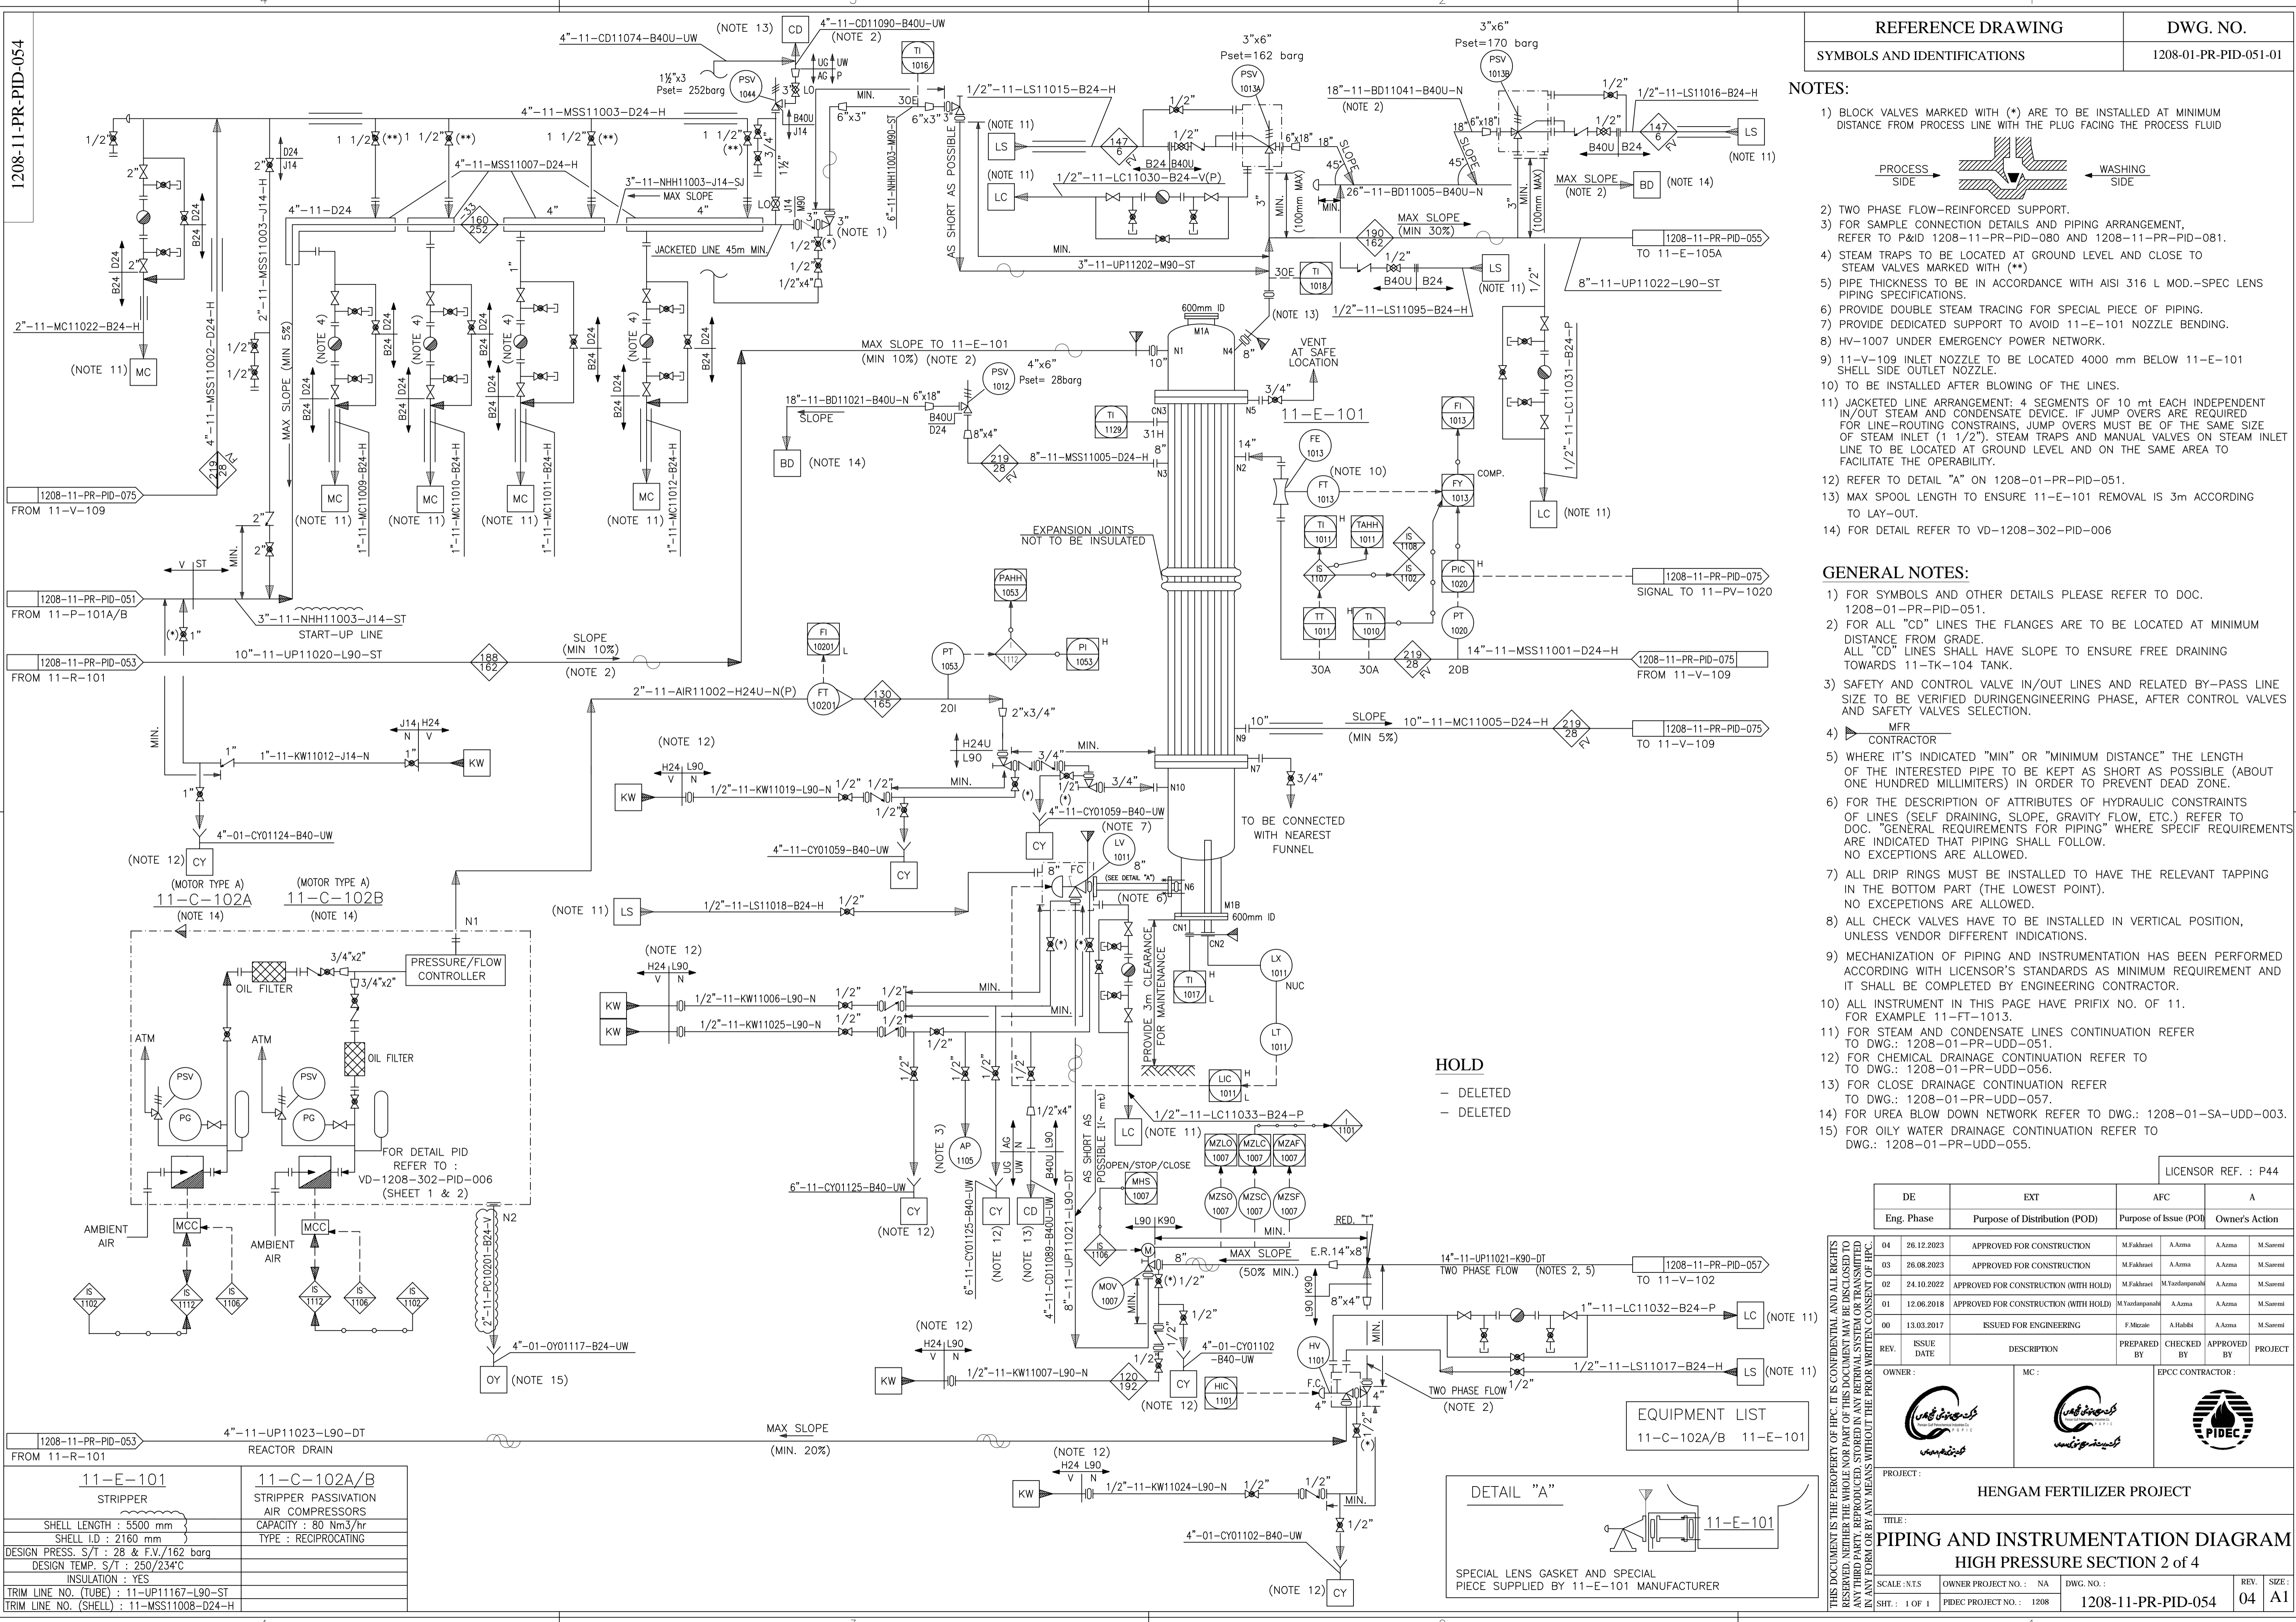

REFERENCE DRAWING	DWG. NO.
SYMBOLS AND IDENTIFICATIONS	1208-01-PR-PID-051-01


- NOTES:**
- BLOCK VALVES MARKED WITH (*) ARE TO BE INSTALLED AT MINIMUM DISTANCE FROM PROCESS LINE WITH THE PLUG FACING THE PROCESS FLUID
 - TWO PHASE FLOW-REINFORCED SUPPORT.
 - FOR SAMPLE CONNECTION DETAILS AND PIPING ARRANGEMENT, REFER TO P&ID 1208-11-PR-PID-080 AND 1208-11-PR-PID-081.
 - STEAM TRAPS TO BE LOCATED AT GROUND LEVEL AND CLOSE TO STEAM VALVES MARKED WITH (**)
 - PIPE THICKNESS TO BE IN ACCORDANCE WITH AISI 316 L MOD.-SPEC LENS PIPING SPECIFICATIONS.
 - PROVIDE DOUBLE STEAM TRACING FOR SPECIAL PIECE OF PIPING.
 - PROVIDE DEDICATED SUPPORT TO AVOID 11-E-101 NOZZLE BENDING.
 - HV-1007 UNDER EMERGENCY POWER NETWORK.
 - 11-V-109 INLET NOZZLE TO BE LOCATED 4000 mm BELOW 11-E-101 SHELL SIDE OUTLET NOZZLE.
 - TO BE INSTALLED AFTER BLOWING OF THE LINES.
 - JACKETED LINE ARRANGEMENT: 4 SEGMENTS OF 10 mt EACH INDEPENDENT IN/OUT STEAM AND CONDENSATE DEVICE. IF JUMP OVERS ARE REQUIRED FOR LINE-ROUTING CONSTRAINTS, JUMP OVERS MUST BE OF THE SAME SIZE OF STEAM INLET (1 1/2"). STEAM TRAPS AND MANUAL VALVES ON STEAM INLET LINE TO BE LOCATED AT GROUND LEVEL AND ON THE SAME AREA TO FACILITATE THE OPERABILITY.
 - REFER TO DETAIL "A" ON 1208-01-PR-PID-051.
 - MAX SPOOL LENGTH TO ENSURE 11-E-101 REMOVAL IS 3m ACCORDING TO LAY-OUT.
 - FOR DETAIL REFER TO VD-1208-302-PID-006

- GENERAL NOTES:**
- FOR SYMBOLS AND OTHER DETAILS PLEASE REFER TO DOC. 1208-01-PR-PID-051.
 - FOR ALL "CD" LINES THE FLANGES ARE TO BE LOCATED AT MINIMUM DISTANCE FROM GRADE. ALL "CD" LINES SHALL HAVE SLOPE TO ENSURE FREE DRAINING TOWARDS 11-TK-104 TANK.
 - SAFETY AND CONTROL VALVE IN/OUT LINES AND RELATED BY-PASS LINE SIZE TO BE VERIFIED DURING ENGINEERING PHASE, AFTER CONTROL VALVES AND SAFETY VALVES SELECTION.
 - MFR CONTRACTOR
 - WHERE IT'S INDICATED "MIN" OR "MINIMUM DISTANCE" THE LENGTH OF THE INTERESTED PIPE TO BE KEPT AS SHORT AS POSSIBLE (ABOUT ONE HUNDRED MILLIMETERS) IN ORDER TO PREVENT DEAD ZONE.
 - FOR THE DESCRIPTION OF ATTRIBUTES OF HYDRAULIC CONSTRAINTS OF LINES (SELF DRAINING, SLOPE, GRAVITY FLOW, ETC.) REFER TO DOC. "GENERAL REQUIREMENTS FOR PIPING" WHERE SPECIFIC REQUIREMENTS ARE INDICATED THAT PIPING SHALL FOLLOW. NO EXCEPTIONS ARE ALLOWED.
 - ALL DRIP RINGS MUST BE INSTALLED TO HAVE THE RELEVANT TAPPING IN THE BOTTOM PART (THE LOWEST POINT). NO EXCEPTIONS ARE ALLOWED.
 - ALL CHECK VALVES HAVE TO BE INSTALLED IN VERTICAL POSITION, UNLESS VENDOR DIFFERENT INDICATIONS.
 - MECHANIZATION OF PIPING AND INSTRUMENTATION HAS BEEN PERFORMED ACCORDING WITH LICENSOR'S STANDARDS AS MINIMUM REQUIREMENT AND IT SHALL BE COMPLETED BY ENGINEERING CONTRACTOR.
 - ALL INSTRUMENT IN THIS PAGE HAVE PREFIX NO. OF 11. FOR EXAMPLE 11-FT-1013.
 - FOR STEAM AND CONDENSATE LINES CONTINUATION REFER TO DWG.: 1208-01-PR-UDD-051.
 - FOR CHEMICAL DRAINAGE CONTINUATION REFER TO DWG.: 1208-01-PR-UDD-056.
 - FOR CLOSE DRAINAGE CONTINUATION REFER TO DWG.: 1208-01-PR-UDD-057.
 - FOR UREA BLOW DOWN NETWORK REFER TO DWG.: 1208-01-SA-UDD-003.
 - FOR OILY WATER DRAINAGE CONTINUATION REFER TO DWG.: 1208-01-PR-UDD-055.

HOLD
 - DELETED
 - DELETED

EQUIPMENT LIST

11-C-102A/B	11-E-101
-------------	----------

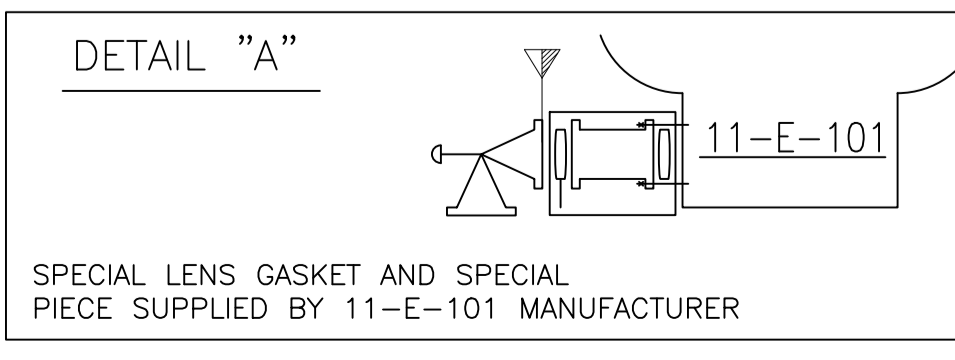

11-E-101 STRIPPER SHELL LENGTH : 5500 mm SHELL I.D : 2160 mm DESIGN PRESS. S/T : 28 & F.V./162 barg DESIGN TEMP. S/T : 250/234°C INSULATION : YES TRIM LINE NO. (TUBE) : 11-UP11167-L90-ST TRIM LINE NO. (SHELL) : 11-MSS11008-D24-H	11-C-102A/B STRIPPER PASSIVATION AIR COMPRESSORS CAPACITY : 80 Nm3/hr TYPE : RECIPROCATING
---	---

LICENSOR REF. : P44

DE	EXT	AFC	A
Eng. Phase	Purpose of Distribution (POD)	Purpose of Issue (POI)	Owner's Action
04	26.12.2023	APPROVED FOR CONSTRUCTION	M.Fahraei, A.Arma, A.Azma, M.Sareni
03	28.08.2023	APPROVED FOR CONSTRUCTION	M.Fahraei, A.Arma, A.Azma, M.Sareni
02	24.10.2022	APPROVED FOR CONSTRUCTION (WITH HOLD)	M.Fahraei, M.Yazdpanahi, A.Arma, M.Sareni
01	12.06.2018	APPROVED FOR CONSTRUCTION (WITH HOLD)	M.Yazdpanahi, A.Arma, A.Azma, M.Sareni
00	13.03.2017	ISSUED FOR ENGINEERING	F.Mizale, A.Habibi, A.Arma, M.Sareni

REV.	DATE	DESCRIPTION	PREPARED BY	CHECKED BY	APPROVED BY	PROJECT
OWNER:	MC:	EPCC CONTRACTOR:				

PROJECT: HENGAM FERTILIZER PROJECT

TITLE: PIPING AND INSTRUMENTATION DIAGRAM HIGH PRESSURE SECTION 2 of 4

SCALE: NTS	OWNER PROJECT NO.: NA	DWG. NO.:	REV.:
SHT.: 1 OF 1	PIDEC PROJECT NO.: 1208	1208-11-PR-PID-054	04 A1

- NOTES:**
- BLOCK VALVES MARKED WITH (*) ARE TO BE INSTALLED WITH THE PLUG FACING THE PROCESS FLUID.
 - TWO-PHASE FLOW REINFORCED SUPPORTS.
 - MINIMIZE PIPE LENGTH BETWEEN HV-1059 AND MIXER 11-L-119, BUT ENSURING SPACE REQUESTED FOR 11-L-119 REMOVAL FOR SPRAYER INSPECTION.
 - CHECK VALVES TO BE INSTALLED ON VERTICAL POSITION
 - LV-1013A AND B AND LV-1113A AND B SHALL BE OPERATED SEPARATELY WHEN THE RELEVANT CONTROLLER IS IN MANUAL MODE.
 - FV-1041 SHALL BE INSTALLED IN "FLOW TO OPEN" DIRECTION; ADEQUATE SUPPORTATION MUST BE PROVIDED AT SITE.
 - FOR SAMPLE CONNECTION DETAILS AND PIPING ARRANGEMENT, REFER TO P&ID 1208-11-PR-PID-080 AND 1208-11-PR-PID-081
 - REFER TO DETAIL "A" ON P&ID 1208-01-PR-PID-051
 - PSV-1015A/B AND PSV-1016A/B HAVE TO BE LOCATED ON MAIN PIPE RACK WITH AN ELEVATION TO ENSURE PSV'S OUTLET LINES SLOPE TOWARDS BLOWDOWN MAIN HEADER. PSV'S DISCHARGE OUTLET LINES HAVE TO BE DEDICATED FOR EACH RELIEF VALVE AND SINGLE/SEPARATED LINE UP TO BD MAIN HEADER.
 - SPOOL PIECE TO BE AS SHORT AS POSSIBLE AND DOUBLE STEAM TRACED.
 - 11-LV-1013A/B OPERATE IN SPLIT RANGE AS SHOWN:
 - 11-LV-1113A/B OPERATE IN SPLIT RANGE AS SHOWN:
 - 11-LV-1113B SHALL BE AS CLOSED AS POSSIBLE TO 11-V-110 "N7" NOZZLE.
 - 11-LV-1013B SHALL BE AS CLOSED AS POSSIBLE TO 11-E-105B "N4" NOZZLE.
 - FOR FUNCTION OF HSF, PLEASE REFER TO C&E DOCUMENT.

- GENERAL NOTES:**
- FOR SYMBOLS AND OTHER DETAILS PLEASE REFER TO 1208-01-PR-PID-051
 - FOR ALL "CD" LINES THE FLANGES ARE TO BE LOCATED AT MINIMUM DISTANCE FROM GRADE. ALL "CD" LINES SHALL HAVE SLOPE TO ENSURE FREE DRAINING TOWARDS 11-TK-104 TANK.
 - SAFETY AND CONTROL VALVE IN/OUT LINES AND RELATED BY-PASS LINE SIZE TO BE VERIFIED DURING ENGINEERING PHASE, AFTER CONTROL VALVES AND SAFETY VALVES SELECTION.
 - MFR CONTRACTOR
 - WHERE IT'S INDICATED "MIN" OR "MINIMUM DISTANCE" THE LENGTH OF THE INTERESTED PIPE TO BE KEPT AS SHORT AS POSSIBLE (ABOUT ONE HUNDRED MILLIMETERS) IN ORDER TO PREVENT DEAD ZONE.
 - FOR THE DESCRIPTION OF ATTRIBUTES OF HYDRAULIC CONSTRAINTS OF LINES (SELF DRAINING, SLOPE, GRAVITY FLOW, ETC.) REFER TO DOC. "GENERAL REQUIREMENTS FOR PIPING" WHERE SPECIFIC REQUIREMENTS ARE INDICATED THAT PIPING SHALL FOLLOW. NO EXCEPTIONS ARE ALLOWED.

HOLD

DELETED
DELETED

EQUIPMENT LIST	
11-E-105A/B	
11-L-119	

LICENSOR REF. : P45

DE	EXT	AFC	A
Eng. Phase	Purpose of Distribution (POD)	Purpose of Issue (POI)	Owner's Action

REV.	DATE	DESCRIPTION	PREPARED BY	CHECKED BY	APPROVED BY	PROJECT
04	26.12.2023	APPROVED FOR CONSTRUCTION	M.Fakhrzai	A.Arma	A.Arma	M.Sareni
03	26.08.2023	APPROVED FOR CONSTRUCTION	M.Fakhrzai	A.Arma	A.Arma	M.Sareni
02	05.11.2022	APPROVED FOR CONSTRUCTION (WITH HOLD)	M.Fakhrzai	M.Yandapanahli	A.Arma	M.Sareni
01	12.06.2018	APPROVED FOR CONSTRUCTION (WITH HOLD)	M.Yandapanahli	A.Arma	A.Arma	M.Sareni
00	13.03.2017	ISSUED FOR ENGINEERING	F.Mizale	A.Habibi	A.Arma	M.Sareni

OWNER:


MC:

EPCC CONTRACTOR:

PROJECT: HENGAM FERTILIZER PROJECT

TITLE: PIPING AND INSTRUMENTATION DIAGRAM
HIGH PRESSURE SECTION 3 of 4

SCALE: NTS	OWNER PROJECT NO.: NA	DWG. NO.:	REV. SIZE:
SHT. : 1 OF 1	PIDEC PROJECT NO. : 1208	1208-11-PR-PID-055	04 A1

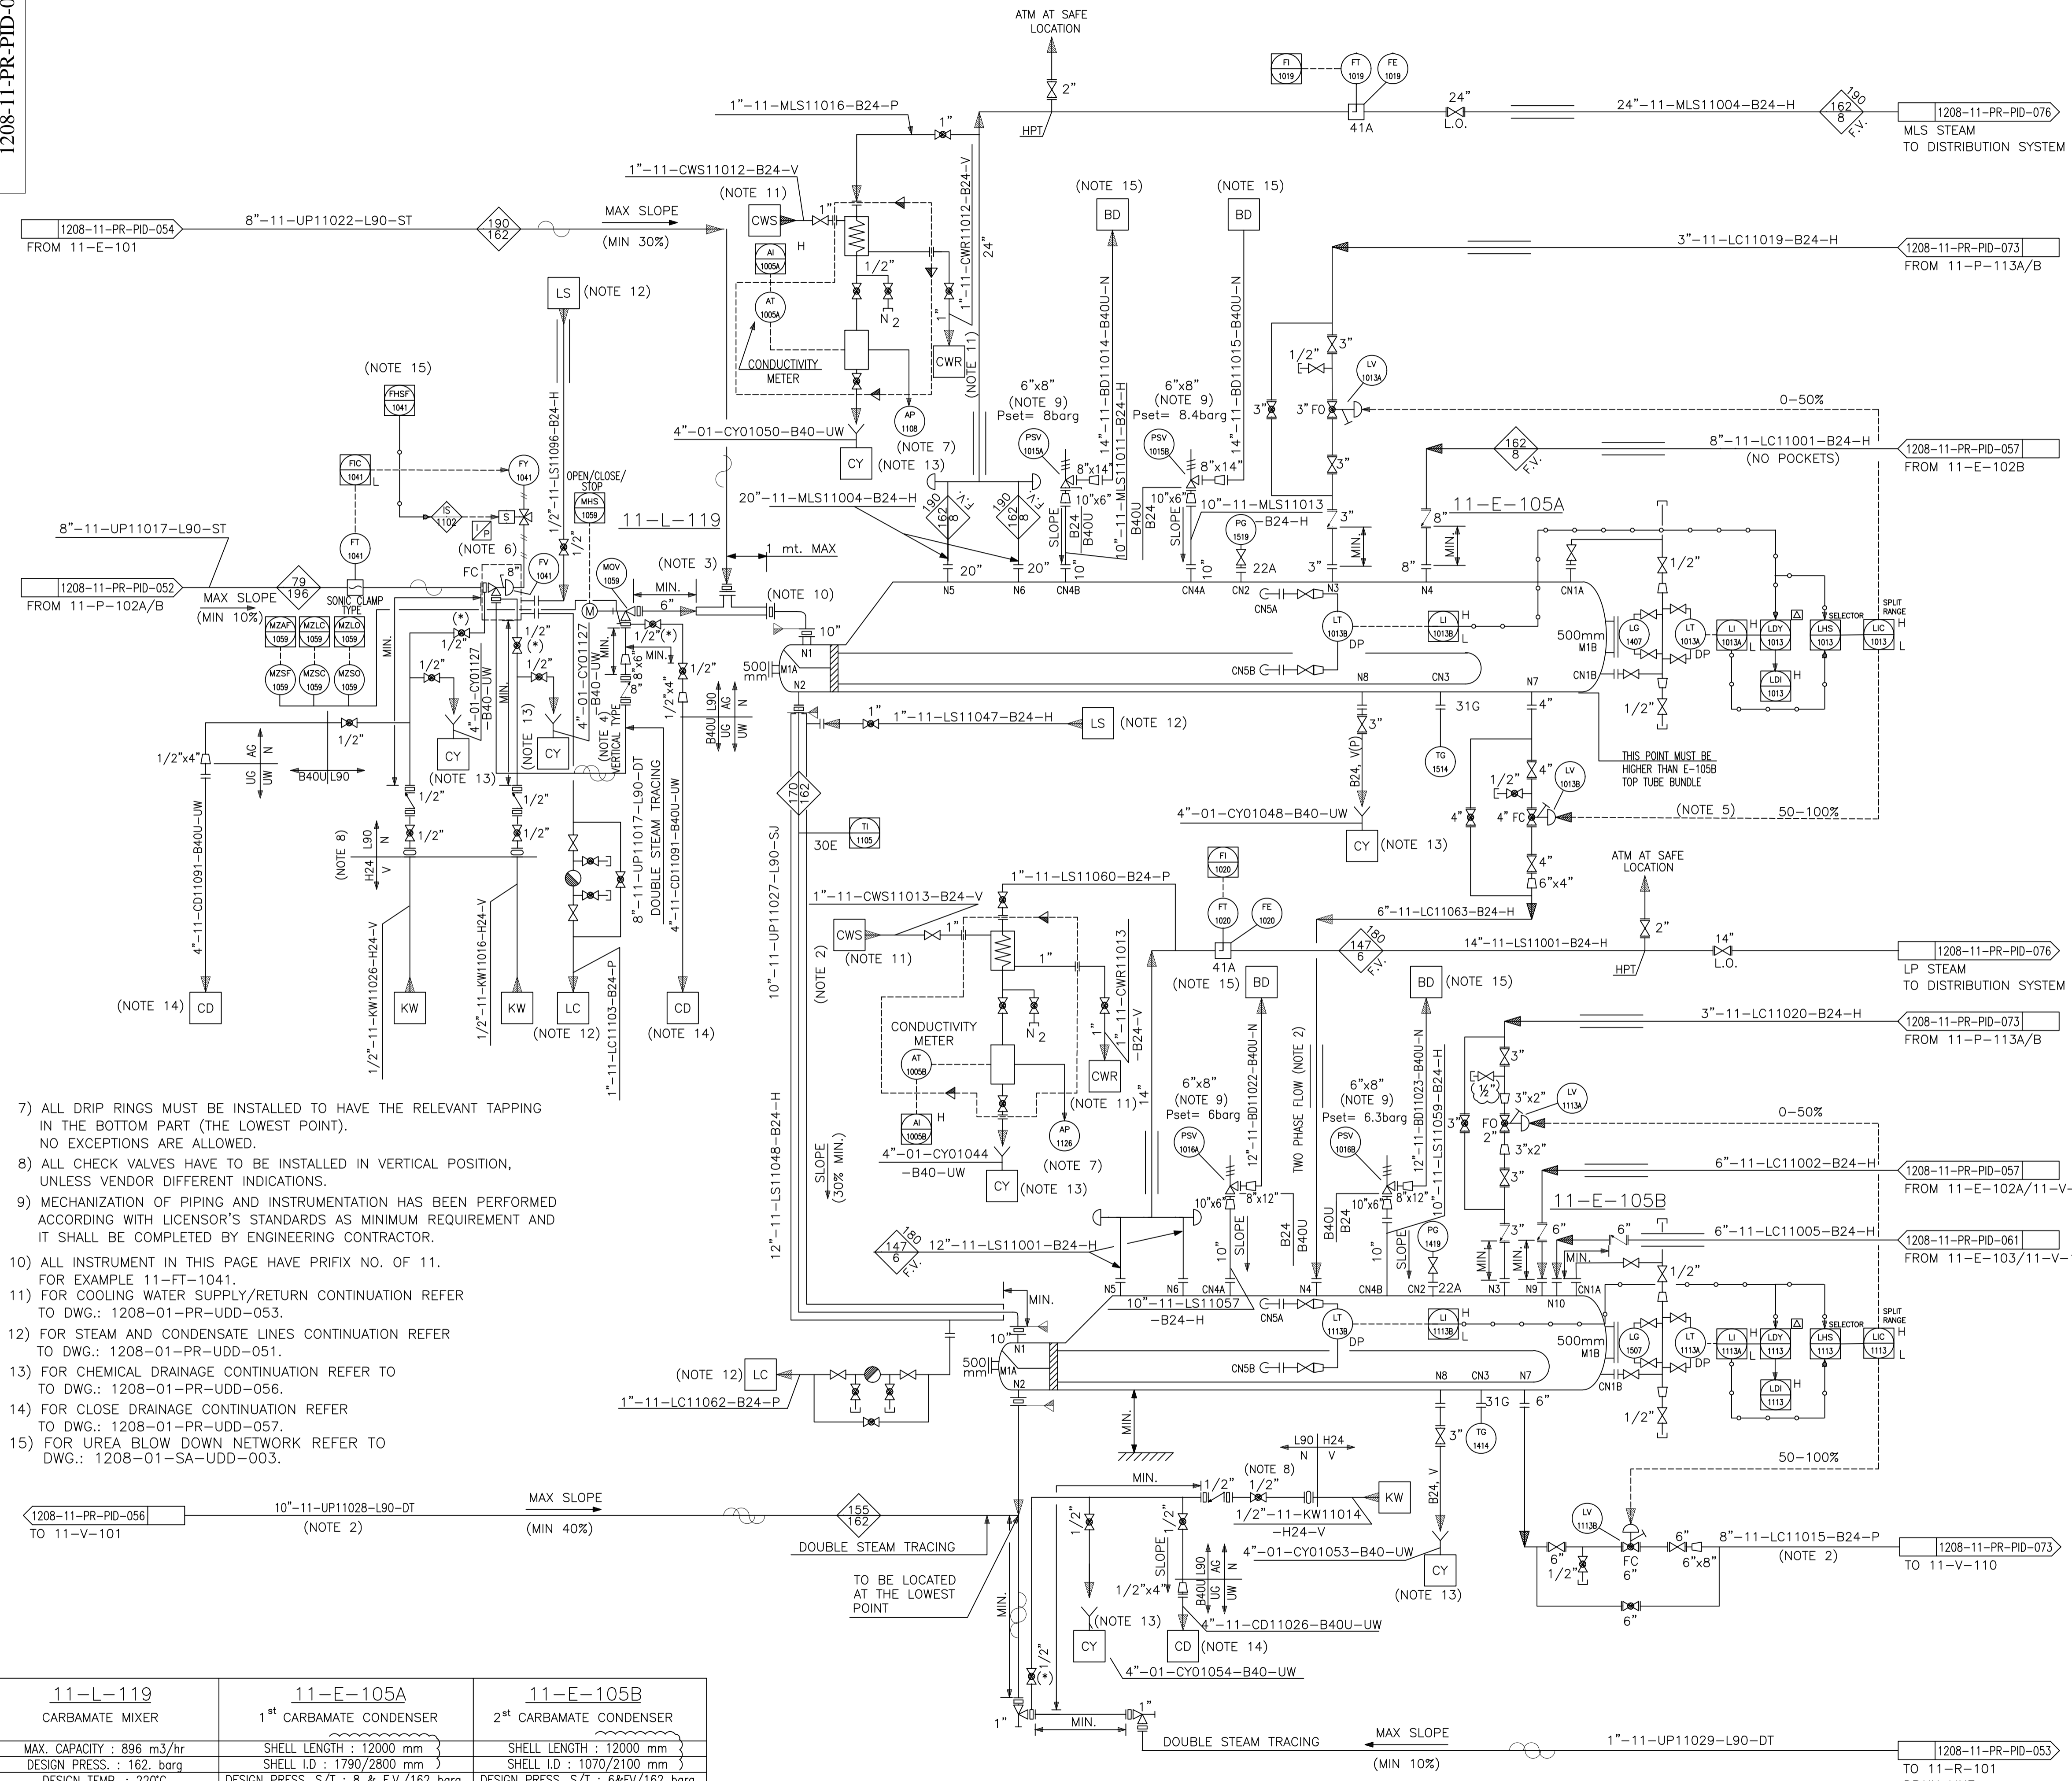

- ALL DRIP RINGS MUST BE INSTALLED TO HAVE THE RELEVANT TAPPING IN THE BOTTOM PART (THE LOWEST POINT). NO EXCEPTIONS ARE ALLOWED.
- ALL CHECK VALVES HAVE TO BE INSTALLED IN VERTICAL POSITION, UNLESS VENDOR DIFFERENT INDICATIONS.
- MECHANIZATION OF PIPING AND INSTRUMENTATION HAS BEEN PERFORMED ACCORDING WITH LICENSOR'S STANDARDS AS MINIMUM REQUIREMENT AND IT SHALL BE COMPLETED BY ENGINEERING CONTRACTOR.
- ALL INSTRUMENT IN THIS PAGE HAVE PREFIX NO. OF 11. FOR EXAMPLE 11-FT-1041.
- FOR COOLING WATER SUPPLY/RETURN CONTINUATION REFER TO DWG.: 1208-01-PR-UDD-053.
- FOR STEAM AND CONDENSATE LINES CONTINUATION REFER TO DWG.: 1208-01-PR-UDD-051.
- FOR CHEMICAL DRAINAGE CONTINUATION REFER TO TO DWG.: 1208-01-PR-UDD-056.
- FOR CLOSE DRAINAGE CONTINUATION REFER TO DWG.: 1208-01-PR-UDD-057.
- FOR UREA BLOW DOWN NETWORK REFER TO DWG.: 1208-01-SA-UDD-003.

11-L-119	11-E-105A	11-E-105B
CARBAMATE MIXER	1 st CARBAMATE CONDENSER	2 nd CARBAMATE CONDENSER
MAX. CAPACITY : 896 m ³ /hr	SHELL LENGTH : 12000 mm	SHELL LENGTH : 12000 mm
DESIGN PRESS. : 162. barg	SHELL I.D. : 1790/2800 mm	SHELL I.D. : 1070/2100 mm
DESIGN TEMP. : 220°C	DESIGN PRESS. S/T : 8 & F.V./162 barg	DESIGN PRESS. S/T : 6&FV/162 barg
INSULATION : YES	DESIGN TEMP. S/T : 190/210°C	DESIGN TEMP. S/T : 180/200°C
	INSULATION : YES	INSULATION : YES
	TRIM LINE NO. : 11-LC11074-B24-H	TRIM LINE NO. : 11-LC11075-B24-H

REFERENCE DRAWING	DWG. NO.
SYMBOLS AND IDENTIFICATIONS	1208-01-PR-PID-051-01

- NOTES:**
- BLOCK VALVES MARKED WITH (*) ARE TO BE INSTALLED WITH THE PLUG FACING THE PROCESS FLUID.
 - TWO-PHASE FLOW REINFORCED SUPPORTS.
 - PV-1021A AND B SHALL BE OPERATED SEPARATELY WHEN THE PRESSURE CONTROLLER IS IN MANUAL MODE.
 - CHECK VALVES TO BE INSTALLED ON VERTICAL POSITION AT MINIMUM DISTANCE FROM XV-1010 BUT IN ORDER TO PERMIT FLANGE BOLTS TORQUING.
 - FOR SAMPLE CONNECTION DETAILS AND PIPING ARRANGEMENT REFER TO P&ID N° 1208-11-PR-PID-080/081.
 - SEE DETAIL "A" ON P&ID 1208-01-PR-PID-051.
 - PROVIDE SUPPORT TO AVOID XV-1010 NOZZLE BENDING.
 - 11-PV-1021A/B OPERATE IN SPLIT RANGE AS SHOWN:
-
- 9) FOR FUNCTION OF HSF, PLEASE REFER TO C&E DOCUMENT.
- GENERAL NOTES:**
- FOR SYMBOLS AND OTHER DETAILS PLEASE REFER TO PID. 1208-01-PR-PID-051.
 - FOR ALL "CD" LINES THE FLANGES ARE TO BE LOCATED AT MINIMUM DISTANCE FROM GRADE. ALL "CD" LINES SHALL HAVE SLOPE TO ENSURE FREE DRAINING TOWARDS 11-TK-104 TANK.
 - SAFETY AND CONTROL VALVE IN/OUT LINES TO BE VERIFIED DURING ENGINEERING PHASE, AFTER CONTROL VALVES AND SAFETY VALVES SELECTION.
 - MFR CONTRACTOR
 - WHERE IT'S INDICATED "MIN" OR "MINIMUM DISTANCE" THE LENGTH OF THE INTERESTED PIPE TO BE KEPT AS SHORT AS POSSIBLE (ABOUT ONE HUNDRED MILLIMETERS) IN ORDER TO PREVENT DEAD ZONE.
 - FOR THE DESCRIPTION OF ATTRIBUTES OF HYDRAULIC CONSTRAINTS OF LINES (SELF DRAINING, SLOPE, GRAVITY FLOW, ETC.) REFER TO DOC. "GENERAL REQUIREMENTS FOR PIPING" WHERE SPECIFIC REQUIREMENTS ARE INDICATED THAT PIPING SHALL FOLLOW. NO EXCEPTIONS ARE ALLOWED.
 - ALL DRIP RINGS MUST BE INSTALLED TO HAVE THE RELEVANT TAPPING IN THE BOTTOM PART (THE LOWEST POINT). NO EXCEPTIONS ARE ALLOWED.
 - ALL CHECK VALVES HAVE TO BE INSTALLED IN VERTICAL POSITION, UNLESS VENDOR/LICENSOR DIFFERENT INDICATIONS.
 - MECHANIZATION OF PIPING AND INSTRUMENTATION HAS BEEN PERFORMED ACCORDING WITH LICENSOR'S STANDARDS AS MINIMUM REQUIREMENT AND IT SHALL BE COMPLETED BY ENGINEERING CONTRACTOR.
 - ALL INSTRUMENT IN THIS PAGE HAVE PREFIX NO. OF 11. FOR EXAMPLE 11-XV-1010.
 - FOR STEAM AND CONDENSATE LINES CONTINUATION REFER TO DWG.: 1208-01-PR-UDD-051.
 - FOR CHEMICAL DRAINAGE CONTINUATION REFER TO DWG.: 1208-01-PR-UDD-056.
 - FOR CLOG DRAINAGE CONTINUATION REFER TO DWG.: 1208-01-PR-UDD-057.
 - FOR UREA BLOW DOWN NETWORK REFER TO DWG.: 1208-01-SA-UDD-003.

HOLD
 - DELETED
 - DELETED

EQUIPMENT LIST	
11-V-101	11-L-101

LICENSOR REF. : P46

DE	EXT	AFC	A
Eng. Phase	Purpose of Distribution (POD)	Purpose of Issue (POI)	Owner's Action


THIS DOCUMENT IS THE PROPERTY OF HFC. IT IS CONFIDENTIAL AND ALL RIGHTS RESERVED. NEITHER THE WHOLE NOR PART OF THIS DOCUMENT MAY BE DISCLOSED TO ANY THIRD PARTY, REPRODUCED, STORED IN ANY RETRIEVAL SYSTEM OR TRANSMITTED IN ANY FORM OR BY ANY MEANS WITHOUT THE PRIOR WRITTEN CONSENT OF HFC.

OWNER:	MC:	EPCC CONTRACTOR:

HENGAM FERTILIZER PROJECT

PIPING AND INSTRUMENTATION DIAGRAM
 HIGH PRESSURE SECTION 4 of 4

SCALE: N.T.S.	OWNER PROJECT NO.: NA	DWG. NO.:	REV.:	SIZE:
PIEC PROJECT NO.: 1208	1208-11-PR-PID-056	04	A1	

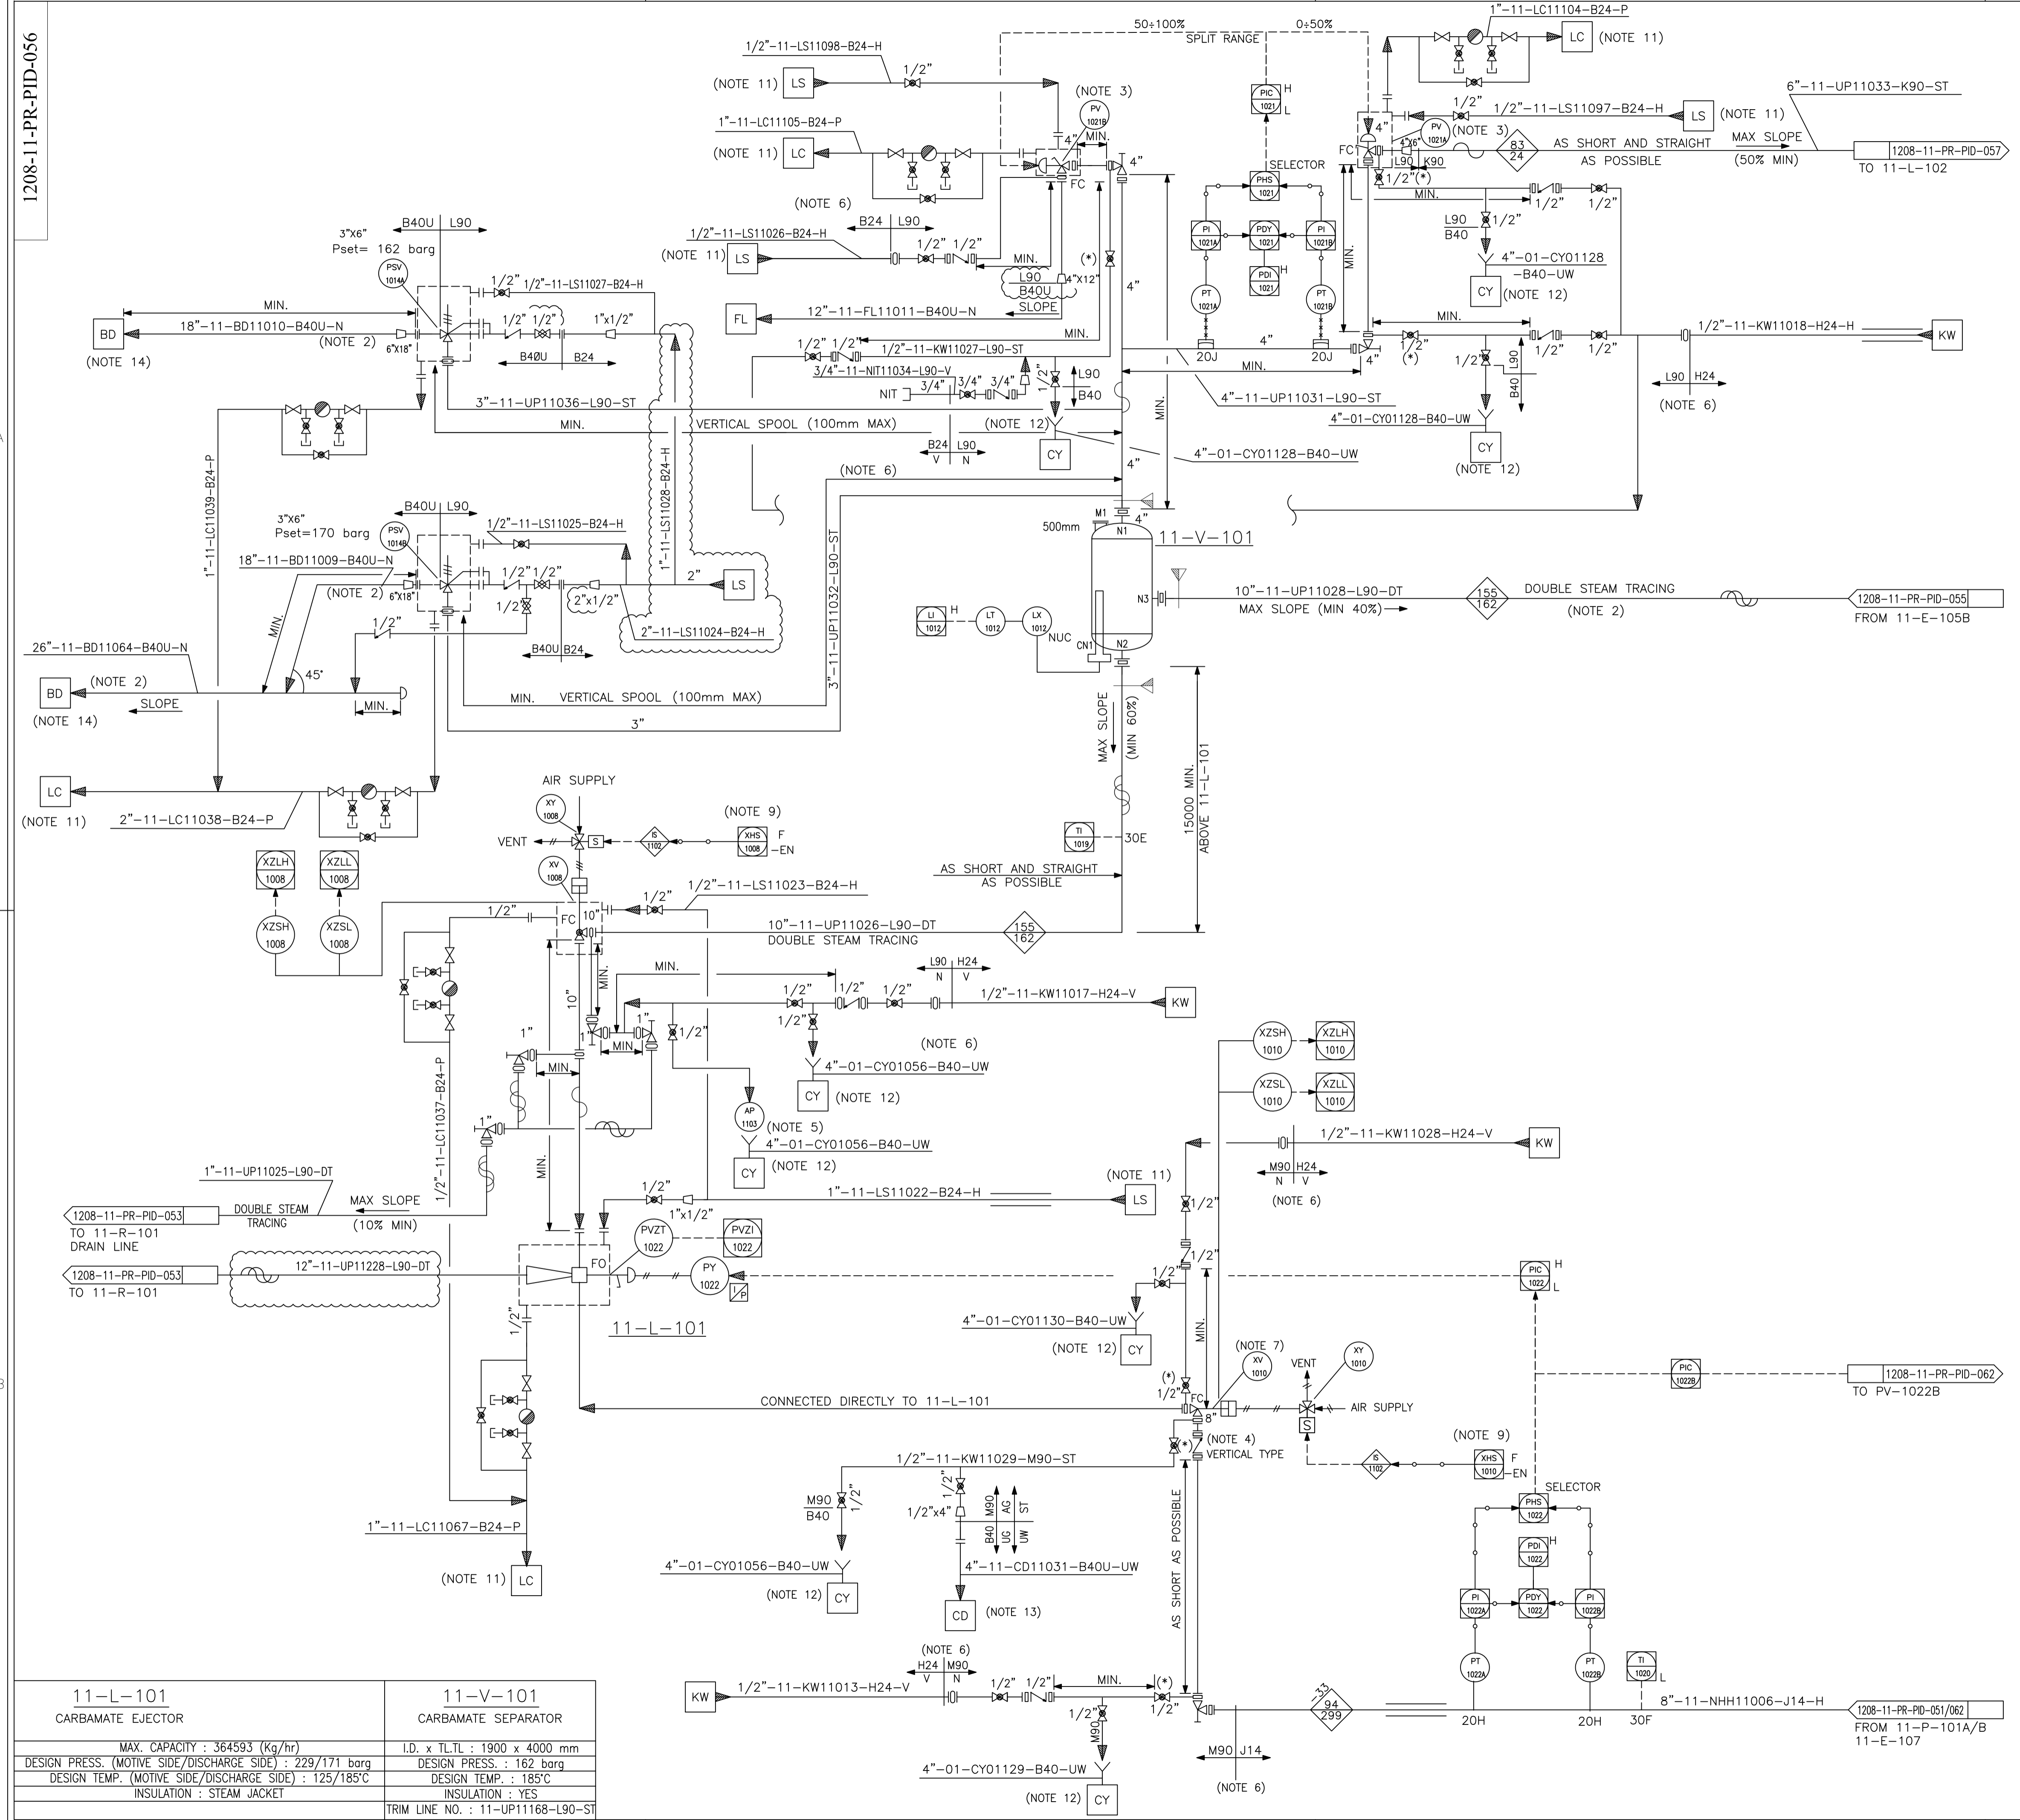

11-L-101	11-V-101
CARBAMATE EJECTOR	CARBAMATE SEPARATOR
MAX. CAPACITY : 364593 (Kg/hr)	I.D. x T.L.T.L : 1900 x 4000 mm
DESIGN PRESS. (MOTIVE SIDE/DISCHARGE SIDE) : 229/171 barg	DESIGN PRESS. : 162 barg
DESIGN TEMP. (MOTIVE SIDE/DISCHARGE SIDE) : 125/185°C	DESIGN TEMP. : 185°C
INSULATION : STEAM JACKET	INSULATION : YES
TRIM LINE NO. : 11-UP11168-L90-ST	

REFERENCE DRAWING	DWG. NO.
SYMBOLS AND IDENTIFICATIONS	1208-01-PR-PID-051-01

NOTES:

- PIPE THK. TO BE IN ACCORDANCE WITH AISI 316L MOD. SPEC. LENS. PIPING SPECIFICATION. THIS LINE TO BE TESTED ACCORDING TO PIPING SPEC. AISI 316L-300RF.
- TWO PHASE FLOW REINFORCED SUPPORT.
- FOR SAMPLE CONNECTION DETAILS AND PIPING ARRANGEMENT REFER TO PID. N° 1208-11-PR-PID-080 AND 1208-11-PR-PID-081
- DRIP RING SPARE PLUG SHALL BE SEAL WELDED.
- LIC-1014 OUTPUT SHALL BE FORCED TO 0% IN CASE OF L-1101 ACTIVATION.
- ELEVATION OF UPPER TANGENT LINE OF 11-V-123 SHALL BE LOWER THAN THE ELEVATION OF INTERMEDIATE TUBESHEET OF 11-E-102 A/B.
- LV-1014 OUTLET LINE SHALL BE MIN. IN HORIZONTAL (AS POSSIBLE).

GENERAL NOTES:

- FOR SYMBOLS AND OTHER DETAILS PLEASE REFER TO PID. 1208-01-PR-PID-051.
- FOR ALL "CD" LINES THE FLANGES ARE TO BE LOCATED AT MINIMUM DISTANCE FROM GRADE. ALL "CD" LINES SHALL HAVE SLOPE TO ENSURE FREE DRAINING TOWARDS 11-TK-104 TANK.
- SAFETY AND CONTROL VALVE IN/OUT LINES AND RELATED BY PASS LINE SIZE TO BE VERIFIED DURING ENGINEERING PHASE, AFTER CONTROL VALVES AND SAFETY VALVES SELECTION.
- MFR CONTRACTOR
- WHERE IT'S INDICATED "MIN" OR "MINIMUM DISTANCE" THE LENGTH OF THE INTERESTED PIPE TO BE KEPT AS SHORT AS POSSIBLE (ABOUT ONE HUNDRED MILLIMETERS) IN ORDER TO PREVENT DEAD ZONE.
- FOR THE DESCRIPTION OF ATTRIBUTES OF HYDRAULIC CONSTRAINTS OF LINES (SELF DRAINING, SLOPE, GRAVITY FLOW, ETC.) REFER TO DOC. "GENERAL REQUIREMENTS FOR PIPING" WHERE SPECIFIC REQUIREMENTS ARE INDICATED THAT PIPING SHALL FOLLOW. NO EXCEPTIONS ARE ALLOWED.
- ALL DRIP RINGS MUST BE INSTALLED TO HAVE THE RELEVANT TAPPING IN THE BOTTOM PART (THE LOWEST POINT). NO EXCEPTIONS ARE ALLOWED.
- ALL CHECK VALVES HAVE TO BE INSTALLED IN VERTICAL POSITION, UNLESS VENDOR DIFFERENT INDICATIONS.
- MECHANIZATION OF PIPING AND INSTRUMENTATION HAS BEEN PERFORMED ACCORDING WITH LICENSOR'S STANDARDS AS MINIMUM REQUIREMENT AND IT SHALL BE COMPLETED BY ENGINEERING CONTRACTOR.
- ALL INSTRUMENT IN THIS PAGE HAVE PREFIX NO. OF 11. FOR EXAMPLE 11-PT-1024.
- FOR STEAM AND CONDENSATE LINES CONTINUATION REFER TO DWG.: 1208-01-PR-IDD-051.
- FOR UREA BLOW DOWN NETWORK REFER TO DWG.: 1208-01-SA-IDD-003.
- FOR CHEMICAL DRAINAGE CONTINUATION REFER TO DWG.: 1208-01-PR-IDD-056.
- FOR CLOSE DRAINAGE CONTINUATION REFER TO DWG.: 1208-01-PR-IDD-057.

HOLD

- DELETED
- DELETED

EQUIPMENT LIST		
11-E-102A/B	11-V-102	11-L-102
	11-V-123	



LICENSOR REF. : P47

DE	EXT	AFC	A
Eng. Phase	Purpose of Distribution (POD)	Purpose of Issue (POI)	Owner's Action
03	26.08.2023	APPROVED FOR CONSTRUCTION	M.Fahnest A.Azma A.Azma M.Sawant
02	05.11.2022	APPROVED FOR CONSTRUCTION (WITH HOLD)	M.Fahnest A.Azma A.Azma M.Sawant
01	12.06.2018	APPROVED FOR CONSTRUCTION (WITH HOLD)	M.Fahnest A.Azma A.Azma M.Sawant
00	13.03.2017	ISSUED FOR ENGINEERING	F.J.Habib A.Habib A.Azma M.Sawant
REV.	ISSUE DATE	DESCRIPTION	PREPARED BY CHECKED BY APPROVED BY PROJECT

OWNER :	MC :	EPC CONTRACTOR :


HENGAM FERTILIZER PROJECT

PROJECT :			
TITLE :			
PIPING AND INSTRUMENTATION DIAGRAM			
MEDIUM PRESSURE SECTION 1 of 4			
SCALE: N.T.S	OWNER PROJECT NO. : NA	DWG. NO. :	REV. SIZE :
SHT. : 1 OF 1	PIDEC PROJECT NO. : 1208	1208-11-PR-PID-057	03 A1

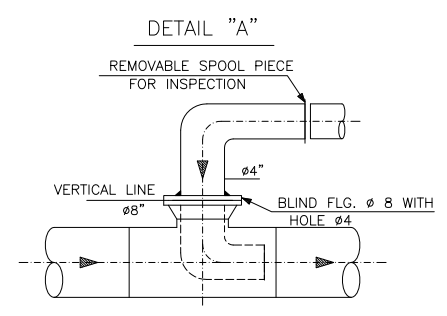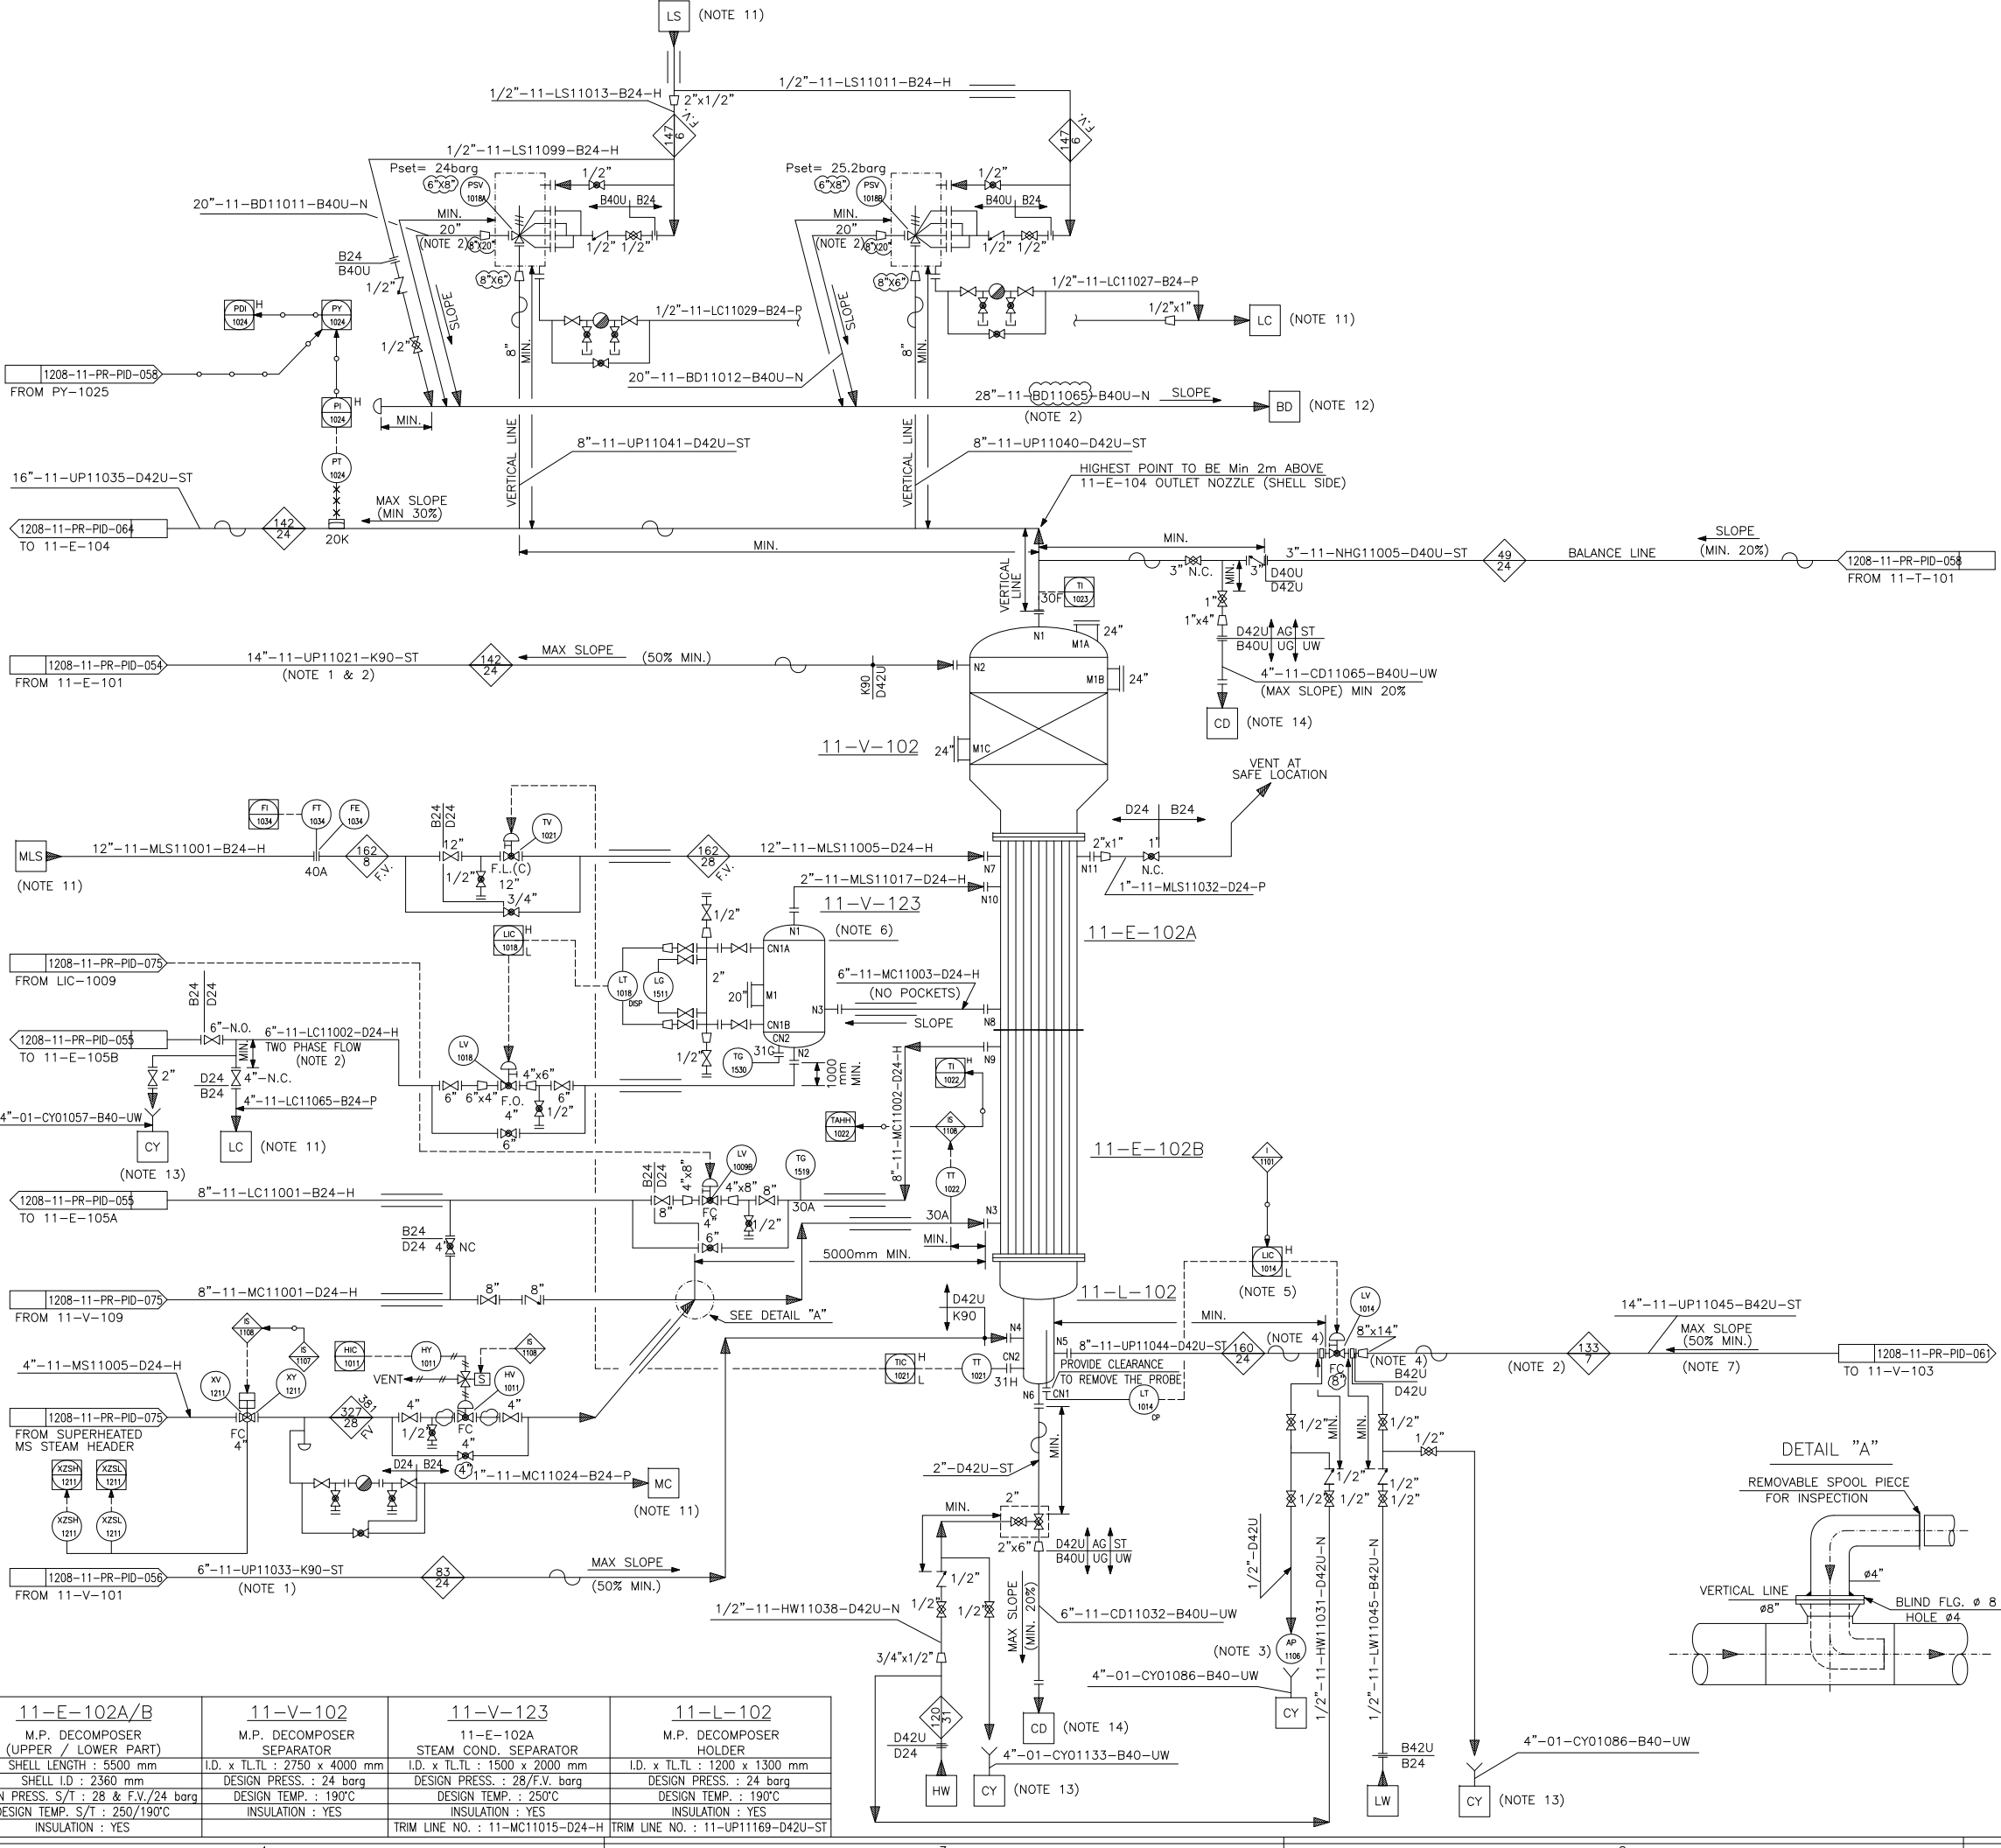

11-E-102A/B	11-V-102	11-V-123	11-L-102
M.P. DECOMPOSER (UPPER / LOWER PART)	M.P. DECOMPOSER SEPARATOR	STEAM COND. SEPARATOR	M.P. DECOMPOSER HOLDER
SHELL LENGTH : 5500 mm	I.D. x T.L.T.L : 2750 x 4000 mm	I.D. x T.L.T.L : 1500 x 2000 mm	I.D. x T.L.T.L : 1200 x 1300 mm
SHELL I.D : 2360 mm	DESIGN PRESS. : 24 barg	DESIGN PRESS. : 28/F.V. barg	DESIGN PRESS. : 24 barg
DESIGN PRESS. S/T : 28 & F.V./24 barg	DESIGN TEMP. : 190°C	DESIGN TEMP. : 250°C	DESIGN TEMP. : 190°C
DESIGN TEMP. S/T : 250/190°C	INSULATION : YES	INSULATION : YES	INSULATION : YES
INSULATION : YES		TRIM LINE NO. : 11-MC11015-D24-H	TRIM LINE NO. : 11-UP11169-D42U-ST

11-T-101 M.P. ABSORBER	11-E-106 M.P. CONDENSER	11-E-109 AMMONIA CONDENSER
I.D. x T.L.T.L : 2600 x 11000 mm	SHELL LENGTH : 4500 mm	SHELL LENGTH : 11790 mm
DESIGN PRESS. : 24 barg	SHELL I.D. : 1225 mm	SHELL I.D. : 1800 mm
DESIGN TEMP. : 120°C	DESIGN PRESS. S/T : 24/8 barg	DESIGN PRESS. S/T : 24/7.5 barg
INSULATION : YES	DESIGN TEMP. S/T : 150/90°C	DESIGN TEMP. S/T : -33 & 120/85°C
TRIM LINE NO. : 11-UP11170-D42U-ST	INSULATION : YES	INSULATION : NO

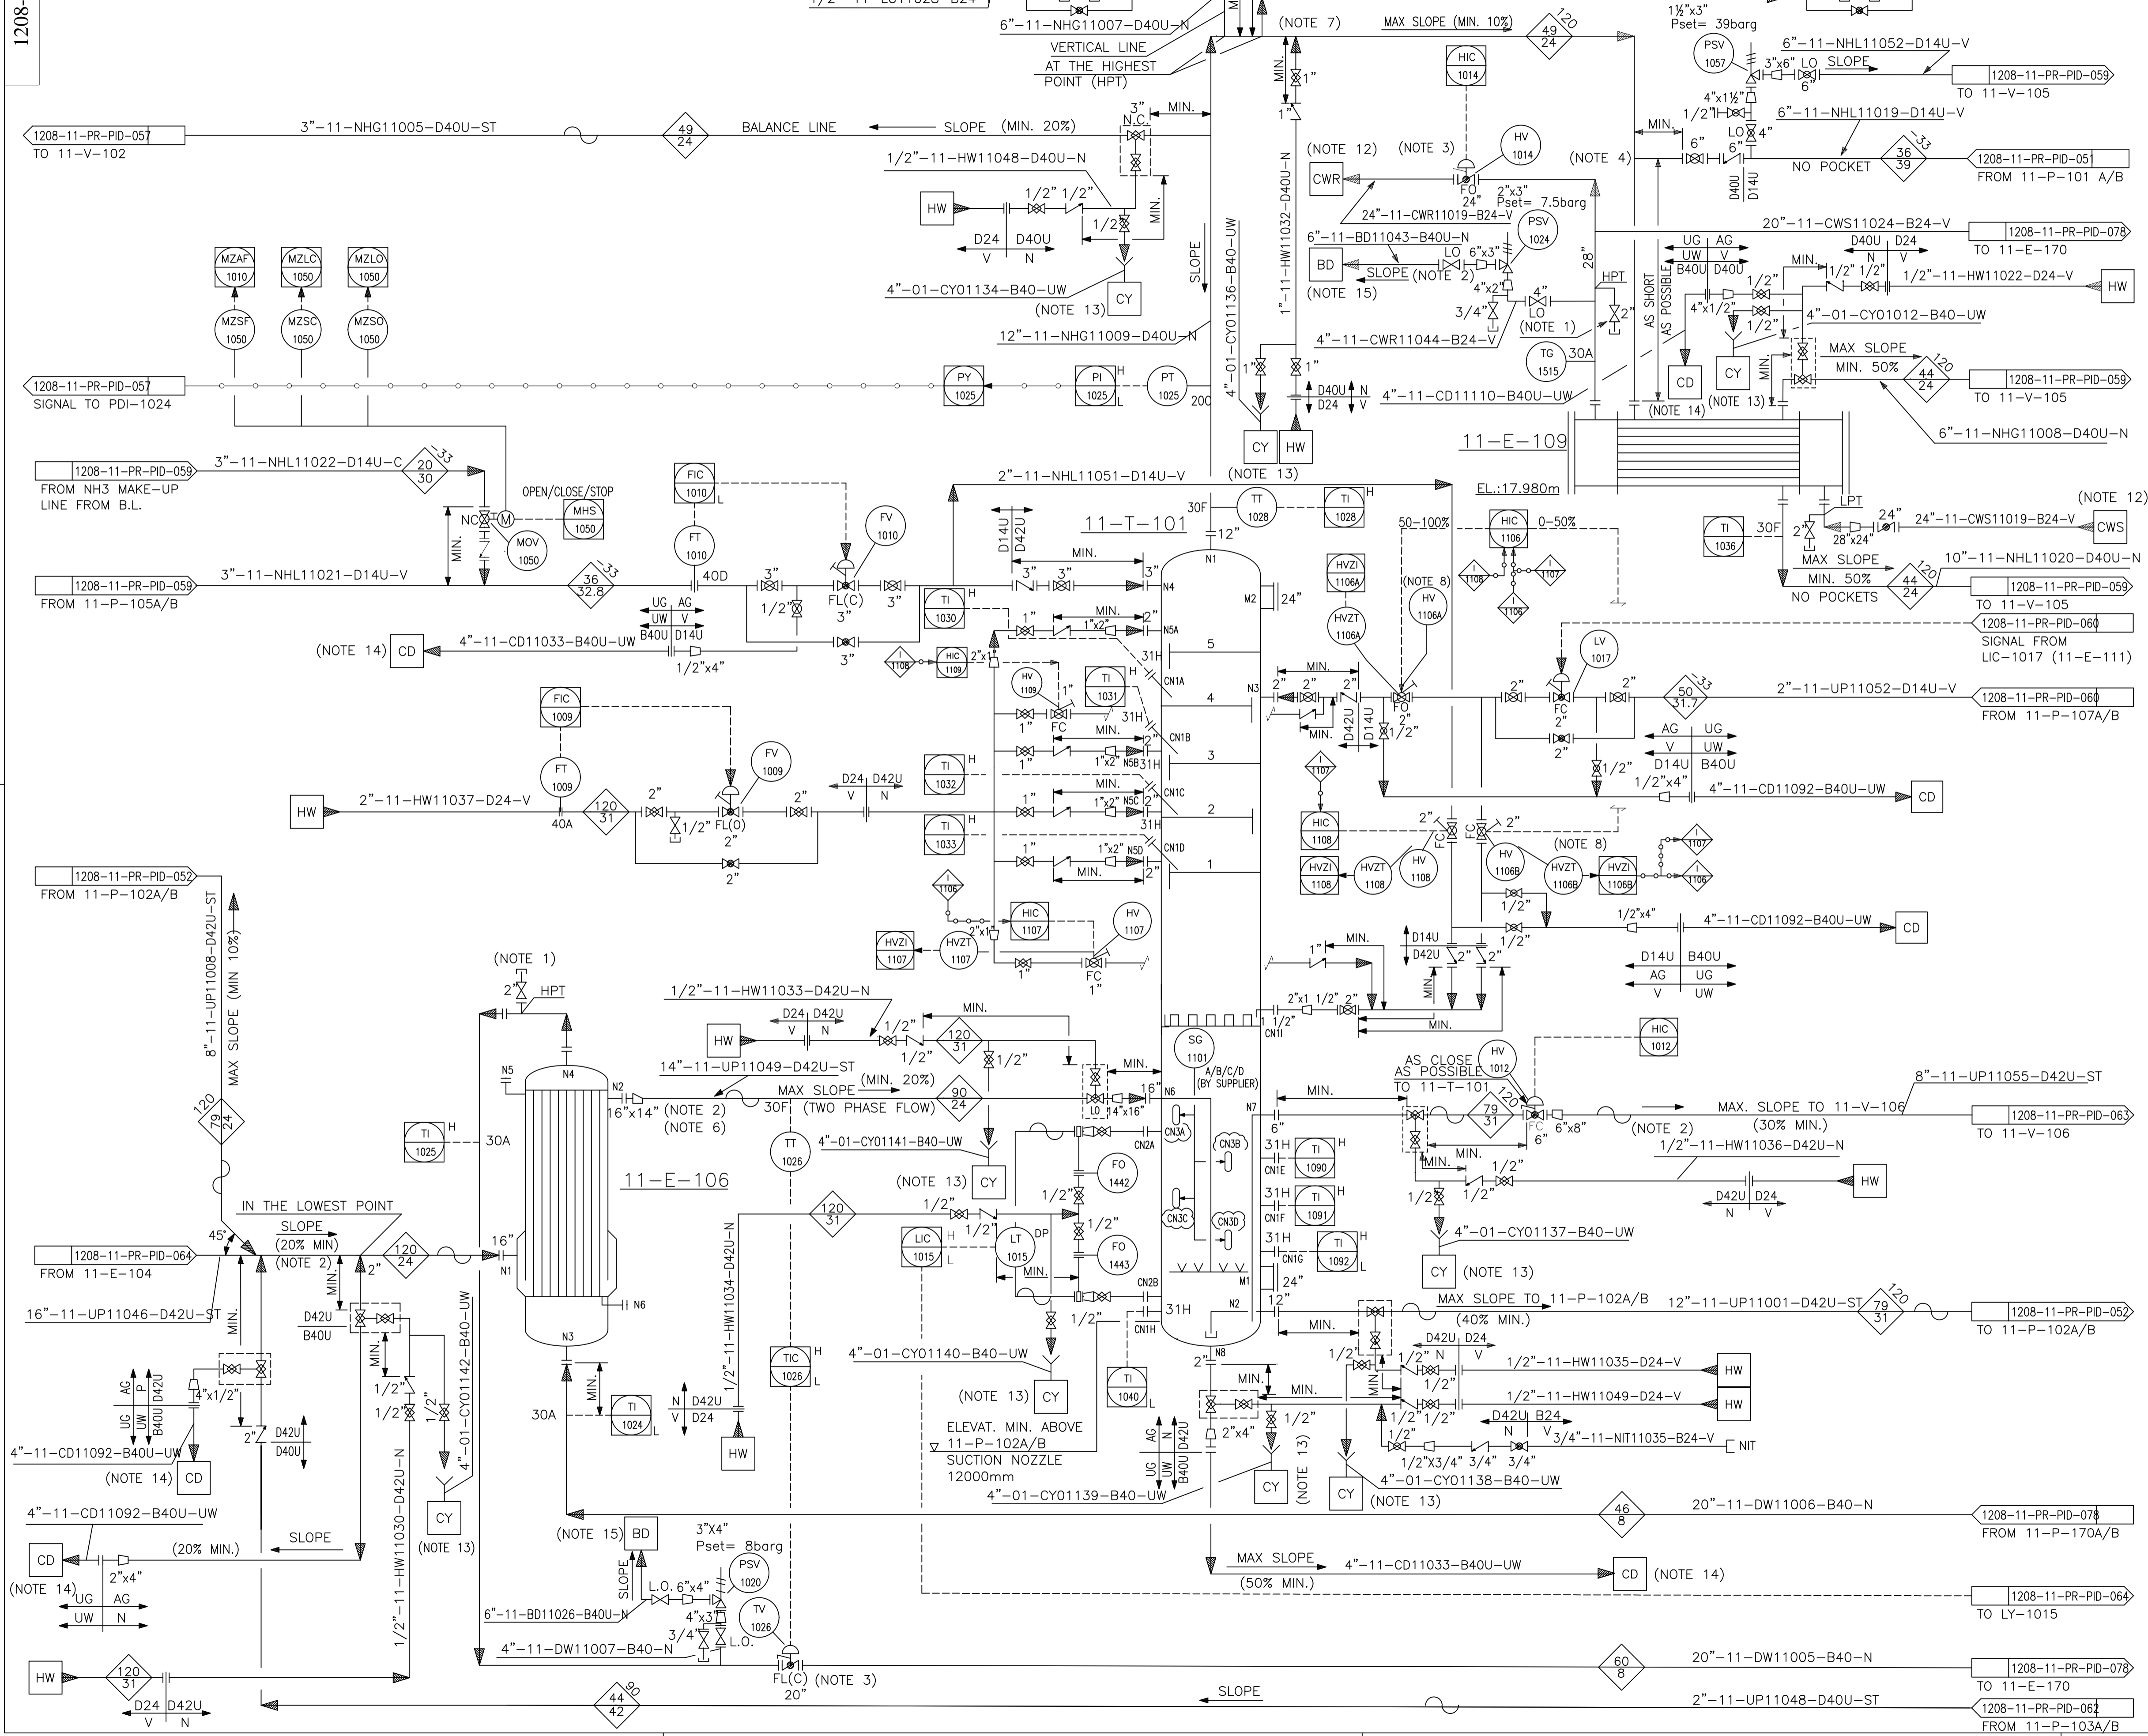

REFERENCE DRAWING	DWG. NO.
SYMBOLS AND IDENTIFICATIONS	1208-01-PR-PID-051-01

- NOTES:**
- 1) VALVE TO BE ACCESSIBLE.
 - 2) TWO PHASE FLOW REINFORCED SUPPORT.
 - 3) VALVE TO BE INSTALLED ON THE FLOOR BELOW THE DM WATER INLET TO 11-E-106.
 - 4) TIE-IN ON THE UPPER TANGENT LINE.
 - 5) VALVE TO BE INSTALLED AT THE SAME LEVEL OF 11-E-109.
 - 6) THIS LINE LOWER THAN 11-V-102 OVHD LINE (2m MIN.) AND AT SAME ELEVATION OF 11-E-104 OUTLET LINE.
 - 7) MAXIMUM SLOPE AFTER THE ELBOW TIE-IN LOCATED AFTER THE ELBOW AT MINIMUM DISTANCE FROM HPT.
 - 8) HV-1106A AND HV-1106B OPENING AND CLOSING MUST BE DONE ACCORDING TO FOLLOW CURVES :

--	--

- GENERAL NOTES:**
- 1) FOR SYMBOLS AND OTHER DETAILS PLEASE REFER TO DOC. 1208-01-PR-PID-051.
 - 2) FOR ALL "CD" LINES THE FLANGES ARE TO BE LOCATED AT MINIMUM DISTANCE FROM GRADE. ALL "CD" LINES SHALL HAVE SLOPE TO ENSURE FREE DRAINING TOWARDS 11-TK-104 TANK.
 - 3) SAFETY AND CONTROL VALVE IN/OUT LINES AND RELATED BY PASS LINE SIZE TO BE VERIFIED DURING ENGINEERING PHASE, AFTER CONTROL VALVES AND SAFETY VALVES SELECTION.
 - 4) MFR CONTRACTOR
 - 5) WHERE IT'S INDICATED "MIN" OR "MINIMUM DISTANCE" THE LENGTH OF THE INTERESTED PIPE TO BE KEPT AS SHORT AS POSSIBLE (ABOUT ONE HUNDRED MILLIMETERS) IN ORDER TO PREVENT DEAD ZONE.
 - 6) FOR THE DESCRIPTION OF ATTRIBUTES OF HYDRAULIC CONSTRAINTS OF LINES (SELF DRAINING, SLOPE, GRAVITY FLOW, ETC.) REFER TO DOC. "GENERAL REQUIREMENTS FOR PIPING" WHERE SPECIFIC REQUIREMENTS ARE INDICATED THAT PIPING SHALL FOLLOW. NO EXCEPTIONS ARE ALLOWED.
 - 7) ALL DRIP RINGS MUST BE INSTALLED TO HAVE THE RELEVANT TAPPING IN THE BOTTOM PART (THE LOWEST POINT). NO EXCEPTIONS ARE ALLOWED.
 - 8) ALL CHECK VALVES HAVE TO BE INSTALLED IN VERTICAL POSITION, UNLESS VENDOR DIFFERENT INDICATIONS.
 - 9) MECHANIZATION OF PIPING AND INSTRUMENTATION HAS BEEN PERFORMED ACCORDING WITH LICENSOR'S STANDARDS AS MINIMUM REQUIREMENT AND IT SHALL BE COMPLETED BY ENGINEERING CONTRACTOR.
 - 10) ALL INSTRUMENT IN THIS PAGE HAVE PREFIX NO. OF 11. FOR EXAMPLE 11-FI-1010.
 - 11) FOR STEAM AND CONDENSATE LINES CONTINUATION REFER TO DWG.: 1208-01-PR-UDD-051.
 - 12) FOR COOLING WATER SUPPLY/RETURN CONTINUATION REFER TO DWG.: 1208-01-PR-UDD-053.
 - 13) FOR CHEMICAL DRAINAGE CONTINUATION REFER TO DWG.: 1208-01-PR-UDD-056.
 - 14) FOR CLOSE DRAINAGE CONTINUATION REFER TO DWG.: 1208-01-PR-UDD-057.
 - 15) FOR UREA BLOW DOWN NETWORK REFER TO DWG.: 1208-01-SA-UDD-003.

HOLD
- DELETED
- DELETED

EQUIPMENT LIST	
11-T-101	11-E-106
11-E-109	

LICENSOR REF. : P48


DE	EXT	AFC	A
Eng. Phase	Purpose of Distribution (POD)	Purpose of Issue (POI)	Owner's Action
04	26.12.2023	APPROVED FOR CONSTRUCTION	M.Fahnest A.Arma A.Arma M.Sarent
03	26.08.2023	APPROVED FOR CONSTRUCTION	M.Fahnest A.Arma A.Arma M.Sarent
02	21.11.2022	APPROVED FOR CONSTRUCTION (WITH HOLD)	M.Fahnest M.Yanfangpanah A.Arma M.Sarent
01	12.06.2018	APPROVED FOR CONSTRUCTION (WITH HOLD)	M.Yanfangpanah A.Arma A.Arma M.Sarent
00	13.03.2017	ISSUED FOR ENGINEERING	F.Mizale A.Habibi A.Arma M.Sarent

REV.	DATE	DESCRIPTION	PREPARED BY	CHECKED BY	APPROVED BY	PROJECT
OWNER :	MC :	EPCC CONTRACTOR :				

PROJECT : HENGAM FERTILIZER PROJECT

TITLE : PIPING AND INSTRUMENTATION DIAGRAM
MEDIUM PRESSURE SECTION 2 of 4


SCALE: NTS	OWNER PROJECT NO. : NA	DWG. NO. :	REV. SIZE :
SHT. : 1 OF 1	PIDEC PROJECT NO. : 1208	1208-11-PR-PID-058	04 A1

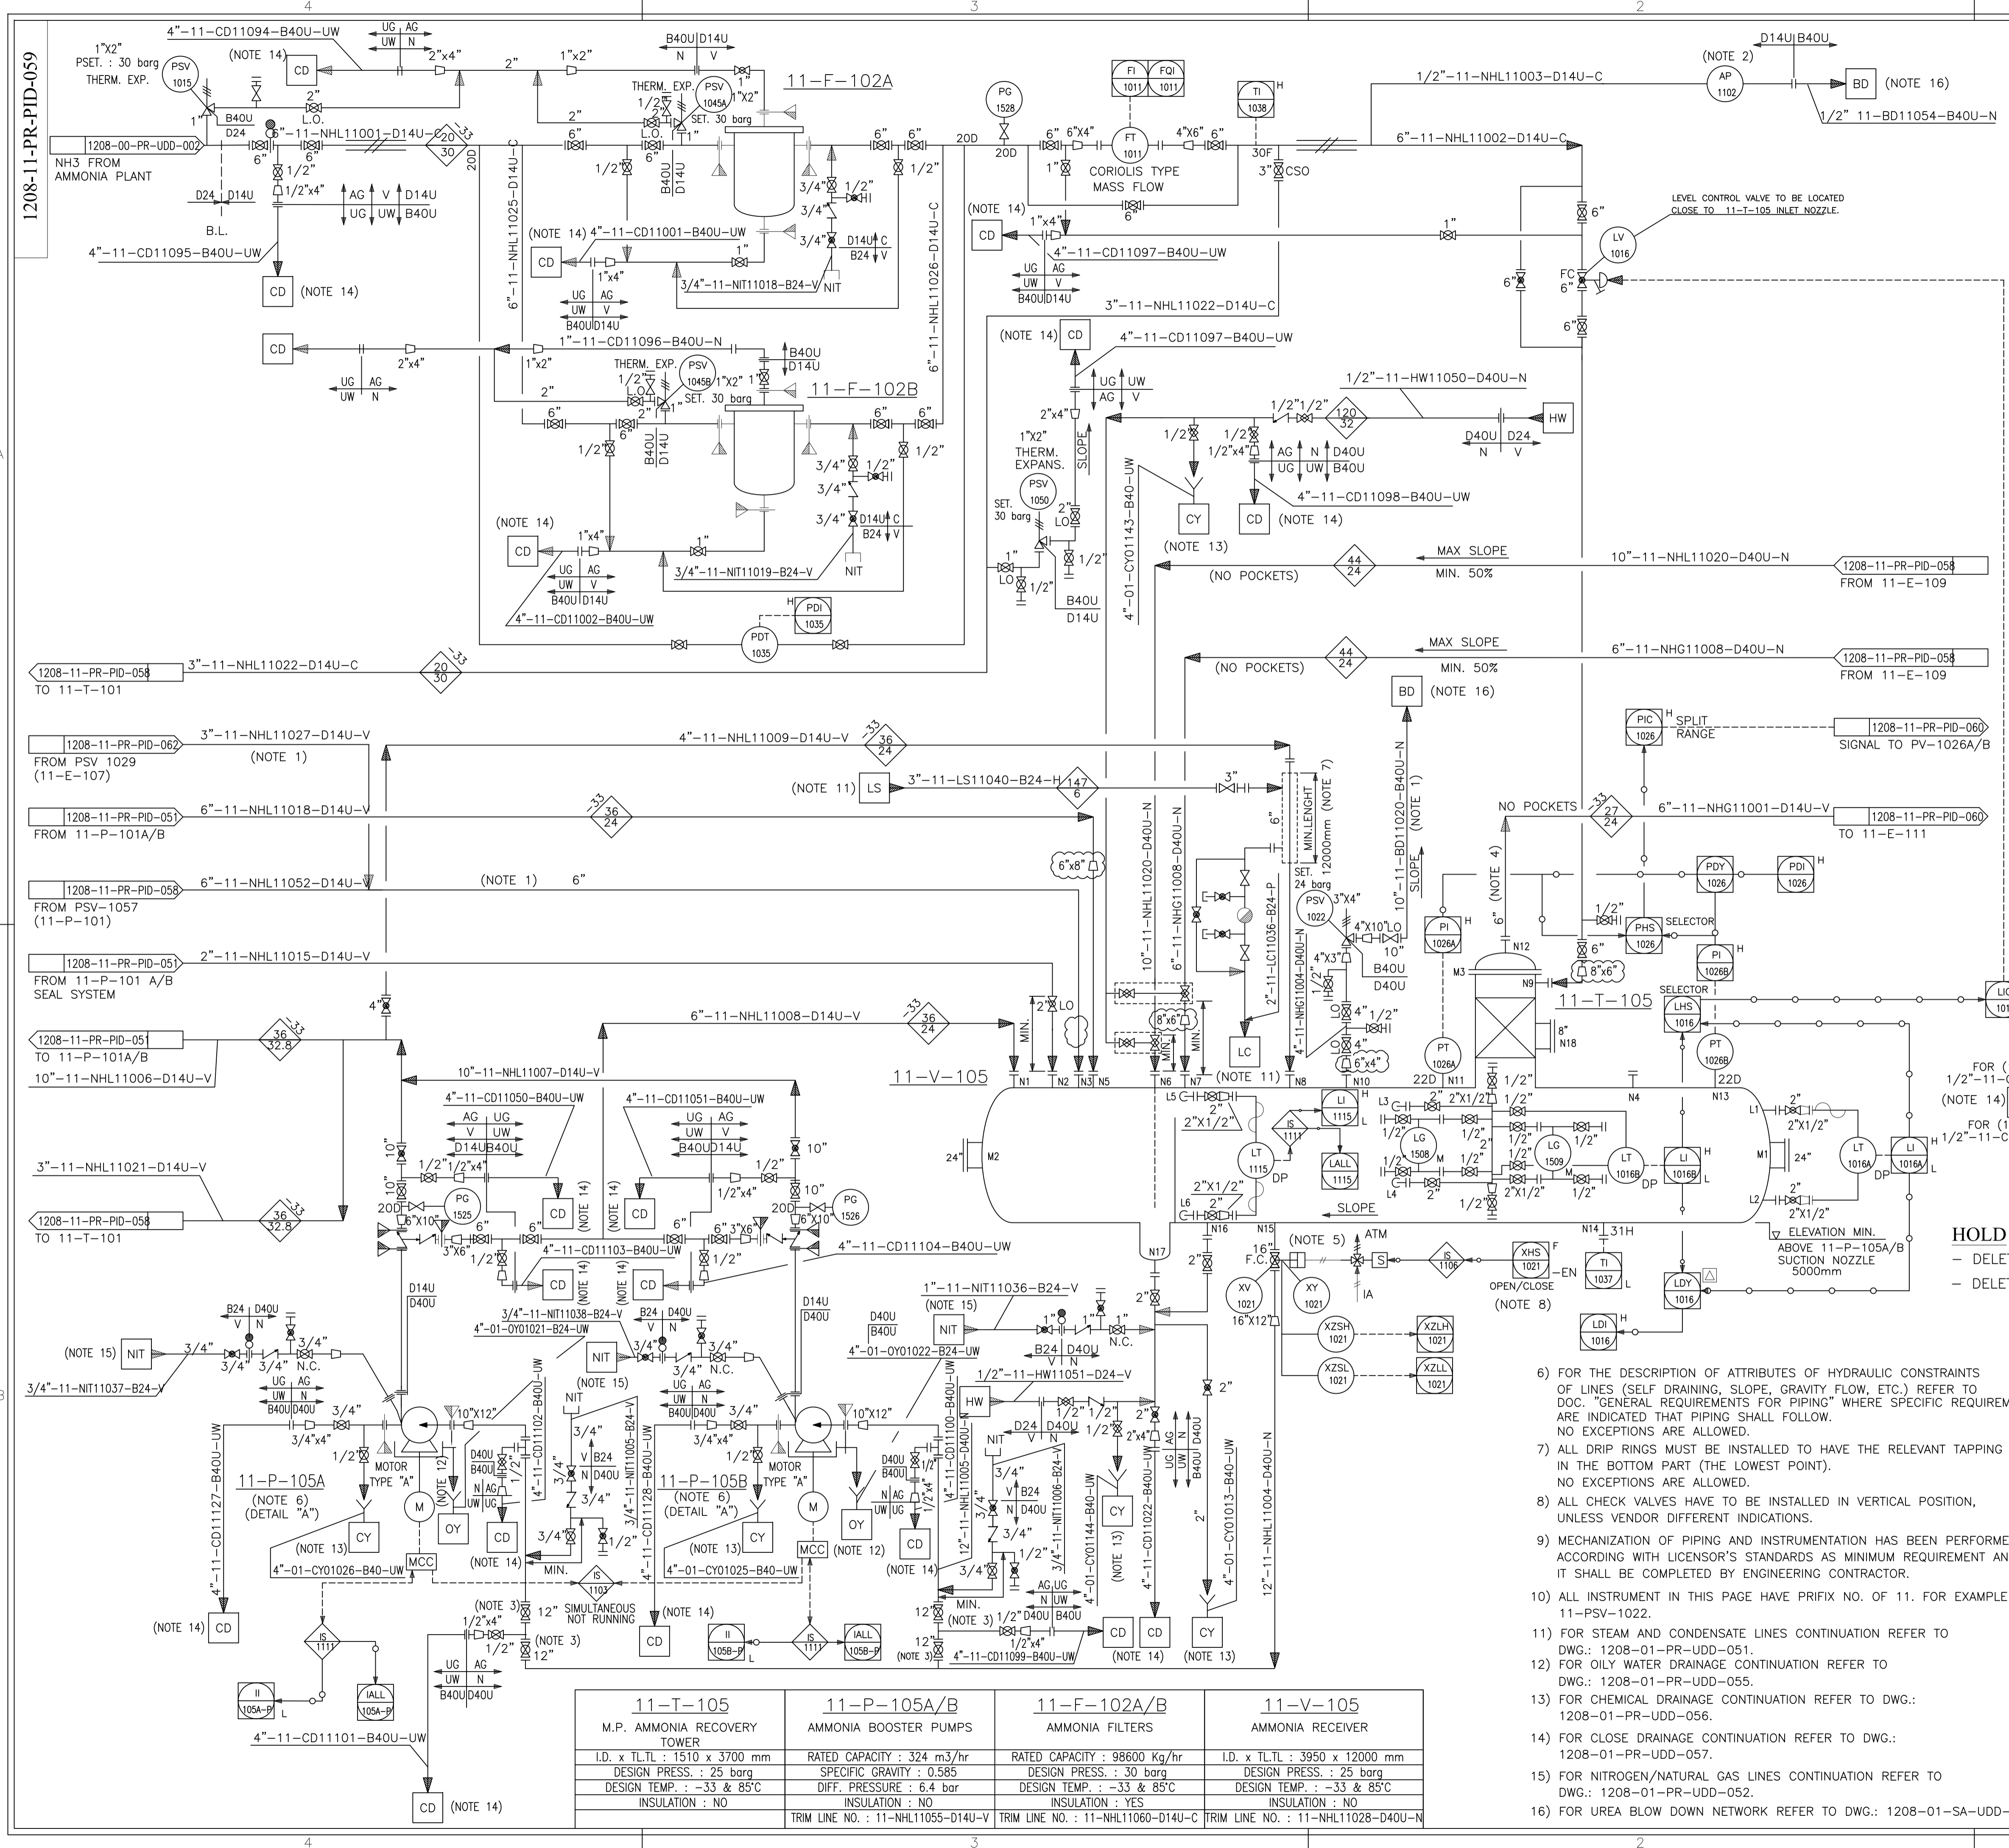

REFERENCE DRAWING	DWG. NO.
SYMBOLS AND IDENTIFICATIONS	1208-01-PR-PID-051-01

- NOTES:**
- TWO PHASE FLOW REINFORCED SUPPORT.
 - FOR SAMPLE CONNECTIONS DETAILS AND PIPING ARRANGEMENT, REFER TO PID. N° 1208-11-PR-PID-080 AND 1208-11-PR-PID-081.
 - FULL BORE BALL VALVE.
 - TOP LINE ELEVATION SAME AS UPPER 11-T-103 T.L.
 - ON-OFF VALVE DIRECTLY CONNECTED WITH LIQUID OUTLET 11-V-105 NOZZLE.
 - ALL PUMPS CONNECTIONS DEFINED AS PER PUMP MFR SELECTION.
 - IN CASE JUMP OVERS ARE REQUIRED FOR LINE-ROUTING CONSTRAINTS, JUMP OVERS MUST BE OF THE SAME SIZE OF STEAM INLET.
 - FOR FUNCTION OF HSF, PLEASE REFER TO C&E DOCUMENT.

- GENERAL NOTES:**
- FOR SYMBOLS AND OTHER DETAILS PLEASE REFER TO PID 1208-01-PR-PID-051.
 - FOR ALL "CD" LINES THE FLANGES ARE TO BE LOCATED AT MINIMUM DISTANCE FROM GRADE. ALL "CD" LINES SHALL HAVE SLOPE TO ENSURE FREE DRAINING TOWARDS 11-TK-104 TANK.
 - SAFETY AND CONTROL VALVE IN/OUT LINES AND RELATED BYPASS LINE SIZE TO BE VERIFIED DURING ENGINEERING PHASE, AFTER CONTROL VALVES AND SAFETY VALVES SELECTION.
 - CONTRACTOR
 - WHERE IT'S INDICATED "MIN" OR "MINIMUM DISTANCE" THE LENGTH OF THE INTERESTED PIPE TO BE KEPT AS SHORT AS POSSIBLE (ABOUT ONE HUNDRED MILLIMETERS) IN ORDER TO PREVENT DEAD ZONE.

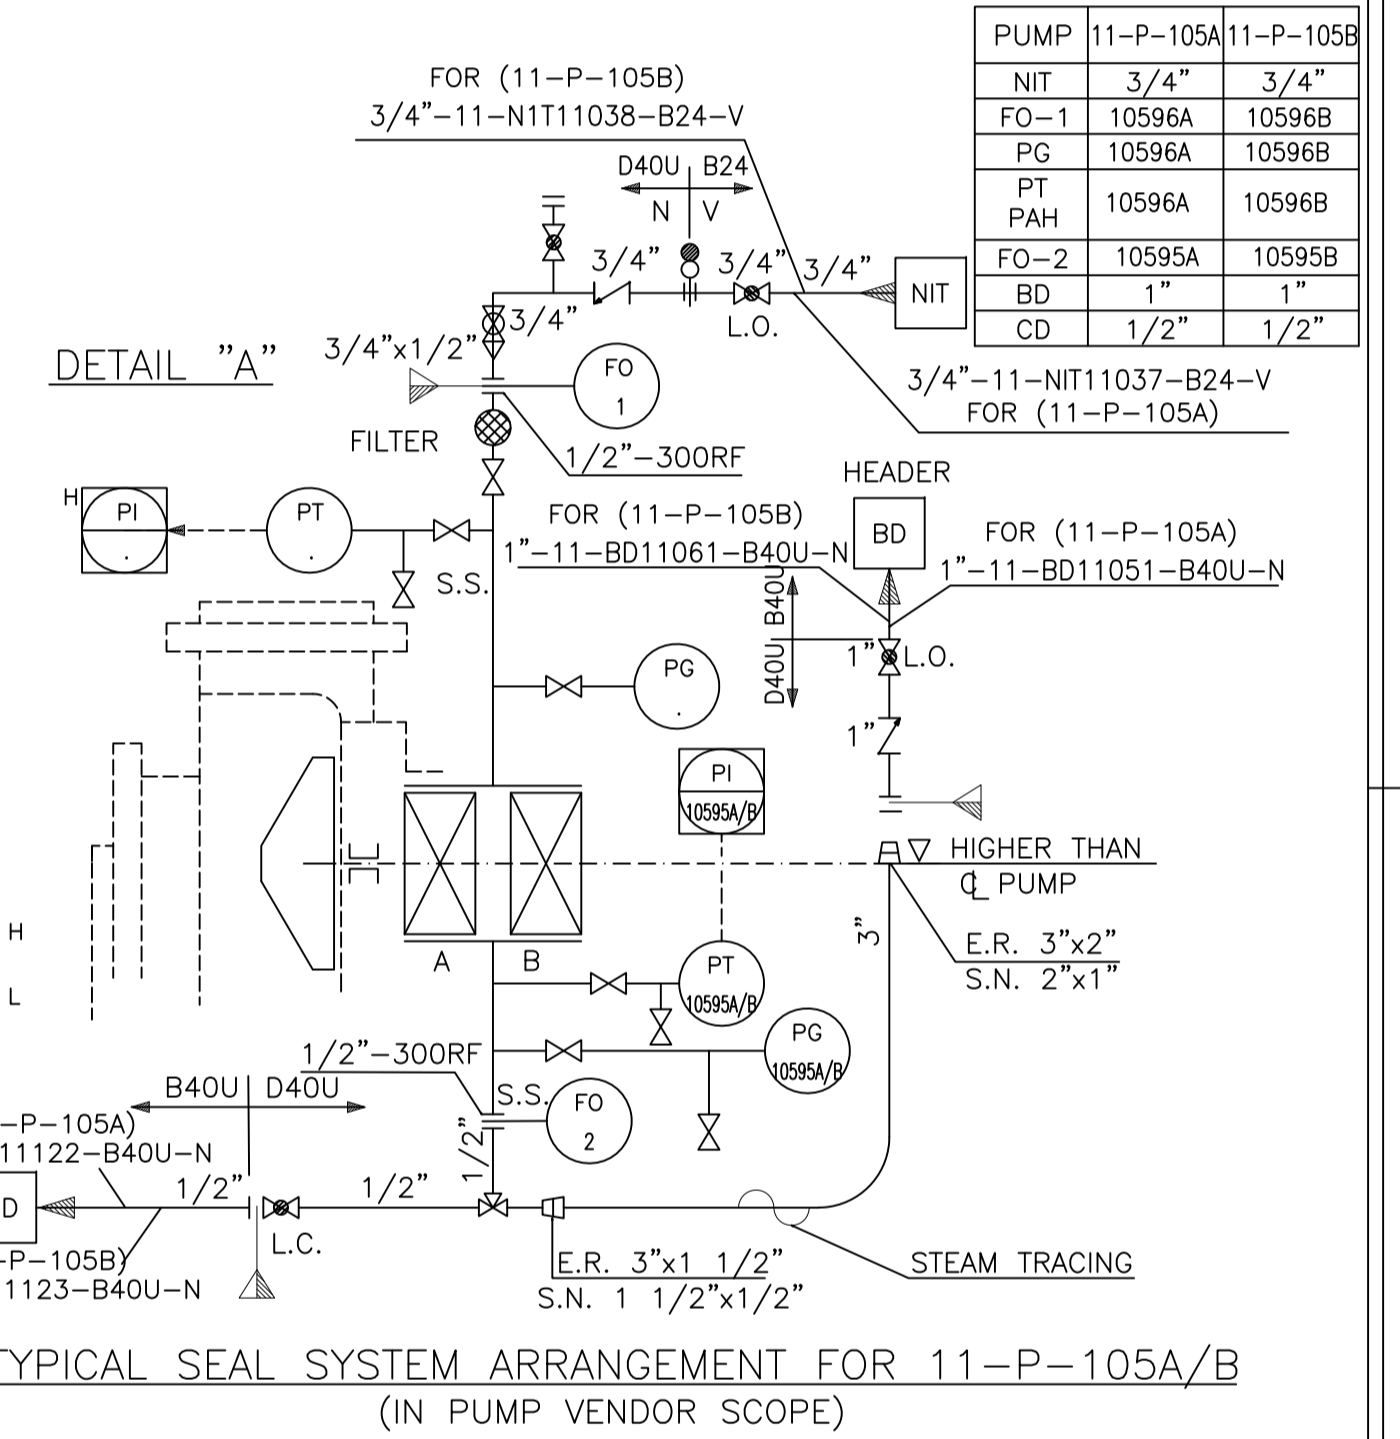

EQUIPMENT LIST

11-V-105	11-T-105	11-P-105A/B	11-F-102A/B
AMMONIA RECEIVER	M.P. AMMONIA RECOVERY TOWER	AMMONIA BOOSTER PUMPS	AMMONIA FILTERS

LICENSOR REF. : P49

DE	EXT	AFC	A
Eng. Phase	Purpose of Distribution (POD)	Purpose of Issue (POI)	Owner's Action
04	30.12.2023	APPROVED FOR CONSTRUCTION	M.Fahrasi, A.Azma, A.Azma, M.Sarimi
03	29.08.2023	APPROVED FOR CONSTRUCTION	M.Fahrasi, A.Azma, A.Azma, M.Sarimi
02	20.11.2022	APPROVED FOR CONSTRUCTION (WITH HOLD)	M.Fahrasi, M.Yadollahi, A.Azma, M.Sarimi
01	12.06.2018	APPROVED FOR CONSTRUCTION (WITH HOLD)	M.Yadollahi, A.Azma, A.Azma, M.Sarimi
00	13.03.2017	ISSUED FOR ENGINEERING	F.Mizaki, A.Habibi, A.Azma, M.Sarimi

OWNER:


PROJECT: **HENGAM FERTILIZER PROJECT**

TITLE: **PIPING AND INSTRUMENTATION DIAGRAM MEDIUM PRESSURE SECTION 3 of 4**

SCALE: N.T.S	OWNER PROJECT NO.: NA	DWG. NO.:	REV. SIZE:
1 OF 1	PIDEC PROJECT NO.: 1208	1208-11-PR-PID-059	04 A1


- FOR THE DESCRIPTION OF ATTRIBUTES OF HYDRAULIC CONSTRAINTS OF LINES (SELF DRAINING, SLOPE, GRAVITY FLOW, ETC.) REFER TO DOC. "GENERAL REQUIREMENTS FOR PIPING" WHERE SPECIFIC REQUIREMENTS ARE INDICATED THAT PIPING SHALL FOLLOW. NO EXCEPTIONS ARE ALLOWED.
- ALL DRIP RINGS MUST BE INSTALLED TO HAVE THE RELEVANT TAPPING IN THE BOTTOM PART (THE LOWEST POINT). NO EXCEPTIONS ARE ALLOWED.
- ALL CHECK VALVES HAVE TO BE INSTALLED IN VERTICAL POSITION, UNLESS VENDOR DIFFERENT INDICATIONS.
- MECHANIZATION OF PIPING AND INSTRUMENTATION HAS BEEN PERFORMED ACCORDING WITH LICENSOR'S STANDARDS AS MINIMUM REQUIREMENT AND IT SHALL BE COMPLETED BY ENGINEERING CONTRACTOR.
- ALL INSTRUMENT IN THIS PAGE HAVE PREFIX NO. OF 11. FOR EXAMPLE 11-PSV-1022.
- FOR STEAM AND CONDENSATE LINES CONTINUATION REFER TO DWG.: 1208-01-PR-UDD-051.
- FOR OILY WATER DRAINAGE CONTINUATION REFER TO DWG.: 1208-01-PR-UDD-055.
- FOR CHEMICAL DRAINAGE CONTINUATION REFER TO DWG.: 1208-01-PR-UDD-056.
- FOR CLOSE DRAINAGE CONTINUATION REFER TO DWG.: 1208-01-PR-UDD-057.
- FOR NITROGEN/NATURAL GAS LINES CONTINUATION REFER TO DWG.: 1208-01-PR-UDD-052.
- FOR UREA BLOW DOWN NETWORK REFER TO DWG.: 1208-01-SA-UDD-003.

11-T-105	11-P-105A/B	11-F-102A/B	11-V-105
M.P. AMMONIA RECOVERY TOWER	AMMONIA BOOSTER PUMPS	AMMONIA FILTERS	AMMONIA RECEIVER
I.D. x T.L.TL : 1510 x 3700 mm	RATED CAPACITY : 324 m3/hr	RATED CAPACITY : 98600 Kg/hr	I.D. x T.L.TL : 3950 x 12000 mm
DESIGN PRESS. : 25 barg	SPECIFIC GRAVITY : 0.585	DESIGN PRESS. : 30 barg	DESIGN PRESS. : 25 barg
DESIGN TEMP. : -33 & 85°C	DIFF. PRESSURE : 6.4 bar	DESIGN TEMP. : -33 & 85°C	DESIGN TEMP. : -33 & 85°C
INSULATION : NO	INSULATION : NO	INSULATION : YES	INSULATION : NO
	TRIM LINE NO. : 11-NHL11055-D14U-V	TRIM LINE NO. : 11-NHL11060-D14U-C	TRIM LINE NO. : 11-NHL11028-D40U-N

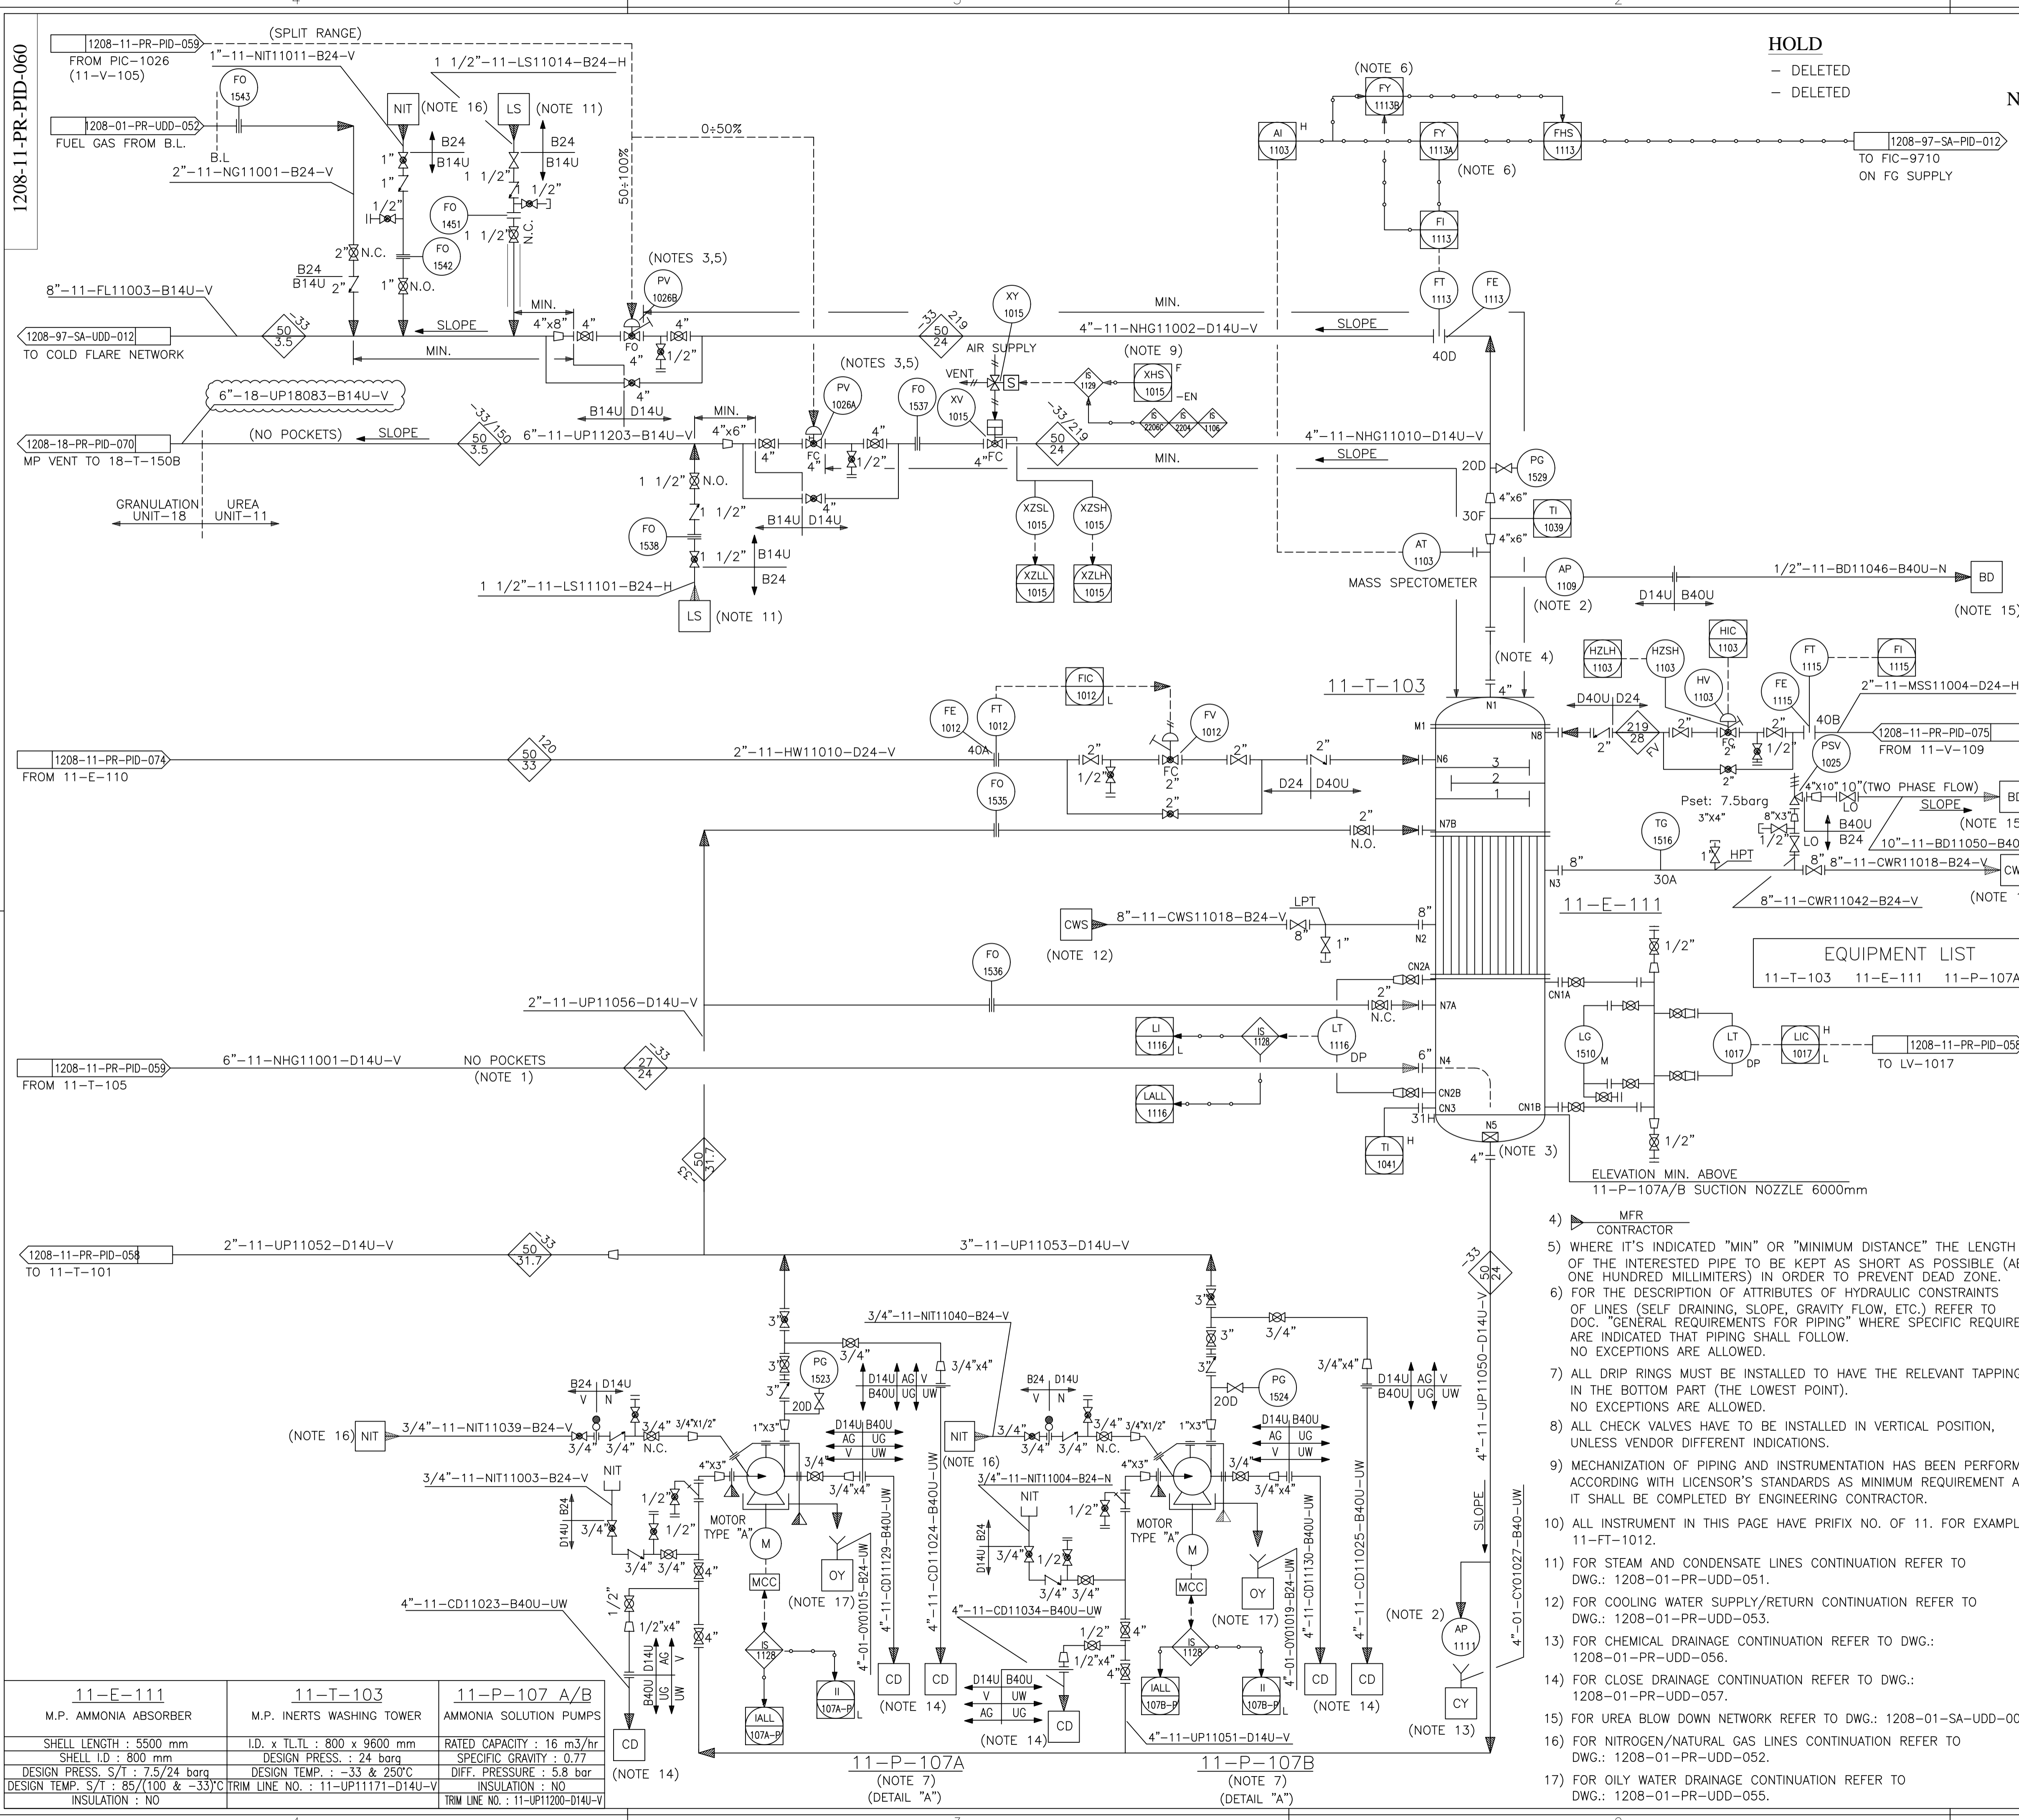


REFERENCE DRAWING	DWG. NO.
SYMBOLS AND IDENTIFICATIONS	1208-01-PR-PID-051-01

- NOTES:**
- TOP LINE ELEVATION SAME AS UPPER 11-T-103 T.L.
 - FOR SAMPLE CONNECTIONS DETAILS AND PIPING ARRANGEMENT, REFER TO P&ID 1208-11-PR-PID-080 AND 1208-11-PR-PID-081.
 - EARTHING REQUIRED TO ENSURE ELECTRICAL CONTINUITY FROM PV-1026A/B AND 11-T-103 BOTTOM.
 - MAX SPOOL LENGTH TO ENSURE 11-T-103 TOP REMOVAL IS 3m ACCORDING TO LAY-OUT.
 - PV-1026A AND PV-1026B SHALL BE OPERATED SEPARATELY WHEN THE PRESSURE CONTROLLER IS IN MANUAL MODE.
 - PROCESS VAPOURS/ASSIST GAS RATIO TO BE DEFINED BY FLARE MFR.
 - ALL PUMPS CONNECTIONS DEFINED AS PER PUMP MFR SELECTION.
 - SPLIT RANGE FOR PV-1026A/B

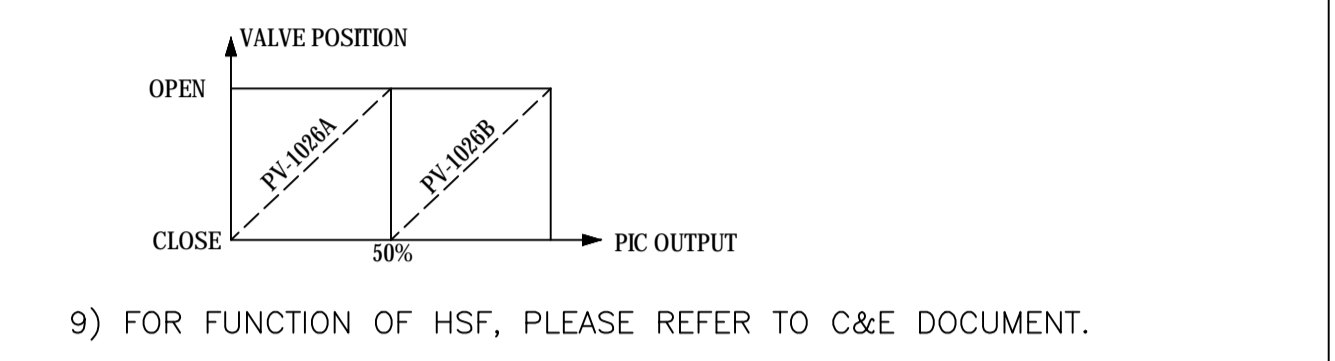

- GENERAL NOTES:**
- FOR SYMBOLS AND OTHER DETAILS PLEASE REFER TO PID 1208-01-PR-PID-051.
 - FOR ALL "CD" LINES THE FLANGES ARE TO BE LOCATED AT MINIMUM DISTANCE FROM GRADE. ALL "CD" LINES SHALL HAVE SLOPE TO ENSURE FREE DRAINING TOWARDS 11-TK-104 TANK.
 - SAFETY AND CONTROL VALVE IN/OUT LINES AND RELATED BYPASS LINE SIZE TO BE VERIFIED DURING ENGINEERING PHASE, AFTER CONTROL VALVES AND SAFETY VALVES SELECTION.

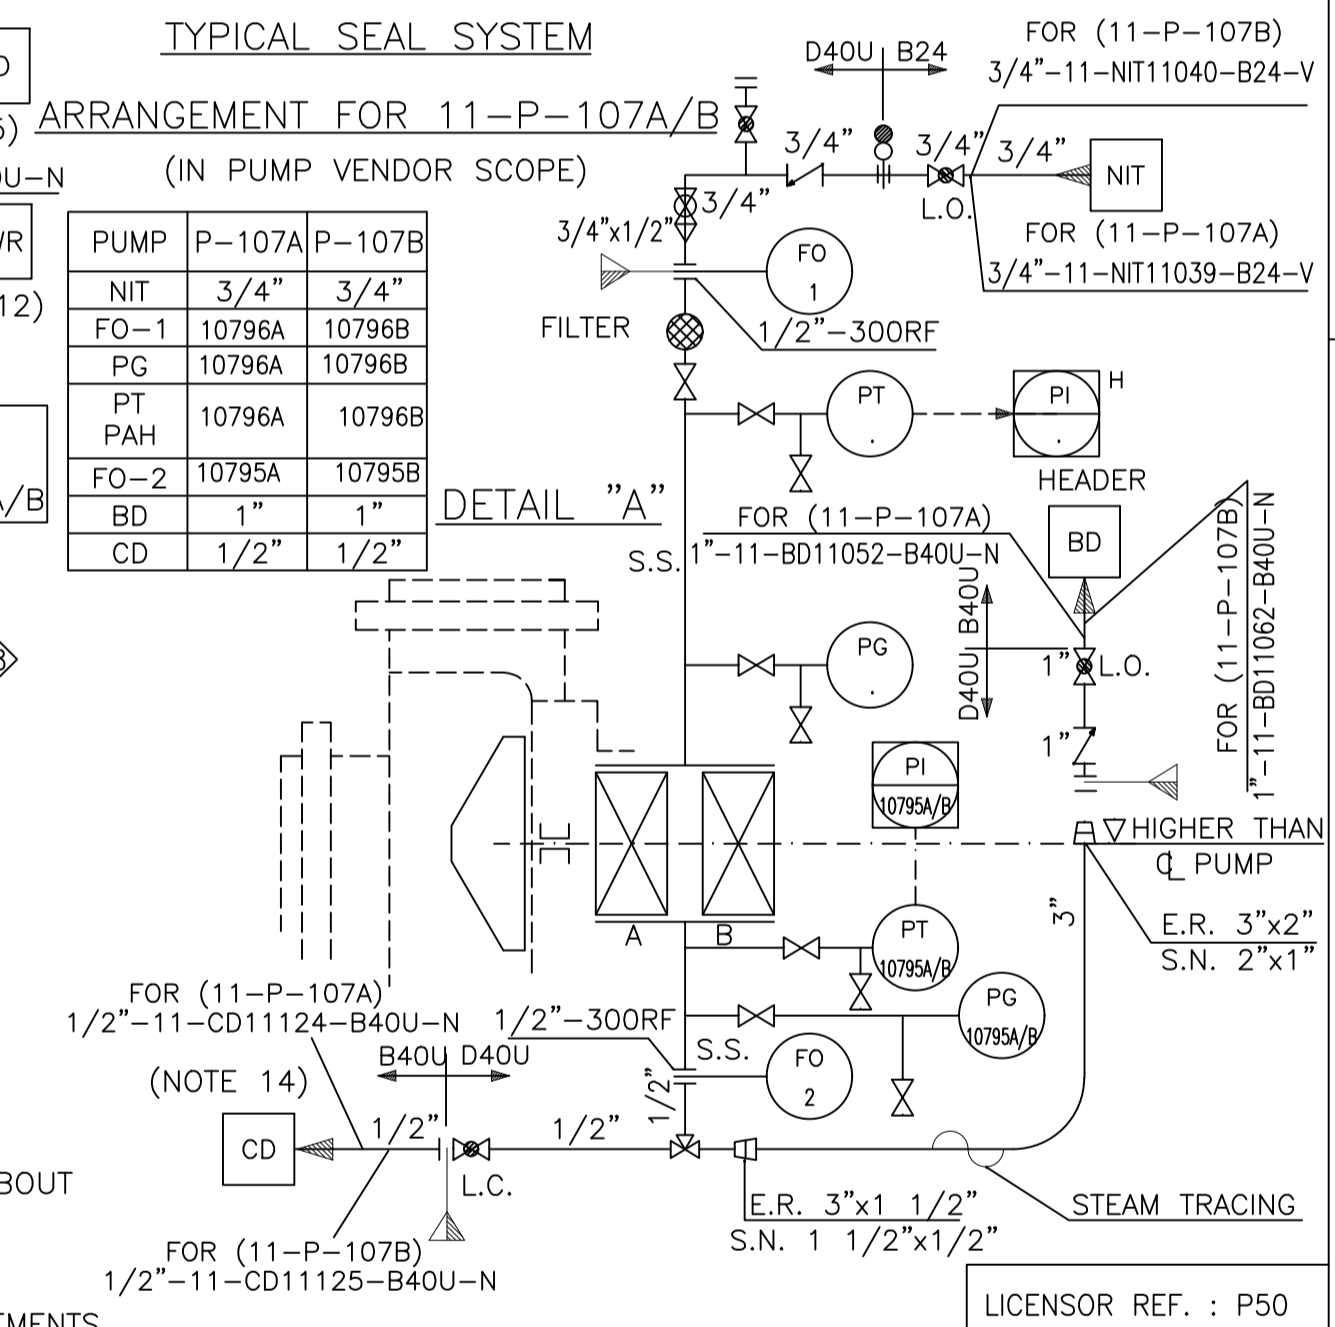

EQUIPMENT LIST

11-T-103	11-E-111	11-P-107A/B
----------	----------	-------------

- MFR CONTRACTOR
- WHERE IT'S INDICATED "MIN" OR "MINIMUM DISTANCE" THE LENGTH OF THE INTERESTED PIPE TO BE KEPT AS SHORT AS POSSIBLE (ABOUT ONE HUNDRED MILLIMETERS) IN ORDER TO PREVENT DEAD ZONE.
- FOR THE DESCRIPTION OF ATTRIBUTES OF HYDRAULIC CONSTRAINTS OF LINES (SELF DRAINING, SLOPE, GRAVITY FLOW, ETC.) REFER TO DOC. "GENERAL REQUIREMENTS FOR PIPING" WHERE SPECIFIC REQUIREMENTS ARE INDICATED THAT PIPING SHALL FOLLOW. NO EXCEPTIONS ARE ALLOWED.
- ALL DRIP RINGS MUST BE INSTALLED TO HAVE THE RELEVANT TAPPING IN THE BOTTOM PART (THE LOWEST POINT). NO EXCEPTIONS ARE ALLOWED.
- ALL CHECK VALVES HAVE TO BE INSTALLED IN VERTICAL POSITION, UNLESS VENDOR DIFFERENT INDICATIONS.
- MECHANIZATION OF PIPING AND INSTRUMENTATION HAS BEEN PERFORMED ACCORDING WITH LICENSOR'S STANDARDS AS MINIMUM REQUIREMENT AND IT SHALL BE COMPLETED BY ENGINEERING CONTRACTOR.
- ALL INSTRUMENT IN THIS PAGE HAVE PRIFIX NO. OF 11. FOR EXAMPLE 11-FT-1012.
- FOR STEAM AND CONDENSATE LINES CONTINUATION REFER TO DWG.: 1208-01-PR-UPD-051.
- FOR COOLING WATER SUPPLY/RETURN CONTINUATION REFER TO DWG.: 1208-01-PR-UPD-053.
- FOR CHEMICAL DRAINAGE CONTINUATION REFER TO DWG.: 1208-01-PR-UPD-056.
- FOR CLOSE DRAINAGE CONTINUATION REFER TO DWG.: 1208-01-PR-UPD-057.
- FOR UREA BLOW DOWN NETWORK REFER TO DWG.: 1208-01-SA-UPD-003.
- FOR NITROGEN/NATURAL GAS LINES CONTINUATION REFER TO DWG.: 1208-01-PR-UPD-052.
- FOR OILY WATER DRAINAGE CONTINUATION REFER TO DWG.: 1208-01-PR-UPD-055.

11-E-111	11-T-103	11-P-107 A/B
M.P. AMMONIA ABSORBER	M.P. INERTS WASHING TOWER	AMMONIA SOLUTION PUMPS
SHELL LENGTH : 5500 mm	I.D. x T.L.T. : 800 x 9600 mm	RATED CAPACITY : 16 m ³ /hr
SHELL I.D. : 800 mm	DESIGN PRESS. : 24 barg	SPECIFIC GRAVITY : 0.77
DESIGN PRESS. S/T : 7.5/24 barg	DESIGN TEMP. : -33 & 250°C	DIFF. PRESSURE : 5.8 bar
DESIGN TEMP. S/T : 85/(100 & -33)°C	TRIM LINE NO. : 11-UP11171-D14U-V	INSULATION : NO
INSULATION : NO	TRIM LINE NO. : 11-UP11200-D14U-V	

DE	EXT	AFC	A
Eng. Phase	Purpose of Distribution (POD)	Purpose of Issue (POI)	Owner's Action
04	26.12.2023	APPROVED FOR CONSTRUCTION	M.Fakhrani A.Arma A.Arma M.Sareni
03	28.08.2023	APPROVED FOR CONSTRUCTION	M.Fakhrani M.Yanzhapanah A.Arma M.Sareni
02	20.11.2022	APPROVED FOR CONSTRUCTION (WITH HOLD)	M.Fakhrani M.Yanzhapanah A.Arma M.Sareni
01	12.06.2018	APPROVED FOR CONSTRUCTION (WITH HOLD)	M.Yanzhapanah A.Arma A.Arma M.Sareni
00	13.03.2017	ISSUED FOR ENGINEERING	F.Mizale A.Habibi A.Arma M.Sareni

OWNER:


MC:

EPCC CONTRACTOR:

PROJECT: **HENGAM FERTILIZER PROJECT**


TITLE: **PIPING AND INSTRUMENTATION DIAGRAM MEDIUM PRESSURE SECTION 4 of 4**

SCALE: NTS	OWNER PROJECT NO.: NA	DWG. NO.:	REV. SIZE:
SHT.: 1 OF 1	PIDEC PROJECT NO.: 1208	1208-11-PR-PID-060	04 A1

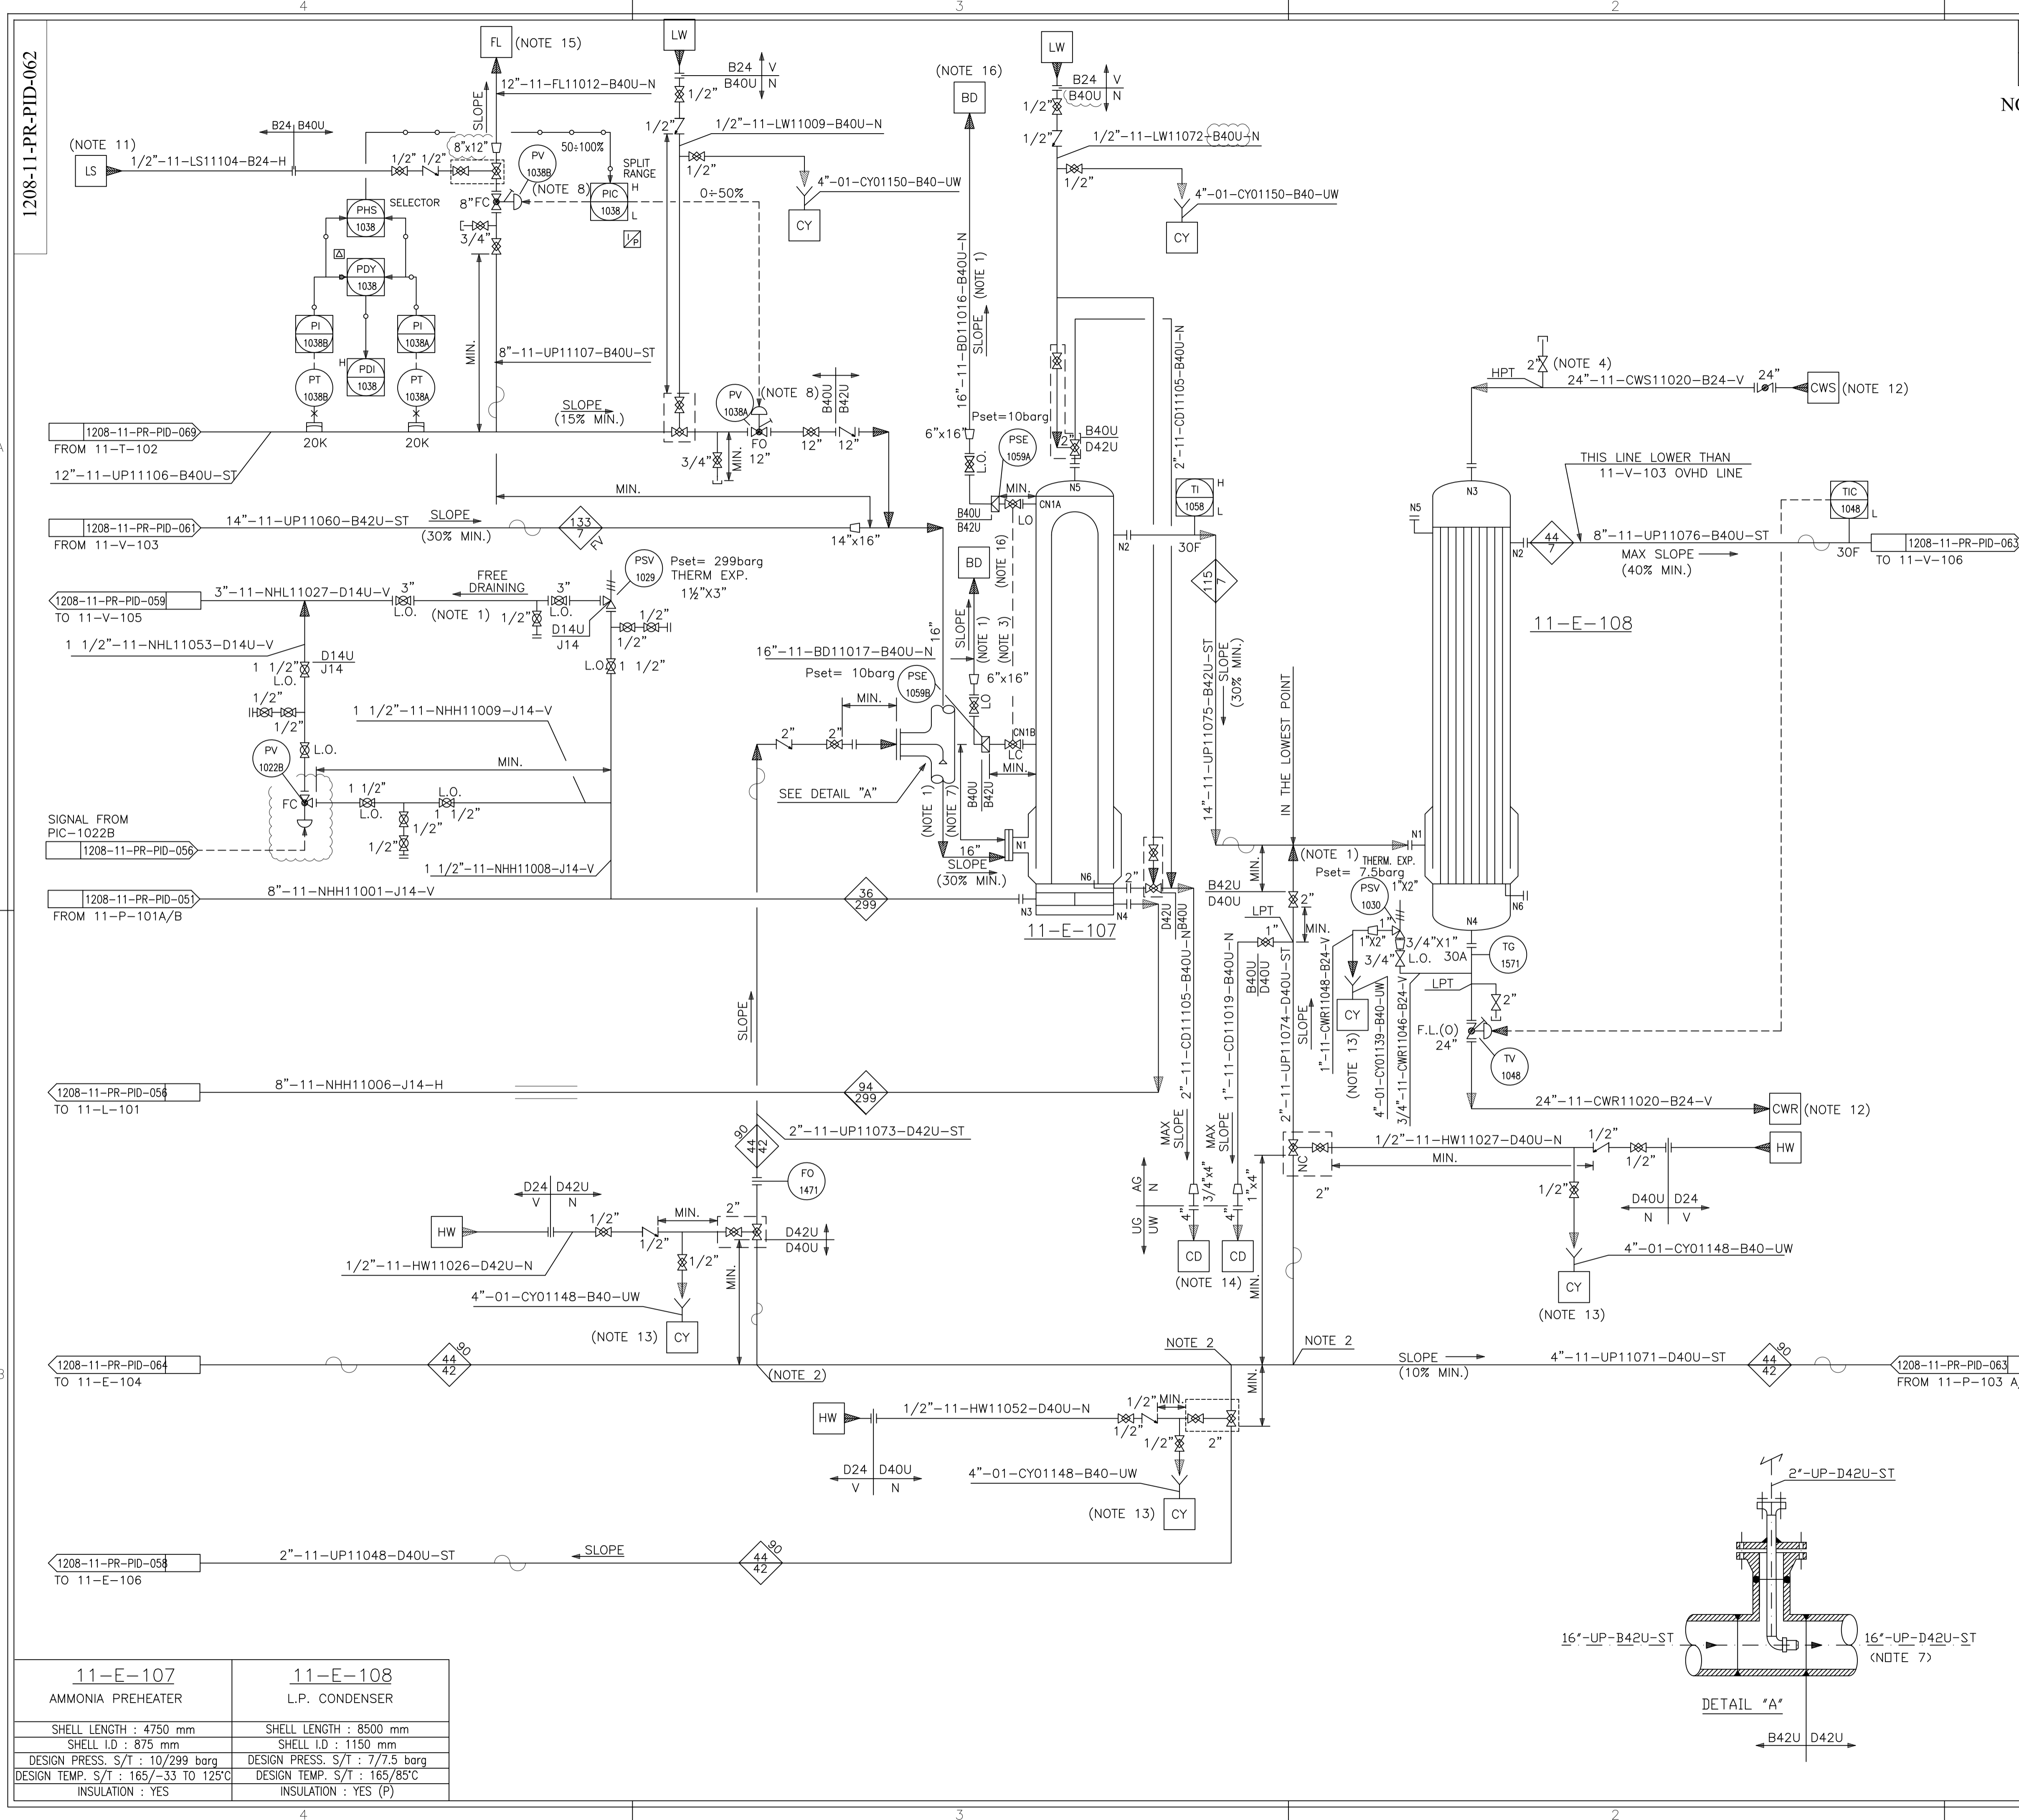

REFERENCE DRAWING	DWG. NO.
SYMBOLS AND IDENTIFICATIONS	1208-01-PR-PID-051-01

- NOTES:**
- 1) PROVIDE TWO PHASES FLOW REINFORCED SUPPORT.
 - 2) TAPPING OF LINES TO BE CLOSE TO LV-1015.
 - 3) RUPTURE DISK BLOCK VALVES MUST BE INTERLOCKED.
 - 4) VENT TO BE ACCESSIBLE
 - 5) PV-1038A AND PV-1038B SHALL BE OPERATED SEPARATELY WHEN THE PRESSURE CONTROLLER IS MANUAL MADE.
 - 6) FULL CONE SPRAYER THE SPRAYER SHALL BE LOCATED CLOSE TO 11-E-107 AND HIGHER THAN 11-E-107 OUTLET LINE. FULL CONE SPRAYER ΔP= 2bar FLOWRATE= 9m³/h. THE SPRAYER SHALL BE REMOVABLE THROUGH THE FLANGE FOR INSPECTION.
 - 7) PROVIDE PIPING WITH HIGHER THICKNESS RATING 300RF AND AISI 316L FOR STRESS AND EROSION PHENOMENA.
 - 8) PV-1038 A/B OPERATE IN SPLIT RANGE AS SHOWN:

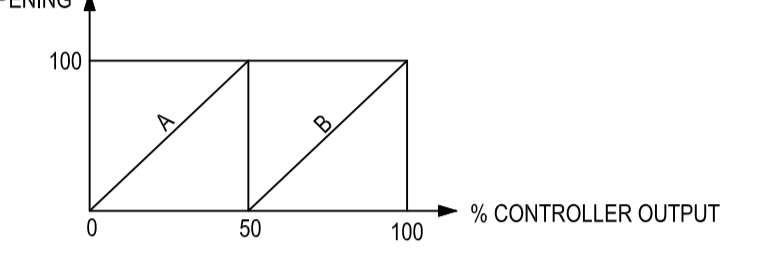

- GENERAL NOTES:**
- 1) FOR SYMBOLS AND OTHER DETAILS PLEASE REFER TO PID 1208-01-PR-PID-051.
 - 2) FOR ALL "CD" LINES THE FLANGES ARE TO BE LOCATED AT MINIMUM DISTANCE FROM GRADE. ALL "CD" LINES SHALL HAVE SLOPE TO ENSURE FREE DRAINING TOWARDS 11-TK-104 TANK.
 - 3) SAFETY AND CONTROL VALVE IN/OUT LINES AND RELATED BYPASS LINE SIZE TO BE VERIFIED DURING ENGINEERING PHASE, AFTER CONTROL VALVES AND SAFETY VALVES SIZES.
 - 4) CONTRACTOR
 - 5) WHERE IT'S INDICATED "MIN" OR "MINIMUM DISTANCE" THE LENGTH OF THE INTERESTED PIPE TO BE KEPT AS SHORT AS POSSIBLE (ABOUT ONE HUNDRED MILLIMETERS) IN ORDER TO PREVENT DEAD ZONE.
 - 6) FOR THE DESCRIPTION OF ATTRIBUTES OF HYDRAULIC CONSTRAINTS OF LINES (SELF DRAINING, SLOPE, GRAVITY FLOW, ETC.) REFER TO DOC. "GENERAL REQUIREMENTS FOR PIPING" WHERE SPECIFIC REQUIREMENTS ARE INDICATED THAT PIPING SHALL FOLLOW. NO EXCEPTIONS ARE ALLOWED.
 - 7) ALL DRIP RINGS MUST BE INSTALLED TO HAVE THE RELEVANT TAPPING IN THE BOTTOM PART (THE LOWEST POINT). NO EXCEPTIONS ARE ALLOWED.
 - 8) ALL CHECK VALVES HAVE TO BE INSTALLED IN VERTICAL POSITION, UNLESS VENDOR DIFFERENT INDICATIONS.
 - 9) MECHANIZATION OF PIPING AND INSTRUMENTATION HAS BEEN PERFORMED ACCORDING WITH LICENSOR'S STANDARDS AS MINIMUM REQUIREMENT AND IT SHALL BE COMPLETED BY ENGINEERING CONTRACTOR.
 - 10) ALL INSTRUMENT IN THIS PAGE HAVE PREFIX NO. OF 11. FOR EXAMPLE 11-PSV-1029.
 - 11) FOR STEAM AND CONDENSATE LINES CONTINUATION REFER TO DWG.: 1208-01-PR-UDD-051.
 - 12) FOR COOLING WATER SUPPLY/RETURN CONTINUATION REFER TO DWG.: 1208-01-PR-UDD-053.
 - 13) FOR CHEMICAL DRAINAGE CONTINUATION REFER TO DWG.: 1208-01-PR-UDD-056.
 - 14) FOR CLOSE DRAINAGE CONTINUATION REFER TO DWG.: 1208-01-PR-UDD-057.
 - 15) FOR COLD FLARE LINES CONTINUATION REFER TO DWG.: 1208-97-SA-PID-014
 - 16) FOR UREA BLOW DOWN NETWORK REFER TO DWG.: 1208-01-SA-UDD-003.

HOLD

- DELETED

- DELETED

EQUIPMENT LIST	
11-E-107	11-E-108

LICENSOR REF. : P53


DE	EXT	AFC	A			
Eng. Phase	Purpose of Distribution (POD)	Purpose of Issue (POI)	Owner's Action			
04	30.12.2023	APPROVED FOR CONSTRUCTION	M.Fahrasi A.Azma A.Azma M.Saromi			
03	29.08.2023	APPROVED FOR CONSTRUCTION	M.Fahrasi A.Azma A.Azma M.Saromi			
02	21.11.2022	APPROVED FOR CONSTRUCTION (WITH HOLD)	M.Fahrasi M.Yazdparah A.Azma M.Saromi			
01	12.06.2018	APPROVED FOR CONSTRUCTION (WITH HOLD)	M.Yazdparah A.Azma A.Azma M.Saromi			
00	13.03.2017	ISSUED FOR ENGINEERING	F.Mizani A.Habibi A.Azma M.Saromi			
REV.	ISSUE DATE	DESCRIPTION	PREPARED BY	CHECKED BY	APPROVED BY	PROJECT
OWNER:	MC:	EPCC CONTRACTOR:				

THIS DOCUMENT IS THE PROPERTY OF HFC. IT IS CONFIDENTIAL AND ALL RIGHTS RESERVED. NEITHER THE WHOLE NOR PART OF THIS DOCUMENT MAY BE DISCLOSED TO ANY THIRD PARTY. REPRODUCED, STORED IN ANY RETRIEVAL SYSTEM OR TRANSMITTED IN ANY FORM OR BY ANY MEANS WITHOUT THE PRIOR WRITTEN CONSENT OF HFC.


PROJECT: HENGAM FERTILIZER PROJECT

TITLE: PIPING AND INSTRUMENTATION DIAGRAM LOW PRESSURE SECTION 2 of 3

SCALE: N.T.S	OWNER PROJECT NO.: NA	DWG. NO.:	REV.:	SIZE:
1 OF 1	PIDEC PROJECT NO.: 1208	1208-11-PR-PID-062	04	A1

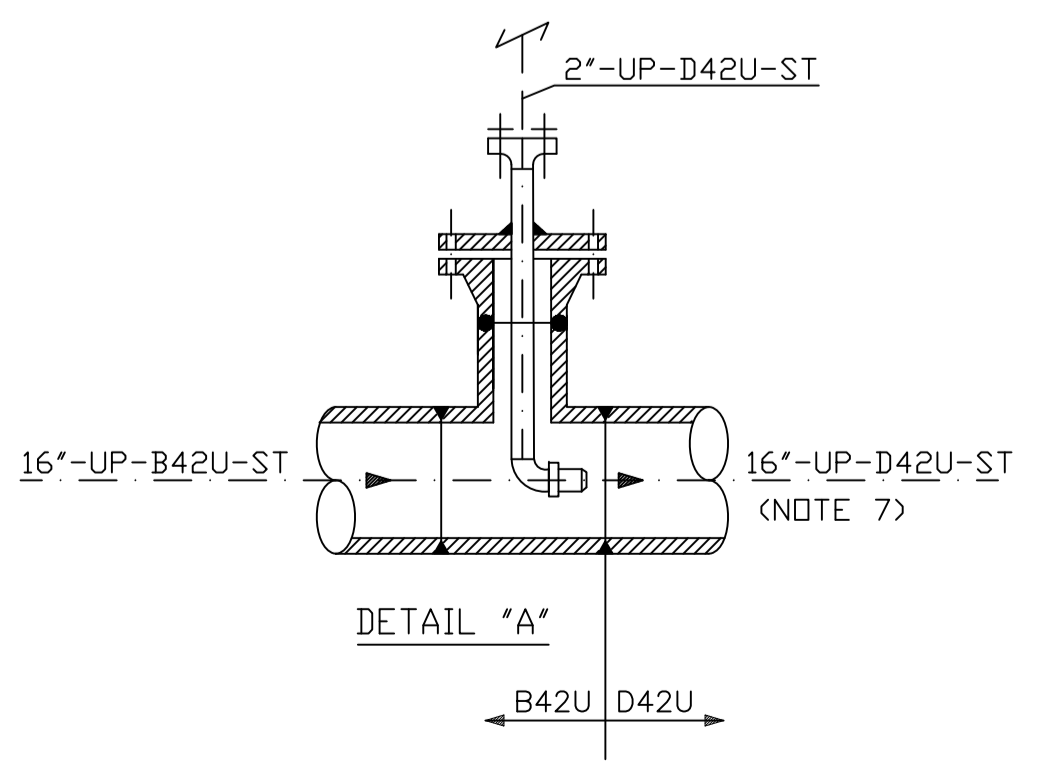


11-E-107	11-E-108
AMMONIA PREHEATER	L.P. CONDENSER
SHELL LENGTH : 4750 mm	SHELL LENGTH : 8500 mm
SHELL I.D. : 875 mm	SHELL I.D. : 1150 mm
DESIGN PRESS. S/T : 10/299 barg	DESIGN PRESS. S/T : 7/7.5 barg
DESIGN TEMP. S/T : 165/-33 TO 125°C	DESIGN TEMP. S/T : 165/85°C
INSULATION : YES	INSULATION : YES (P)

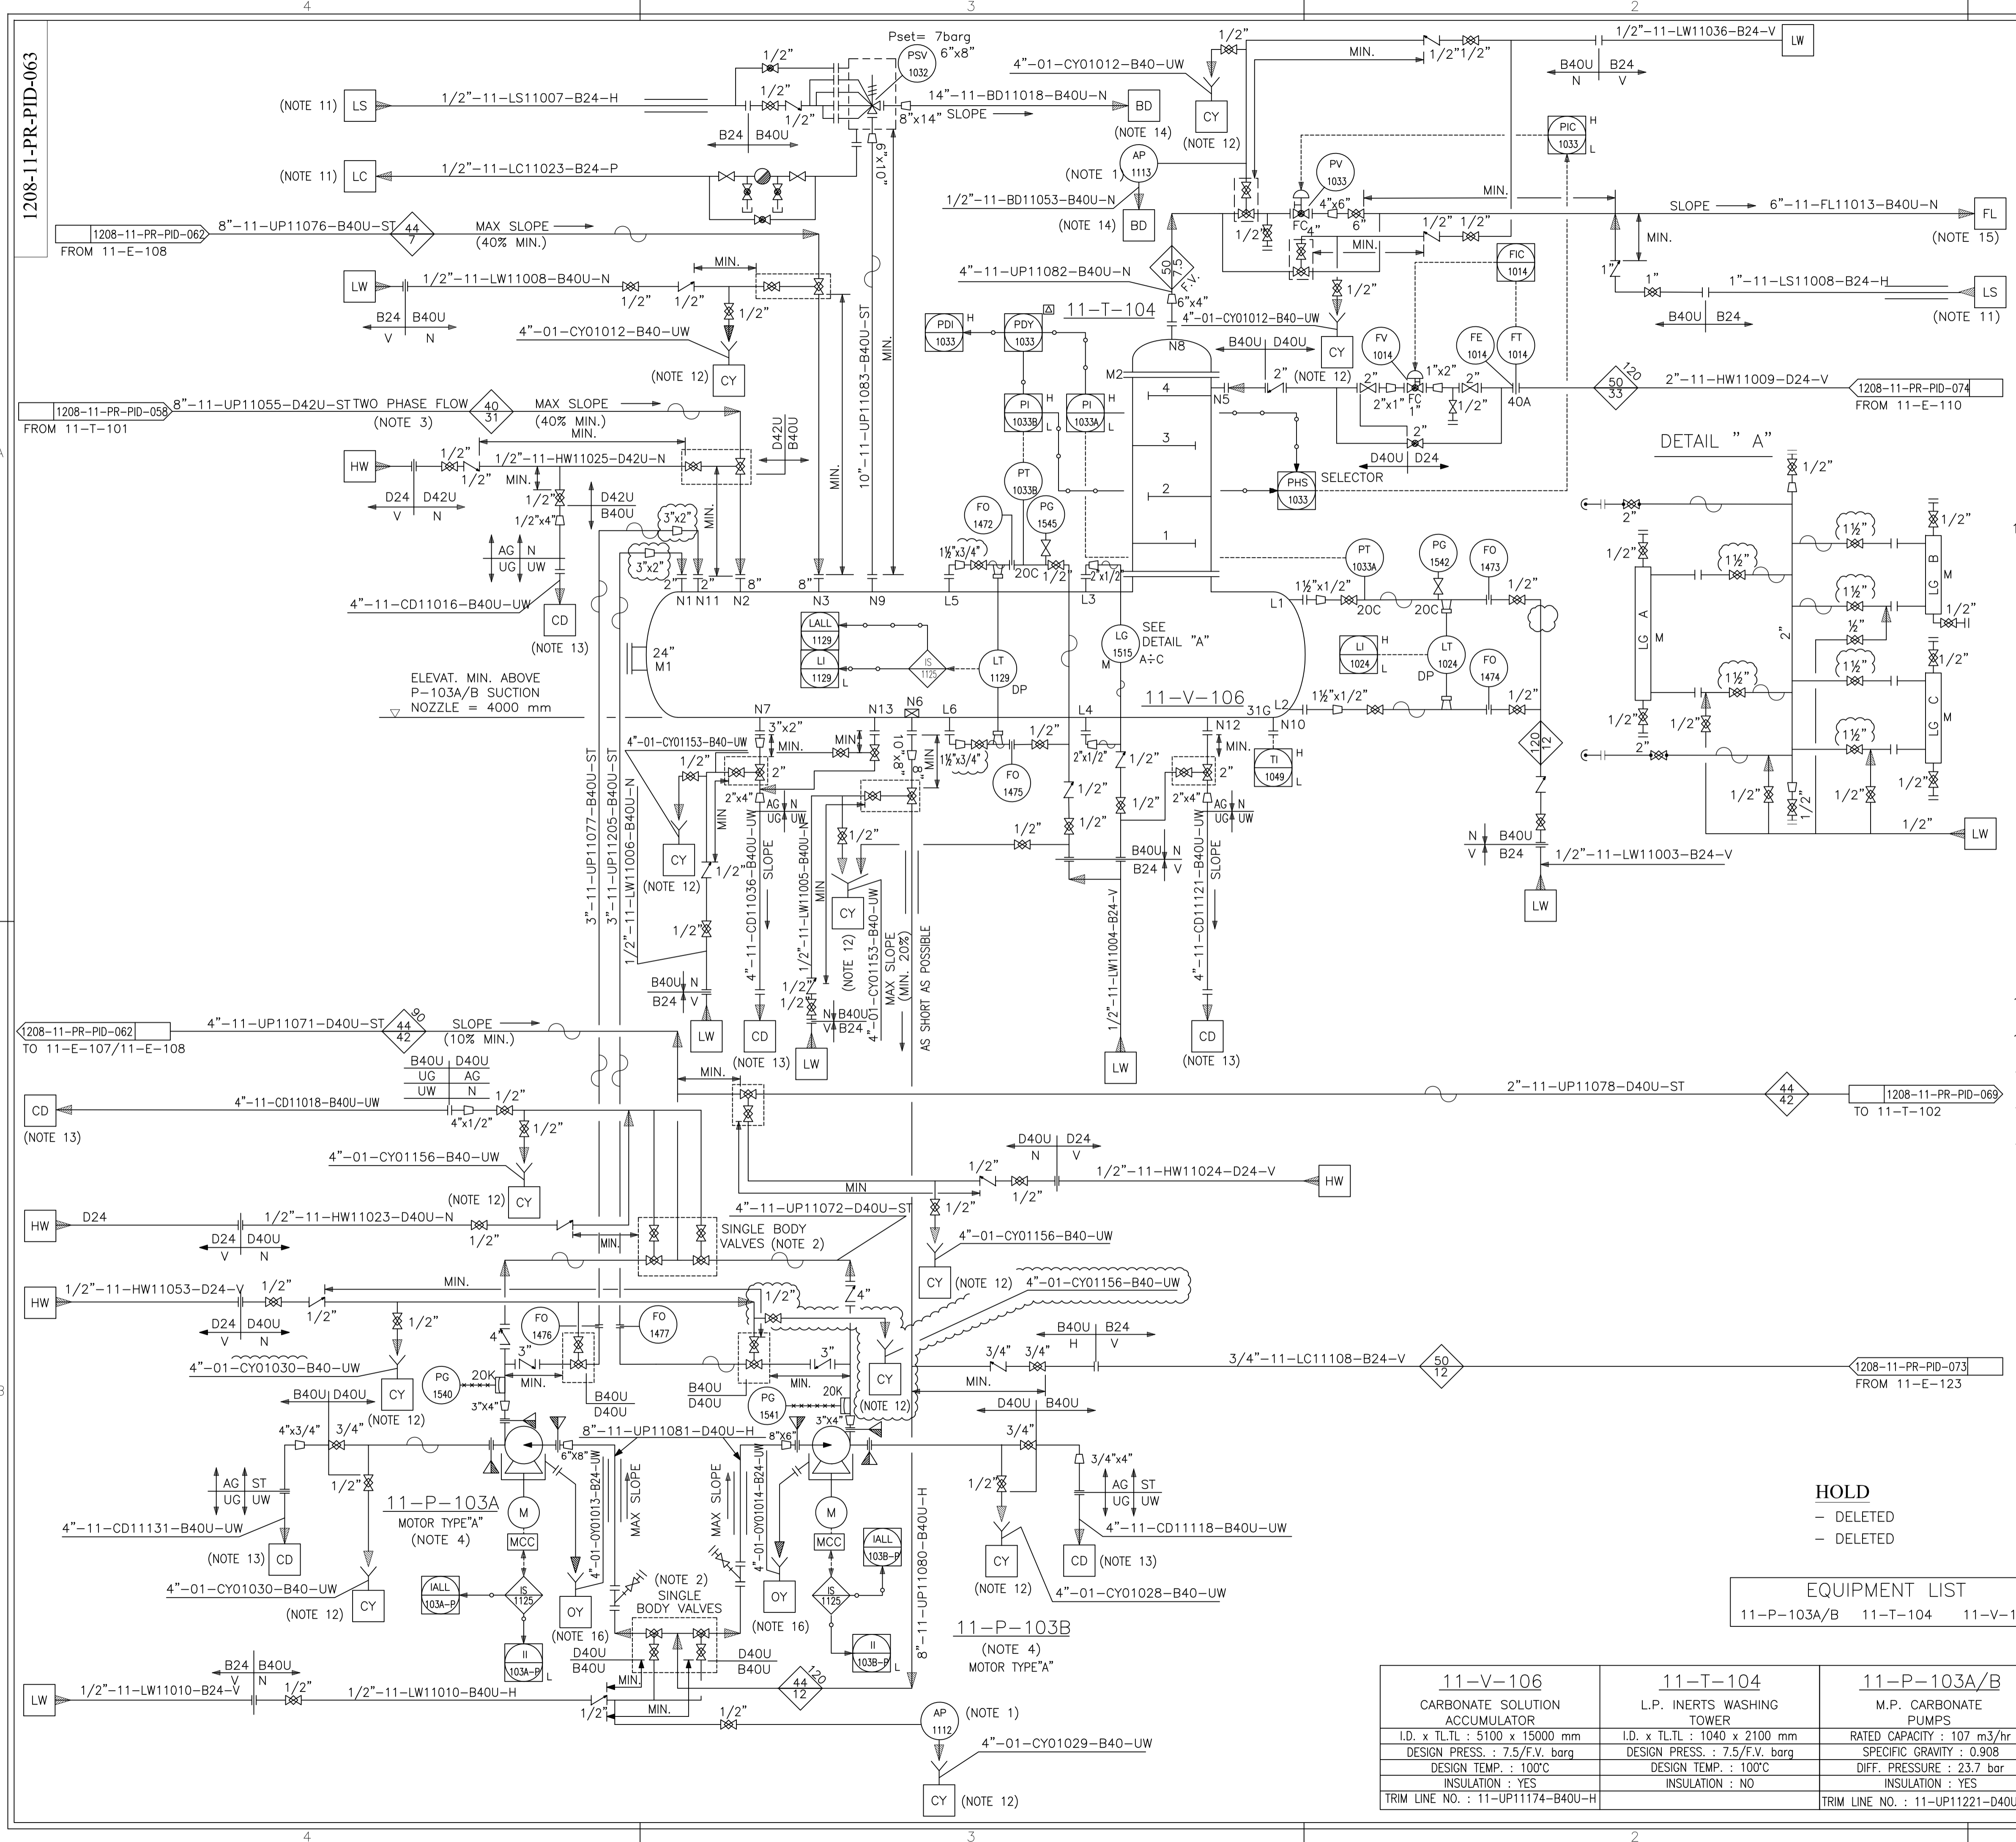

REFERENCE DRAWING	DWG. NO.
SYMBOLS AND IDENTIFICATIONS	1208-01-PR-PID-051-01


- NOTES:**
- 1) FOR SAMPLE CONNECTION DETAIL AND PIPING ARRANGEMENT REFER TO P&ID. 1208-11-PR-PID-080/081.
 - 2) OPERATING POSITION OF VALVES AT 11-P-103A/B SUCTION AND DISCHARGE:

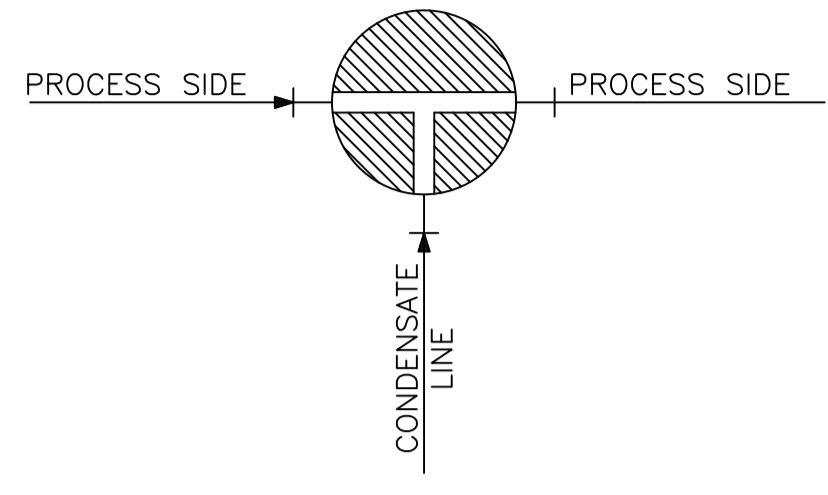

- 3) PROVIDE TWO PHASE FLOW REINFORCED SUPPORT.
- 4) ALL PUMPS CONNECTIONS DEFINED AS PER PUMP MFR SELECTION.

GENERAL NOTES:

- 1) FOR SYMBOLS AND OTHER DETAILS PLEASE REFER TO PID 1208-01-PR-PID-051.
- 2) FOR ALL "CD" LINES THE FLANGES ARE TO BE LOCATED AT MINIMUM DISTANCE FROM GRADE. ALL "CD" LINES SHALL HAVE SLOPE TO ENSURE FREE DRAINING TOWARDS 11-TK-104 TANK.
- 3) SAFETY AND CONTROL VALVE IN/OUT LINES AND RELATED BYPASS LINE SIZE TO BE VERIFIED DURING ENGINEERING PHASE, AFTER CONTROL VALVES AND SAFETY VALVES SELECTION.
- 4) MFR CONTRACTOR
- 5) WHERE IT'S INDICATED "MIN" OR "MINIMUM DISTANCE" THE LENGTH OF THE INTERESTED PIPE TO BE KEPT AS SHORT AS POSSIBLE (ABOUT ONE HUNDRED MILLIMETERS) IN ORDER TO PREVENT DEAD ZONE.
- 6) FOR THE DESCRIPTION OF ATTRIBUTES OF HYDRAULIC CONSTRAINTS OF LINES (SELF DRAINING, SLOPE, GRAVITY FLOW, ETC.) REFER TO DOC. "GENERAL REQUIREMENTS FOR PIPING" WHERE SPECIFIC REQUIREMENTS ARE INDICATED THAT PIPING SHALL FOLLOW. NO EXCEPTIONS ARE ALLOWED.
- 7) ALL DRIP RINGS MUST BE INSTALLED TO HAVE THE RELEVANT TAPPING IN THE BOTTOM PART (THE LOWEST POINT). NO EXCEPTIONS ARE ALLOWED.
- 8) ALL CHECK VALVES HAVE TO BE INSTALLED IN VERTICAL POSITION, UNLESS VENDOR DIFFERENT INDICATIONS.
- 9) MECHANIZATION OF PIPING AND INSTRUMENTATION HAS BEEN PERFORMED ACCORDING WITH LICENSOR'S STANDARDS AS MINIMUM REQUIREMENT AND IT SHALL BE COMPLETED BY ENGINEERING CONTRACTOR.
- 10) ALL INSTRUMENT IN THIS PAGE HAVE PREFIX NO. OF 11. FOR EXAMPLE 11-FV-1014.
- 11) FOR STEAM AND CONDENSATE LINES CONTINUATION REFER TO DWG.: 1208-01-PR-UDD-051.
- 12) FOR CHEMICAL DRAINAGE CONTINUATION REFER TO DWG.: 1208-01-PR-UDD-056.
- 13) FOR CLOSE DRAINAGE CONTINUATION REFER TO DWG.: 1208-01-PR-UDD-057.
- 14) FOR UREA BLOW DOWN NETWORK REFER TO DWG.: 1208-01-SA-UDD-003.
- 15) FOR FLARE CONTINUATION REFER TO DWG.: 1208-97-SA-PID-014.
- 16) FOR OILY WATER DRAINAGE CONTINUATION REFER TO DWG.: 1208-01-PR-UDD-055.

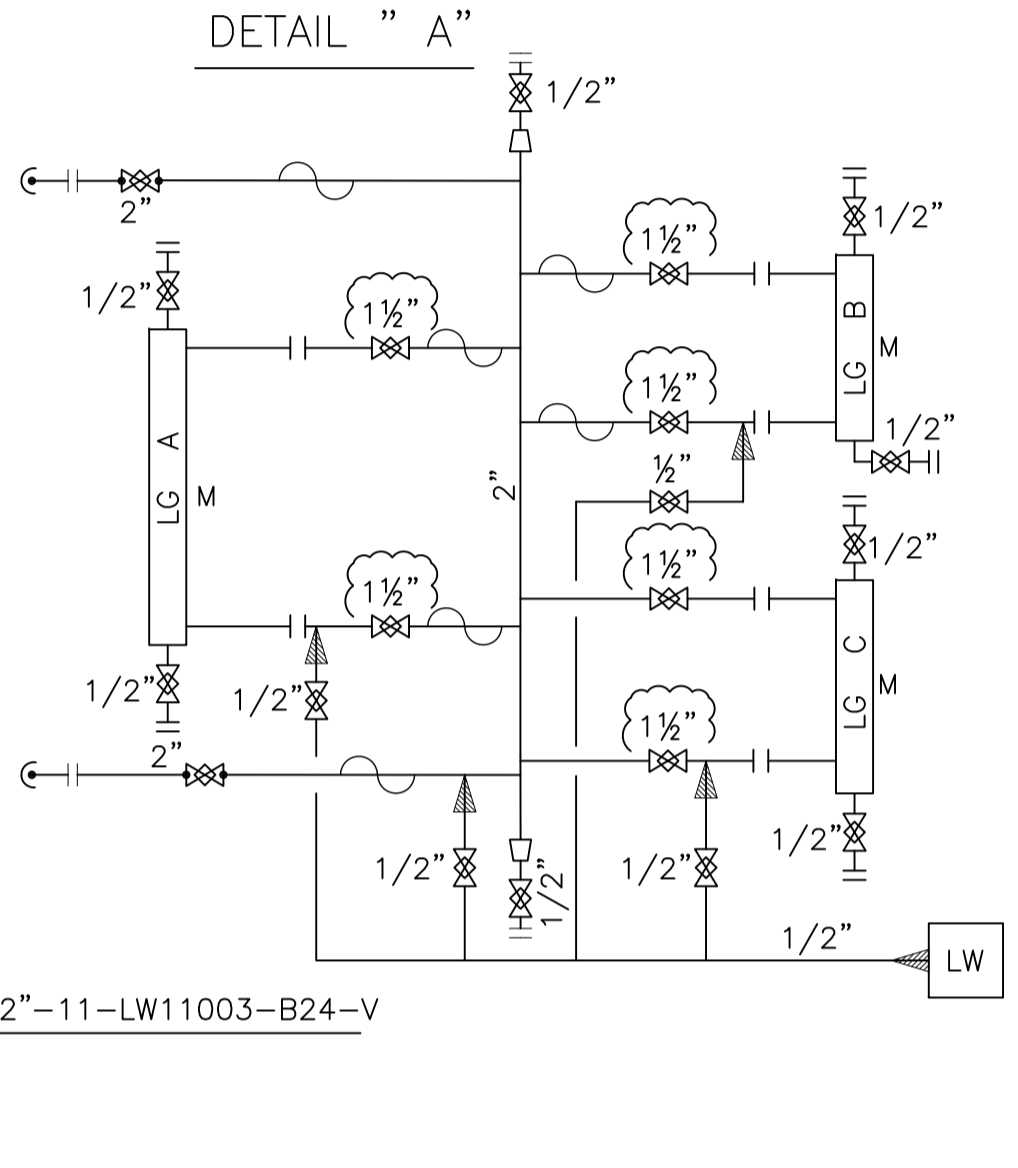

HOLD
- DELETED
- DELETED

EQUIPMENT LIST

11-V-106	11-T-104	11-P-103A/B
CARBONATE SOLUTION ACCUMULATOR	L.P. INERTS WASHING TOWER	M.P. CARBONATE PUMPS
I.D. x T.L.T.L : 5100 x 15000 mm	I.D. x T.L.T.L : 1040 x 2100 mm	RATED CAPACITY : 107 m3/hr
DESIGN PRESS. : 7.5/F.V. barg	DESIGN PRESS. : 7.5/F.V. barg	SPECIFIC GRAVITY : 0.908
DESIGN TEMP. : 100°C	DESIGN TEMP. : 100°C	DIFF. PRESSURE : 23.7 bar
INSULATION : YES	INSULATION : NO	INSULATION : YES
TRIM LINE NO. : 11-UP11174-B40U-H		TRIM LINE NO. : 11-UP11221-D40U-ST

LICENSOR REF. : P54

DE	EXT	AFC	A
Eng. Phase	Purpose of Distribution (POD)	Purpose of Issue (POI)	Owner's Action
04	31.12.2023	APPROVED FOR CONSTRUCTION	M.Fahrasi A.Azma A.Azma M.Sarimi
03	29.08.2023	APPROVED FOR CONSTRUCTION	M.Fahrasi A.Azma A.Azma M.Sarimi
02	20.11.2022	APPROVED FOR CONSTRUCTION (WITH HOLD)	M.Fahrasi M.Yadegarpanahi A.Azma M.Sarimi
01	12.06.2018	APPROVED FOR CONSTRUCTION (WITH HOLD)	M.Yadegarpanahi A.Azma A.Azma M.Sarimi
00	04.04.2017	ISSUED FOR ENGINEERING	F.Mizaki A.Habibi A.Azma M.Sarimi

REV.	ISSUE DATE	DESCRIPTION	PREPARED BY	CHECKED BY	APPROVED BY	PROJECT

OWNER:


MC:

EPCC CONTRACTOR:

PROJECT: HENGAM FERTILIZER PROJECT


TITLE: PIPING AND INSTRUMENTATION DIAGRAM
LOW PRESSURE SECTION 3 of 3

SCALE : N.T.S	OWNER PROJECT NO. : NA	DWG. NO. :	REV. :	SIZE :
1 OF 1	PIDEC PROJECT NO. : 1208	1208-11-PR-PID-063	04	A1

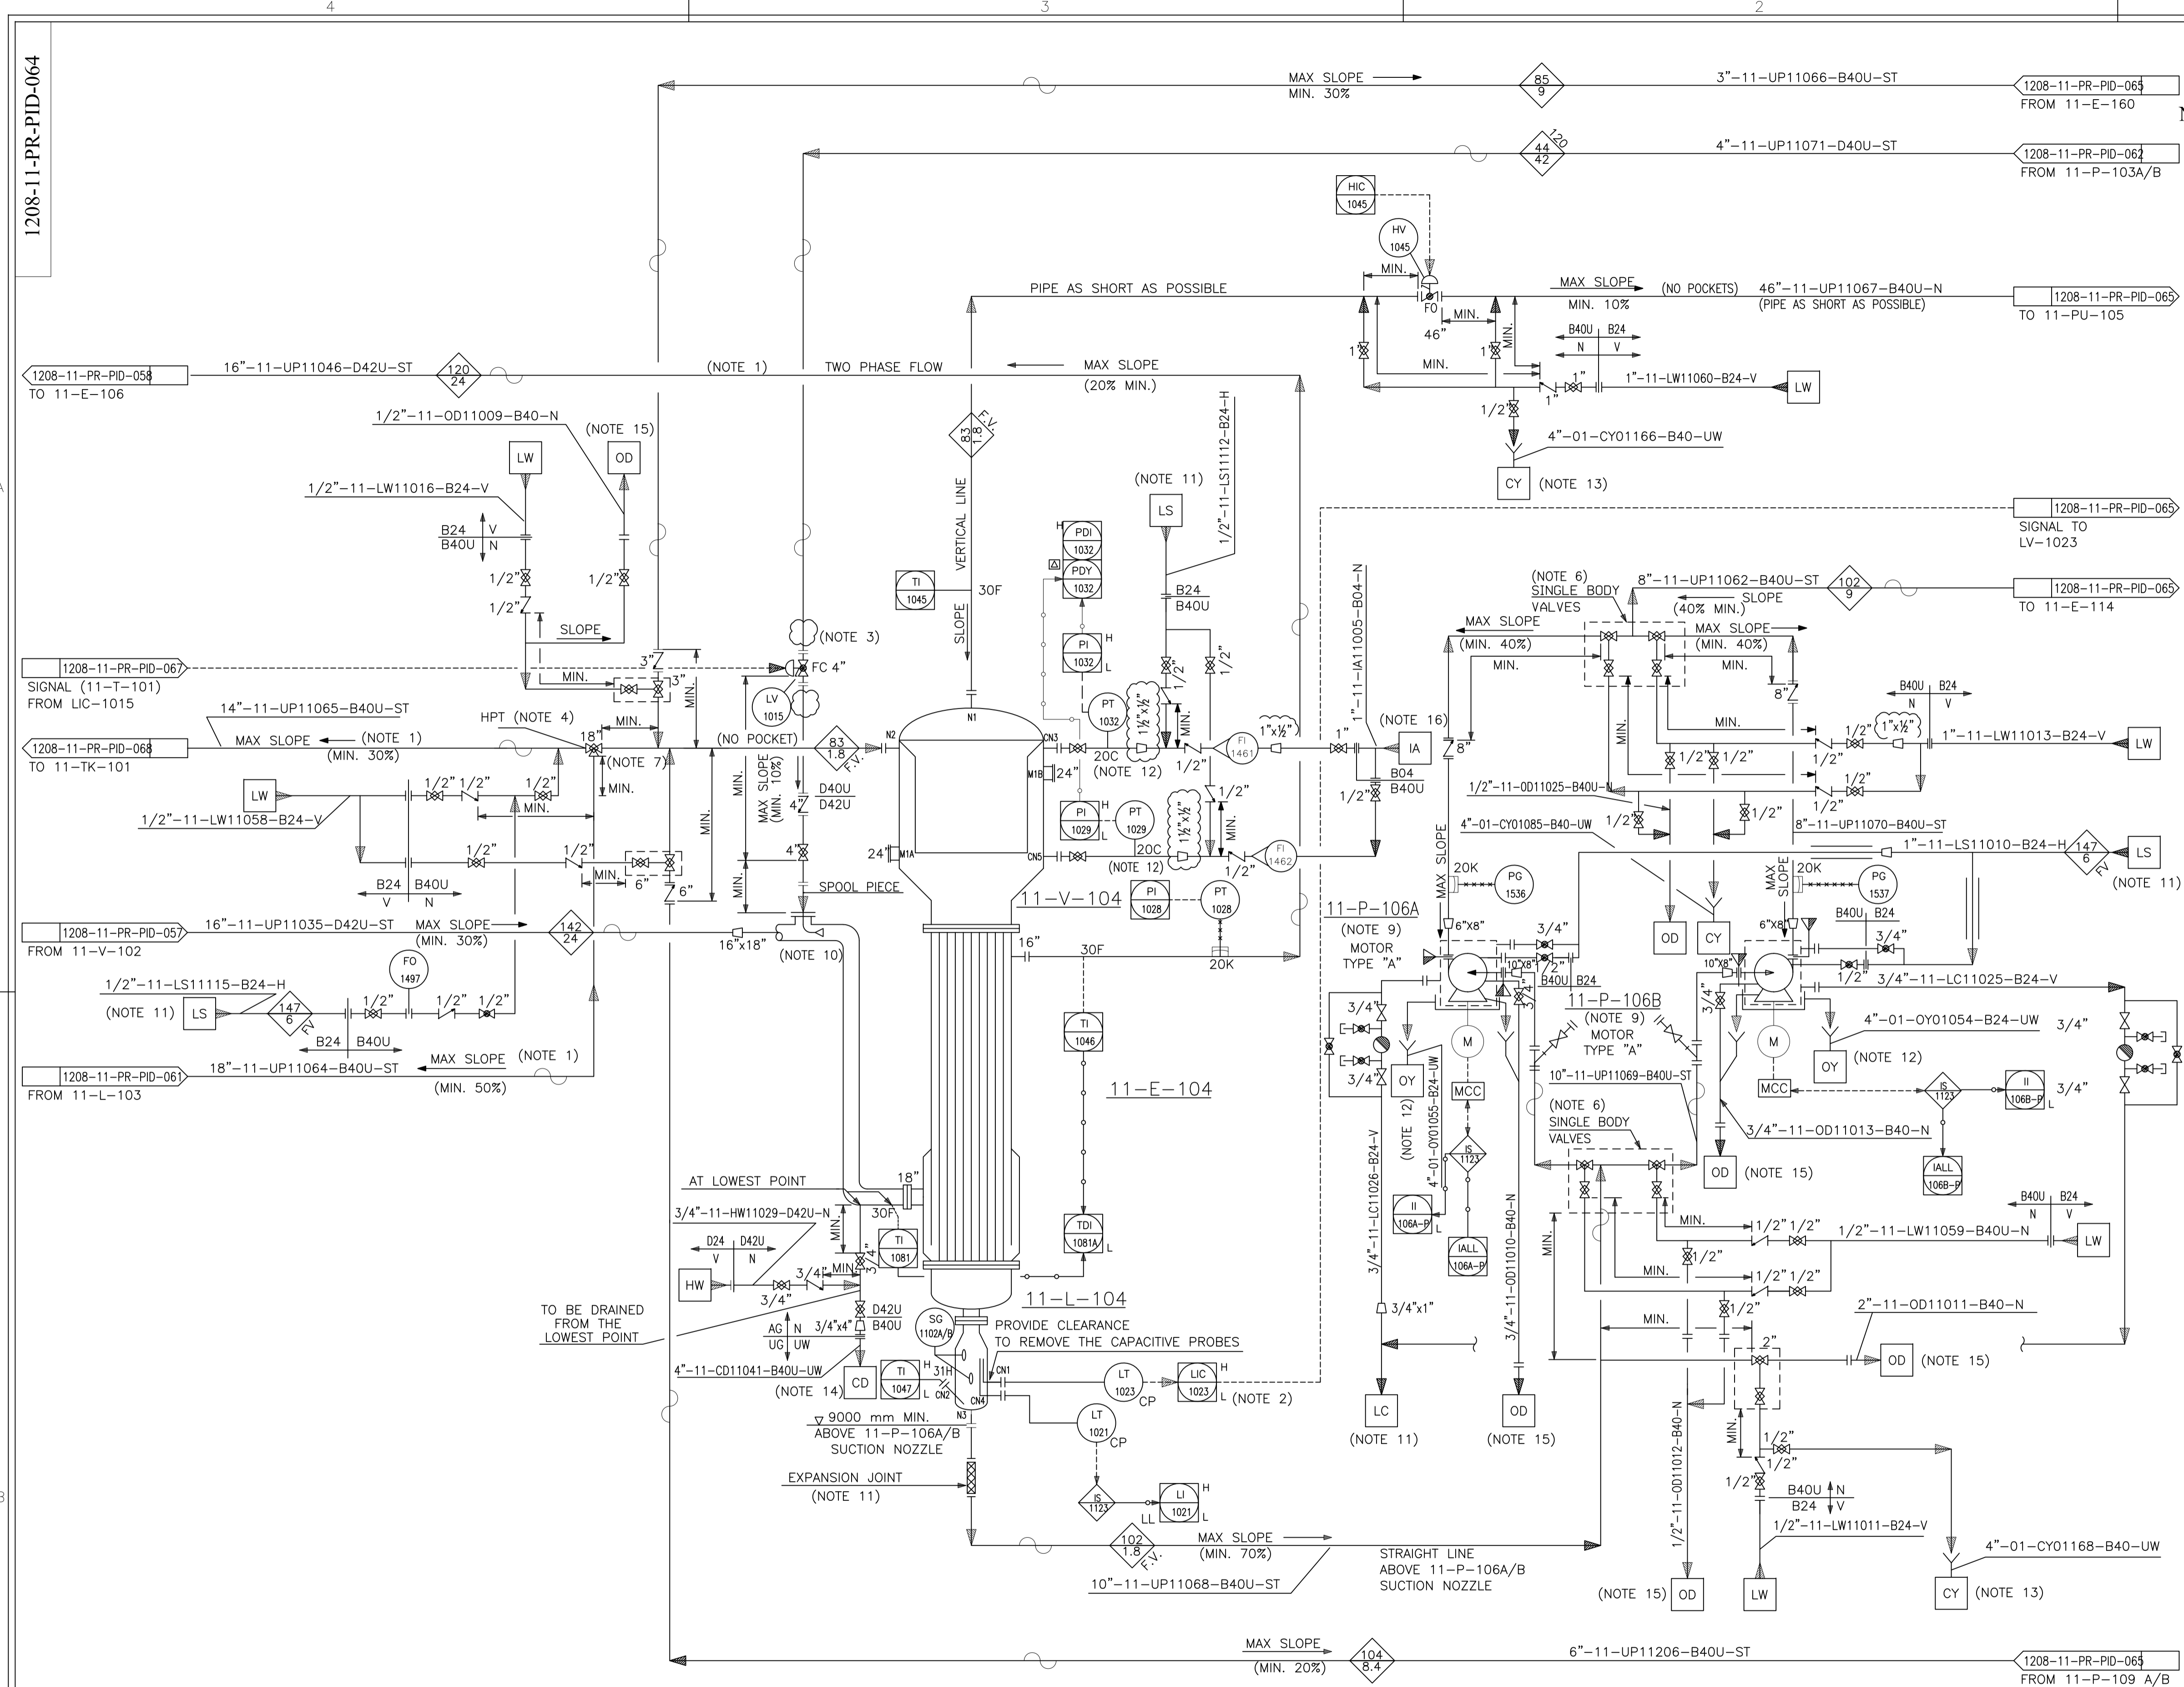

REFERENCE DRAWING	DWG. NO.
SYMBOLS AND IDENTIFICATIONS	1208-01-PR-PID-051-01

- NOTES:**
- 1) PROVIDE TWO PHASES FLOW REINFORCED SUPPORT.
 - 2) LIC-1023 OUTPUT SHALL BE FORCED TO 0% IN CASE OF IS-1123 ACTIVATION.
 - 3) TO BE INSTALLED AT HIGHEST POINT.
 - 4) TAPPING POINT FOR 11-P-109A/B RECYCLE LINE FROM TOP.
 - 5) TO BE SUPPLIED BY EQUIPMENT MFR.
 - 6) OPERATING POSITION OF VALVES WITH INCORPORATED WASHING CONNECTION AT 11-P-106A/B SUCTION AND DISCHARGE.

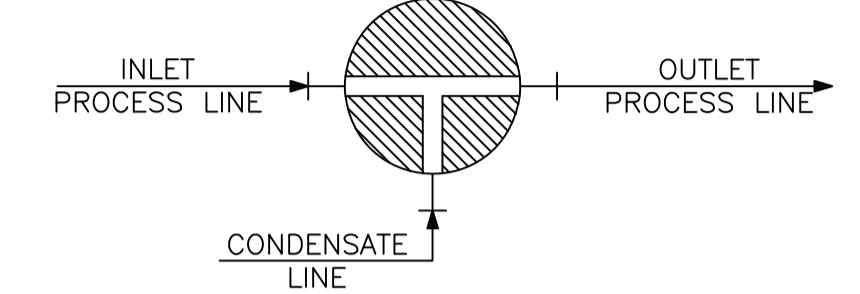

- 7) TO BE LOCATED AT ABOUT 1m FROM 11-V-104. INLET PLUG SHALL BE ORIENTED SO THAT 11-V-104 AND TK-101 CANNOT BE IN CONNECTION.
- 8) FOR ALL "OD" LINES THE FLANGES ARE TO BE LOCATED AT MINIMUM DISTANCE FROM GRADE. ALL "OD" LINES SHALL HAVE SLOPE TO ENSURE FREE DRAINING.
- 9) ALL PUMPS CONNECTIONS DEFINED AS PER PUMP MFR SELECTION.
- 10) THE SPRAYER SHALL BE LOCATED CLOSE TO 11-E-104 AND HIGHER THAN 11-E-104 OUTLET LINE FULL CONE SPRAYER ΔP=2 bar FLOWRATE=68 m3/hr THE SPRAYER SHALL BE REMOVABLE THROUGH THE FLANGE FOR MAINTENANCE PURPOSE.
- 11) EXPANSION JOINT TO BE DESIGNED ACCORDING TO PROCESS CONDITION WITHOUT INTERNAL SLEEVE.
- 12) PT-1029 AND PT-1032 INSTALLATION TO BE LOCATED ON 11-V-104 TOP PLATFORM ENSURING TUBING IN SLOPE TOWARDS RELATED VESSEL NOZZLES CONNECTIONS.

- GENERAL NOTES:**
- 1) FOR SYMBOLS AND OTHER DETAILS PLEASE REFER TO PID 1208-01-PR-PID-051.
 - 2) FOR ALL "CD" LINES THE FLANGES ARE TO BE LOCATED AT MINIMUM DISTANCE FROM GRADE. ALL "CD" LINES SHALL HAVE SLOPE TO ENSURE FREE DRAINING TOWARDS 11-TK-104 TANK.
 - 3) SAFETY AND CONTROL VALVE IN/OUT LINES AND RELATED BYPASS LINE SIZE TO BE VERIFIED DURING ENGINEERING PHASE, AFTER CONTROL VALVES AND SAFETY VALVES SELECTION.
 - 4) CONTRACTOR
 - 5) WHERE IT'S INDICATED "MIN" OR "MINIMUM DISTANCE" THE LENGTH OF THE INTERESTED PIPE TO BE KEPT AS SHORT AS POSSIBLE (ABOUT ONE HUNDRED MILLIMETERS) IN ORDER TO PREVENT DEAD ZONE.
 - 6) FOR THE DESCRIPTION OF ATTRIBUTES OF HYDRAULIC CONSTRAINTS OF LINES (SELF DRAINING, SLOPE, GRAVITY FLOW, ETC.) REFER TO DOC. "GENERAL REQUIREMENTS FOR PIPING" WHERE SPECIFIC REQUIREMENTS ARE INDICATED THAT PIPING SHALL FOLLOW. NO EXCEPTIONS ARE ALLOWED.
 - 7) ALL DRIP RINGS MUST BE INSTALLED TO HAVE THE RELEVANT TAPPING IN THE BOTTOM PART (THE LOWEST POINT). NO EXCEPTIONS ARE ALLOWED.
 - 8) ALL CHECK VALVES HAVE TO BE INSTALLED IN VERTICAL POSITION, UNLESS VENDOR DIFFERENT INDICATIONS.
 - 9) MECHANIZATION OF PIPING AND INSTRUMENTATION HAS BEEN PERFORMED ACCORDING WITH LICENSOR'S STANDARDS AS MINIMUM REQUIREMENT AND IT SHALL BE COMPLETED BY ENGINEERING CONTRACTOR.

11-V-104	11-E-104	11-L-104	11-P-106A/B
VACUUM PRECONCENTRATOR SEPARATOR	VACUUM PRECONCENTRATOR	VACUUM PRECONCENTRATOR HOLDER	UREA SOLUTION PUMPS
I.D. x T.L.T.L : 4500 x 3200 mm	SHELL LENGTH : 4000 mm	I.D. x T.L.T.L : 1500 x 1600 mm	RATED CAPACITY : 180 m3/hr
DESIGN PRESS. : 1.8/F.V. barg	SHELL I.D. : 3300 mm	DESIGN PRESS. : 1.8/F.V. barg	SPECIFIC GRAVITY : 1.195
DESIGN TEMP. : 135°C	DESIGN PRESS. S/T : 24/1.8 & F.V. barg	DESIGN TEMP. : 135°C	DIFF. PRESSURE : 5 bar
INSULATION : YES	DESIGN TEMP. S/T : 165/140°C	INSULATION : YES	INSULATION : YES
	INSULATION : YES	TRIM LINE NO. : 11-UP11173-B40U-ST	TRIM LINE NO. : 11-UP11225-B40U-ST

- 10) ALL INSTRUMENT IN THIS PAGE HAVE PREFIX NO. OF 11. FOR EXAMPLE 11-HV-1045.
- 11) FOR STEAM AND CONDENSATE LINES CONTINUATION REFER TO DWG.: 1208-01-PR-UDD-051.
- 12) FOR OILY WATER DRAINAGE CONTINUATION REFER TO DWG.: 1208-01-PR-UDD-055.
- 13) FOR CHEMICAL DRAINAGE CONTINUATION REFER TO TO DWG.: 1208-01-PR-UDD-056.
- 14) FOR CLOSE DRAINAGE CONTINUATION REFER TO DWG.: 1208-01-PR-UDD-057.
- 15) FOR OPEN DRAINAGE CONTINUATION REFER TO DWG.: 1208-01-PR-UDD-058.
- 16) FOR INSTRUMENT AIR CONTINUATION REFER TO DWG.: 1208-01-PR-UDD-052.

HOLD
- DELETED

EQUIPMENT LIST

11-E-104	11-P-106A/B
11-L-104	11-V-104

LICENSOR REF. : P52

DE	EXT	AFC	A
Eng. Phase	Purpose of Distribution (POD)	Purpose of Issue (POI)	Owner's Action
04	01.01.2024	APPROVED FOR CONSTRUCTION	M.Fahrasi A.Azma A.Azma M.Saromi
03	26.08.2023	APPROVED FOR CONSTRUCTION	M.Fahrasi A.Azma A.Azma M.Saromi
02	21.11.2022	APPROVED FOR CONSTRUCTION (WITH HOLD)	M.Fahrasi M.Yadavparahni A.Azma M.Saromi
01	12.06.2018	APPROVED FOR CONSTRUCTION (WITH HOLD)	M.Yadavparahni A.Azma A.Azma M.Saromi
00	04.04.2017	ISSUED FOR ENGINEERING	F.Mizaki A.Habibi A.Azma M.Saromi

REV.	ISSUE DATE	DESCRIPTION	PREPARED BY	CHECKED BY	APPROVED BY	PROJECT

OWNER:

MC:

EPCC CONTRACTOR:

PROJECT: **HENGAM FERTILIZER PROJECT**

TITLE: **PIPING AND INSTRUMENTATION DIAGRAM VACUUM EVAPORATION SECTION 1 of 5**

SCALE: N.T.S	OWNER PROJECT NO.: NA	DWG. NO.:	REV.:	SIZE:
1/1	PIDEC PROJECT NO.: 1208	1208-11-PR-PID-064	04	A1

REFERENCE DRAWING	DWG. NO.
SYMBOLS AND IDENTIFICATIONS	1208-01-PR-PID-051-01

NOTES:

- 1) AS VERTICAL AS POSSIBLE FROM THE CONNECTION TO THE GRADE.
- 2) PART OF LINE NOT JACKETED TO BE STEAM TRACED IF MORE THAN 500mm.
- 3) P-108A/B SUCTION /RECYCLE LINE: THE THICKNESS OF THE JACKETED STRAIGHT TUBE MUST BE SIZED CONSIDERING AN EXTERNAL PRESSURE OF 6.0 bar(g) AND FULL VACUUM INSIDE.
- 4) TO BE INSTALLED ON VERTICAL POSITION.
- 5) FOR SAMPLE CONNECTION DETAILS AND PIPING ARRANGEMENT REFER TO P&ID. 1208-11-PR-PID-080 AND 1208-11-PR-PID-081.
- 6) EXPANSION JOINT TO BE DESIGNED ACCORDING TO PROCESS CONDITION WITHOUT INTERNAL SLEEVE.
- 7) PT-1043A/B TRANSMITTERS INSTALLATION TO BE LOCATED ON 11-V-114 TOP PLATFORM ENSURING TUBING IN SLOPE TOWARDS RELATED VESSEL NOZZLES CONNECTIONS.
- 8) EXPANSION JOINT IF NECESSARY ACCORDING TO STRESS ANALYSIS.
- 9) TO BE CONNECTED TO NEAREST CY FUNNEL.
- 10) STEAM TRACING SHALL BE AVOIDED AROUND FLOW METER FT-1037 BODY.
- 11) DELETED.
- 12) T.T.L. OF 11-V-125 TO BE LOWER THAN BOTTOM TUBESHEET OF 11-E-114.

GENERAL NOTES:

- 1) FOR SYMBOLS AND OTHER DETAILS PLEASE REFER TO PID 1208-01-PR-PID-051.
- 2) FOR ALL "CD" LINES THE FLANGES ARE TO BE LOCATED AT MINIMUM DISTANCE FROM GRADE. ALL "CD" LINES SHALL HAVE SLOPE TO ENSURE FREE DRAINING TOWARDS 11-TK-104 TANK.
- 3) SAFETY AND CONTROL VALVE IN/OUT LINES AND RELATED BYPASS LINE SIZE TO BE VERIFIED DURING ENGINEERING PHASE, AFTER CONTROL VALVES AND SAFETY VALVES SELECTION.
- 4) CONTRACTOR
- 5) WHERE IT'S INDICATED "MIN" OR "MINIMUM DISTANCE" THE LENGTH OF THE INTERESTED PIPE TO BE KEPT AS SHORT AS POSSIBLE (ABOUT ONE HUNDRED MILLIMETERS) IN ORDER TO PREVENT DEAD ZONE.
- 6) FOR THE DESCRIPTION OF ATTRIBUTES OF HYDRAULIC CONSTRAINTS OF LINES (SELF DRAINING, SLOPE, GRAVITY FLOW, ETC.) REFER TO DOC. "GENERAL REQUIREMENTS FOR PIPING" WHERE SPECIFIC REQUIREMENTS ARE INDICATED THAT PIPING SHALL FOLLOW. NO EXCEPTIONS ARE ALLOWED.
- 7) ALL DRIP RINGS MUST BE INSTALLED TO HAVE THE RELEVANT TAPPING IN THE BOTTOM PART (THE LOWEST POINT). NO EXCEPTIONS ARE ALLOWED.
- 8) ALL CHECK VALVES HAVE TO BE INSTALLED IN VERTICAL POSITION, UNLESS VENDOR DIFFERENT INDICATIONS.
- 9) MECHANIZATION OF PIPING AND INSTRUMENTATION HAS BEEN PERFORMED ACCORDING WITH LICENSOR'S STANDARDS AS MINIMUM REQUIREMENT AND IT SHALL BE COMPLETED BY ENGINEERING CONTRACTOR.
- 10) ALL "OD" LINES SHALL HAVE MAX SLOPE TOWARDS GROUND LEVEL. "OD" UNDERGROUND HEADER SHALL HAVE SLOPE TO ENSURE FREE DRAINING TOWARDS 18-TK-153 TANK.
- 11) ALL INSTRUMENT IN THIS PAGE HAVE PRIFIX NO. OF 11. FOR EXAMPLE 11-FI-1501.

HOLD
- DELETED

EQUIPMENT LIST			
11-E-114	11-E-160	11-L-114	
11-V-114	11-V-125		

LICENSOR REF. : P55

DE	EXT	AFC	A
Eng Phase	Purpose of Distribution (POD)	Purpose of Issue (POI)	Owner's Action

REV.	DATE	DESCRIPTION	PREPARED BY	CHECKED BY	APPROVED BY	PROJECT
03	26.08.2023	APPROVED FOR CONSTRUCTION	M.Fakhrai	A.Azma	A.Azma	M.Saremi
02	21.11.2022	APPROVED FOR CONSTRUCTION (WITH HOLD)	M.Fakhrai	M.Yasarpour	A.Azma	M.Saremi
01	12.06.2018	APPROVED FOR CONSTRUCTION (WITH HOLD)	M.Yasarpour	A.Azma	A.Azma	M.Saremi
00	04.04.2017	ISSUED FOR ENGINEERING	F.Mirzaei	A.Habibi	A.Azma	M.Saremi

OWNER:


MC:

EPC CONTRACTOR:

PROJECT: HENGAM FERTILIZER PROJECT

PIPING AND INSTRUMENTATION DIAGRAM
VACUUM EVAPORATION SECTION 2 of 5


SCALE: N.T.S	OWNER PROJECT NO.: NA	DWG. NO.:	REV.:	SIZE:
SHT.: 1 OF 1	PIDEC PROJECT NO.: 1208	1208-11-PR-PID-065	03	A1

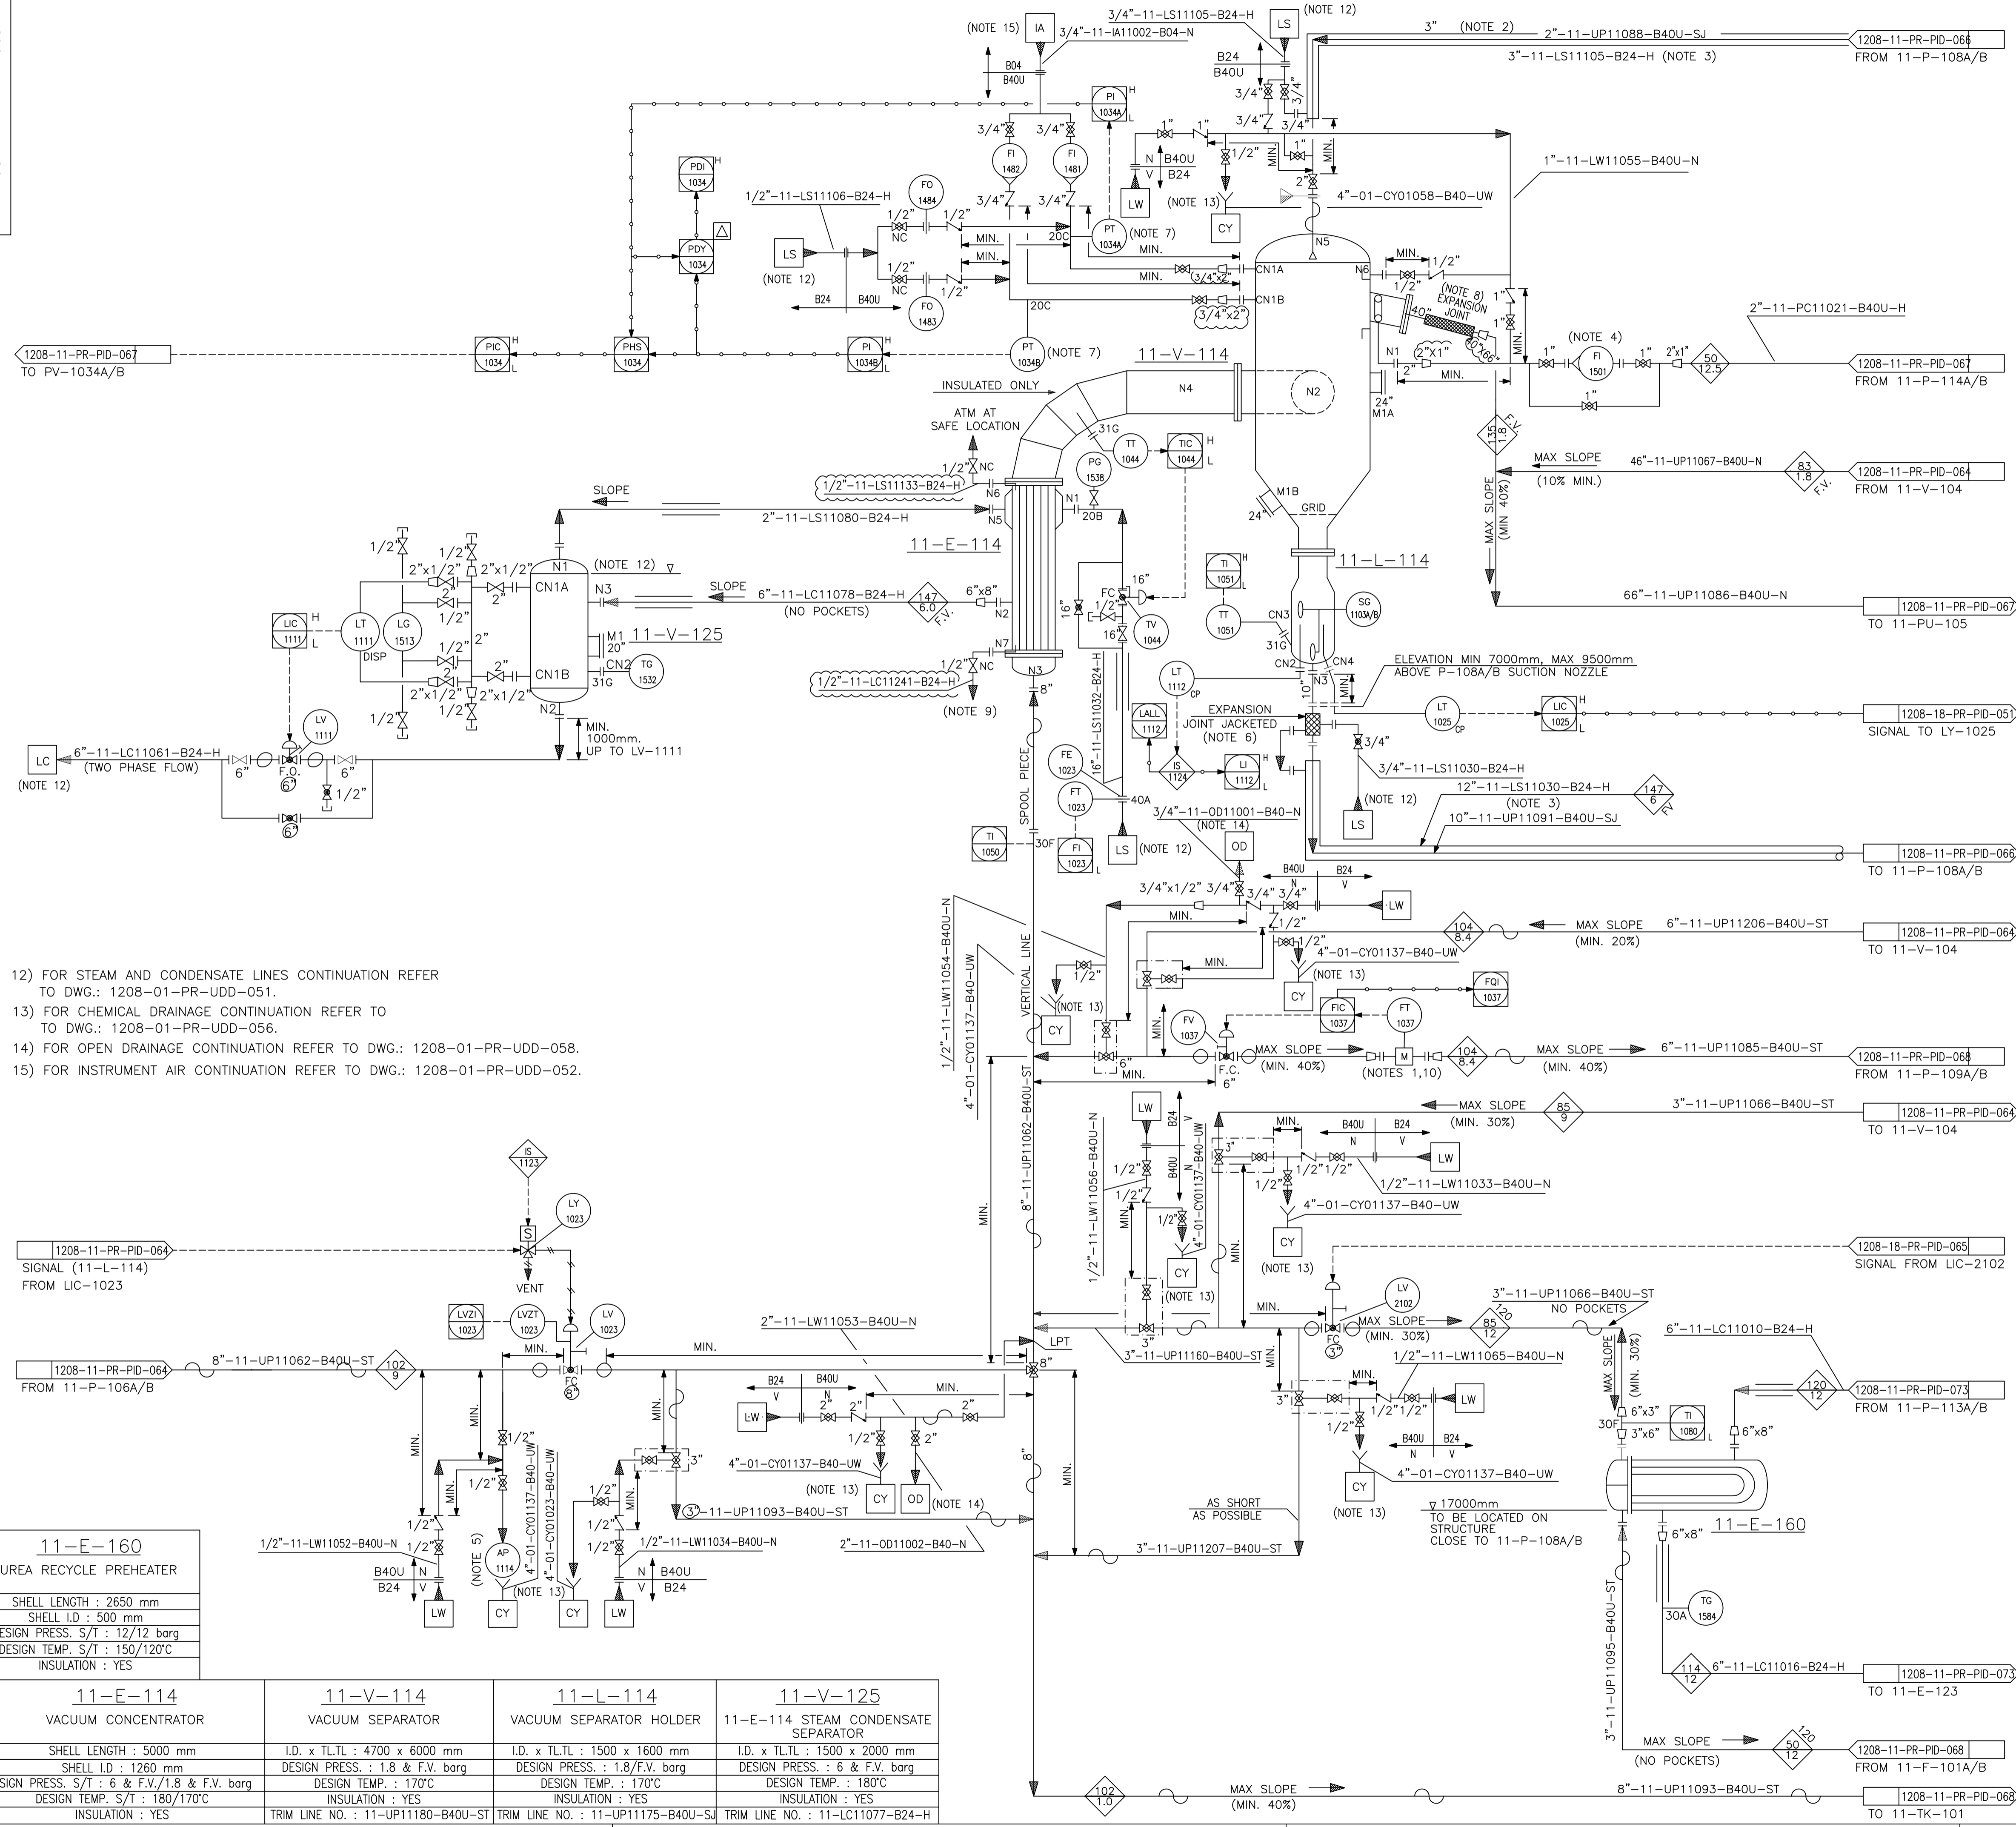


- 12) FOR STEAM AND CONDENSATE LINES CONTINUATION REFER TO DWG.: 1208-01-PR-UDD-051.
- 13) FOR CHEMICAL DRAINAGE CONTINUATION REFER TO DWG.: 1208-01-PR-UDD-056.
- 14) FOR OPEN DRAINAGE CONTINUATION REFER TO DWG.: 1208-01-PR-UDD-058.
- 15) FOR INSTRUMENT AIR CONTINUATION REFER TO DWG.: 1208-01-PR-UDD-052.


11-E-160	
UREA RECYCLE PREHEATER	
SHELL LENGTH :	2650 mm
SHELL I.D. :	500 mm
DESIGN PRESS. S/T :	12/12 barg
DESIGN TEMP. S/T :	150/120°C
INSULATION :	YES

11-E-114	11-V-114	11-L-114	11-V-125
VACUUM CONCENTRATOR	VACUUM SEPARATOR	VACUUM SEPARATOR HOLDER	11-E-114 STEAM CONDENSATE SEPARATOR
SHELL LENGTH : 5000 mm	I.D. x T.L.T.L : 4700 x 6000 mm	I.D. x T.L.T.L : 1500 x 1600 mm	I.D. x T.L.T.L : 1500 x 2000 mm
SHELL I.D. : 1260 mm	DESIGN PRESS. : 1.8 & F.V. barg	DESIGN PRESS. : 1.8/F.V. barg	DESIGN PRESS. : 6 & F.V. barg
DESIGN PRESS. S/T : 6 & F.V./1.8 & F.V. barg	DESIGN TEMP. : 170°C	DESIGN TEMP. : 170°C	DESIGN TEMP. : 180°C
DESIGN TEMP. S/T : 180/170°C	INSULATION : YES	INSULATION : YES	INSULATION : YES
INSULATION : YES	TRIM LINE NO. : 11-UP11180-B40U-ST	TRIM LINE NO. : 11-UP11175-B40U-SJ	TRIM LINE NO. : 11-LC11077-B24-H

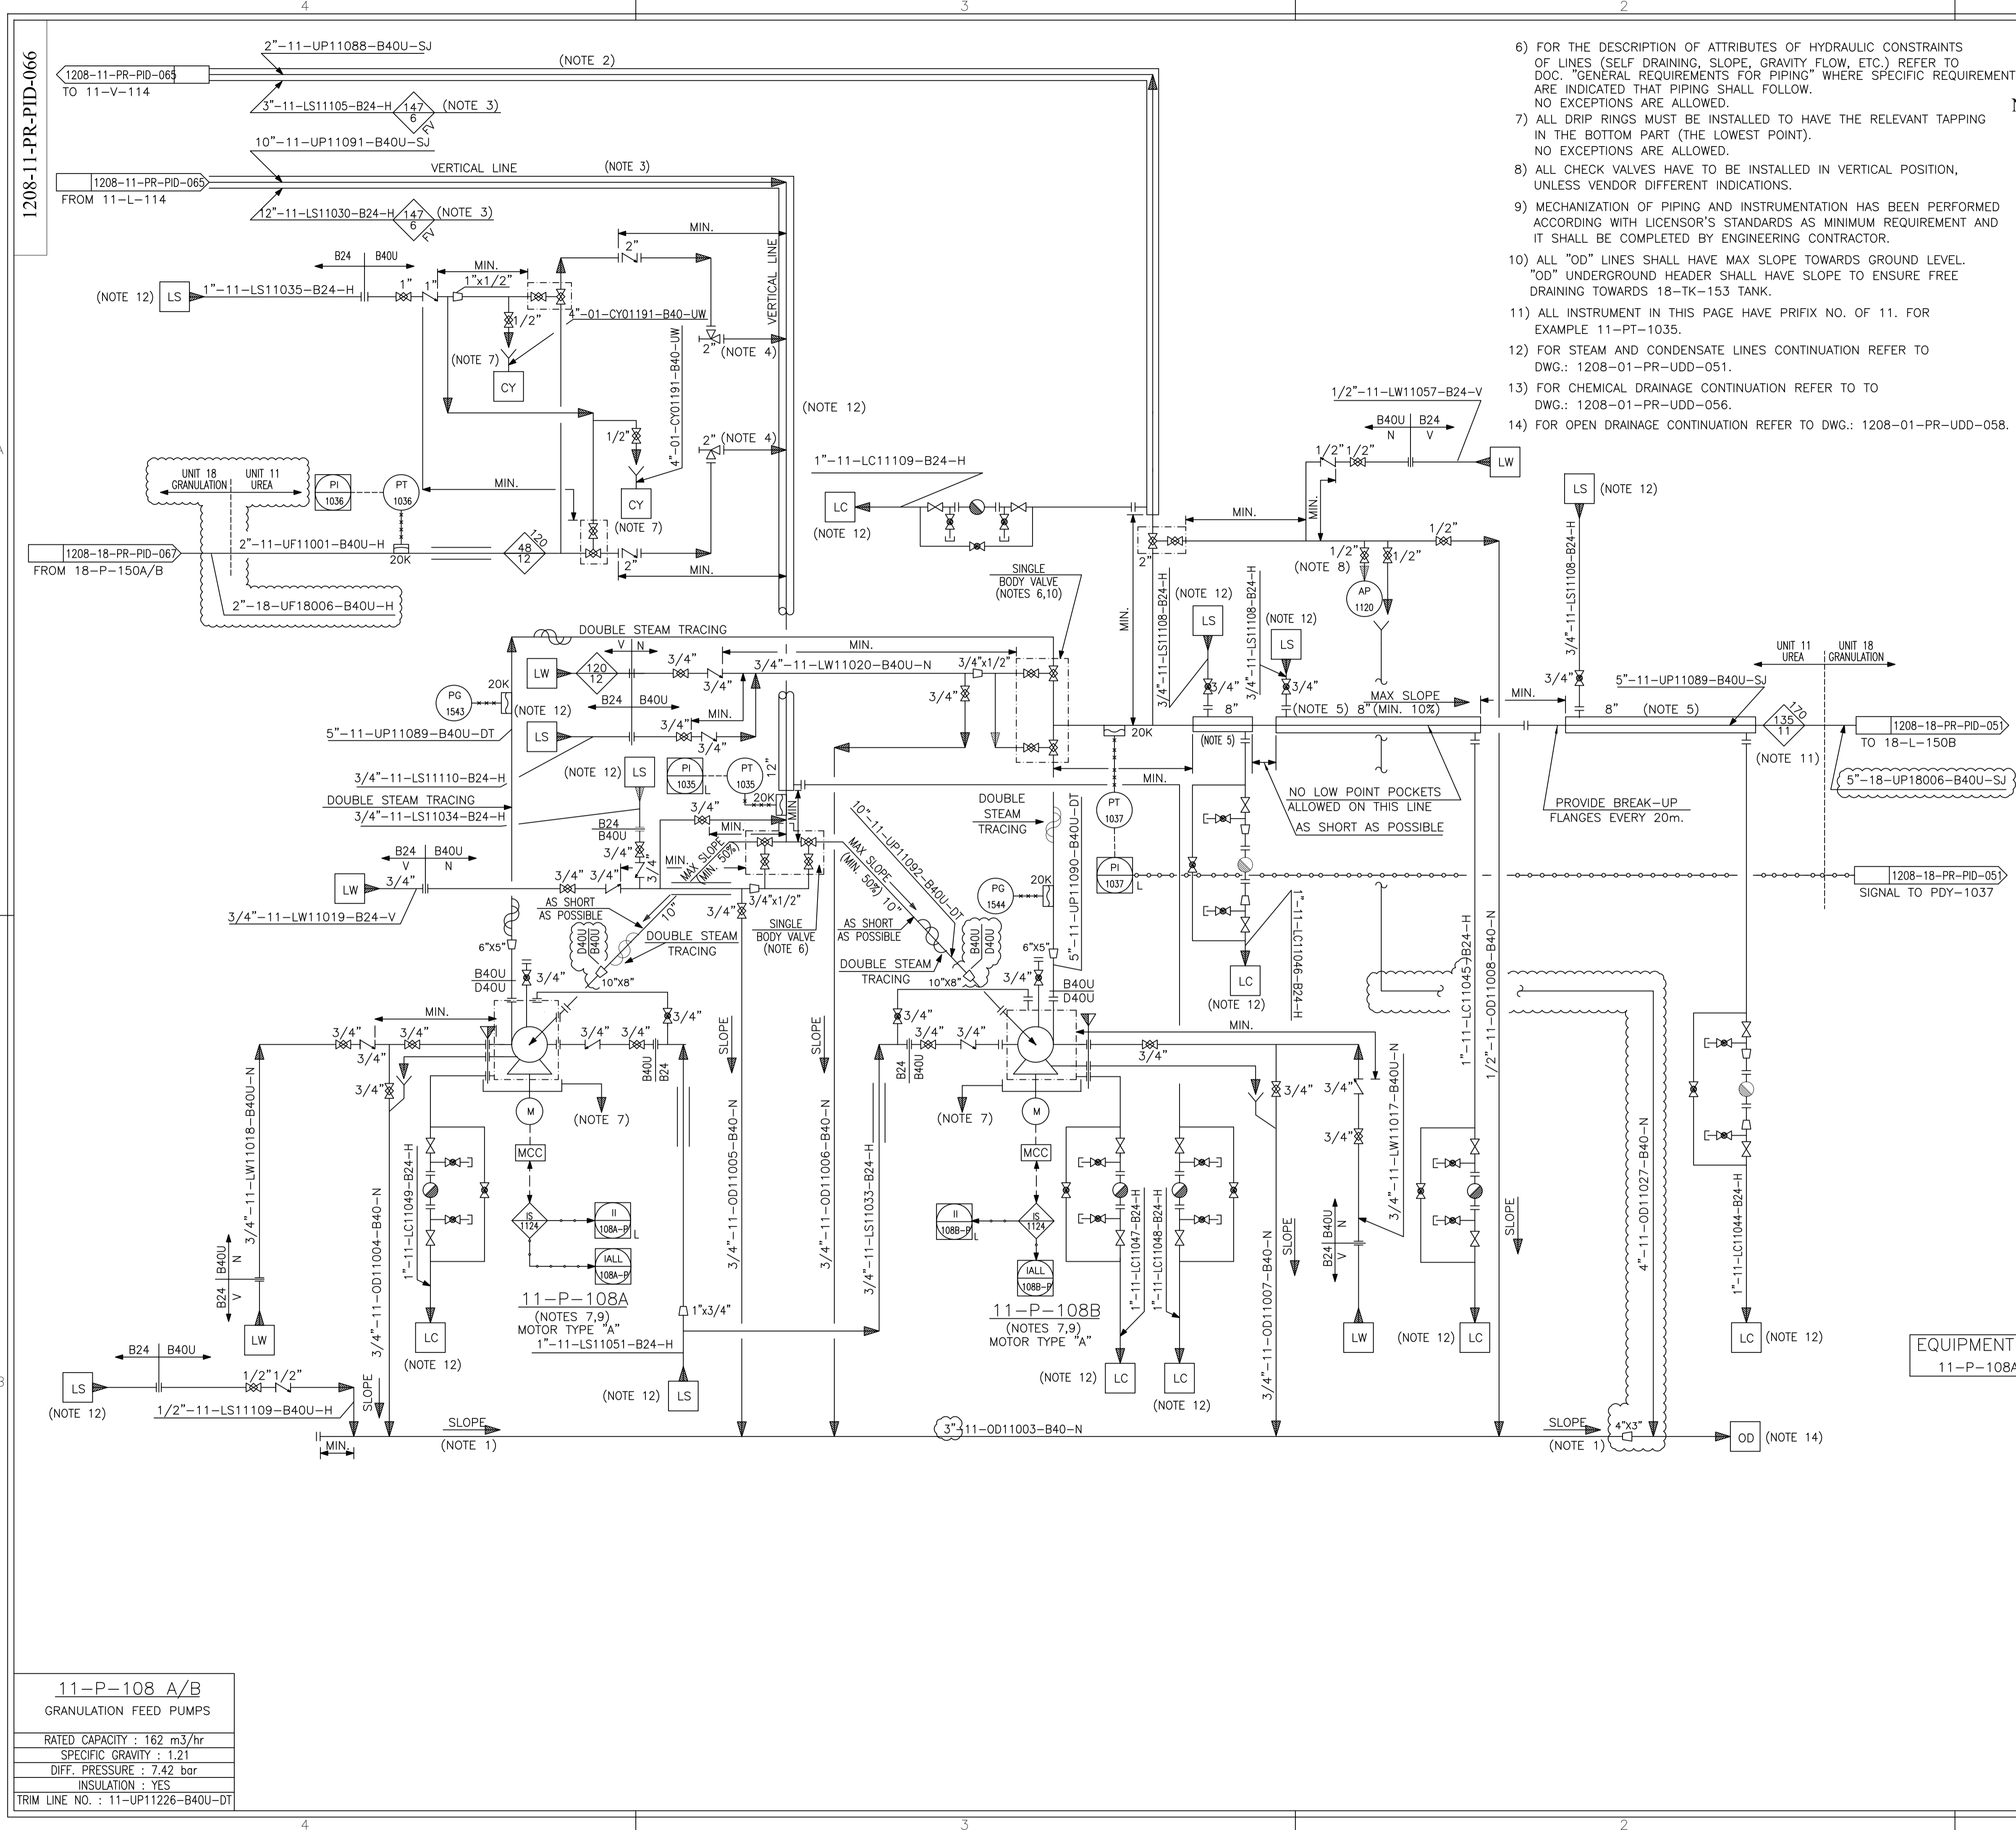

REFERENCE DRAWING	DWG. NO.
SYMBOLS AND IDENTIFICATIONS	1208-01-PR-PID-051-01

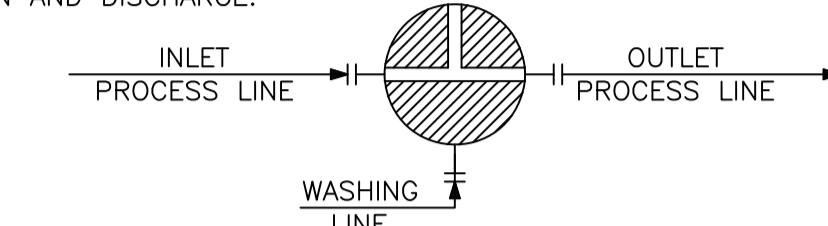- NOTES:**
- 1) AS VERTICAL AS POSSIBLE FROM THE CONNECTION TO THE GRADE.
 - 2) PART OF LINE NOT JACKETED TO BE STEAM TRACED IF MORE THAN 500mm.
 - 3) 11-P-108A/B SUCTION LINE: THE THICKNESS OF THE JACKETED STRAIGHT TUBE MUST BE SIZED CONSIDERING AN EXTERNAL PRESSURE OF 6.0 bar(g) AND FULL VACUUM INSIDE.
 - 4) VALVE TO BE LOCATED DIRECTLY CONNECTED TO PROCESS LINE.
 - 5) JACKETED LINE ARRANGEMENT :
 - PROVIDE BREAK-UP FLANGE EVERY 20m ;
 - PROVIDE FOR EACH LINE SEGMENT INDEPENDENT IN/OUT SYSTEM AND CONDENSATE DEVICE.
 - 6) OPERATING POSITION OF VALVES SINGLE BODY TYPE AT 11-P-108A/B SUCTION AND DISCHARGE:
 

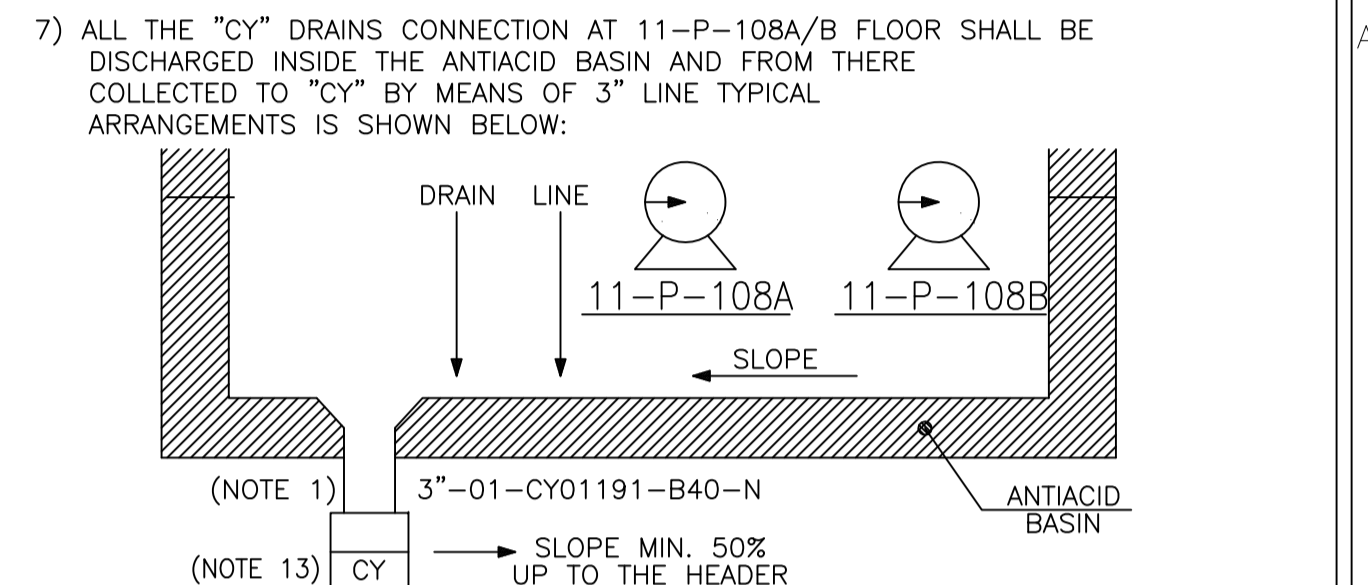

- 7) ALL THE "CY" DRAINS CONNECTION AT 11-P-108A/B FLOOR SHALL BE DISCHARGED INSIDE THE ANTIACID BASIN AND FROM THERE COLLECTED TO "CY" BY MEANS OF 3" LINE TYPICAL ARRANGEMENTS IS SHOWN BELOW:
- 8) FOR SAMPLE CONNECTION DETAILS AND PIPING ARRANGEMENT REFER TO P&ID 1208-11-PR-PID-080 AND 1208-11-PR-PID-081.
- 9) ALL PUMPS CONNECTIONS DEFINED AS PER PUMP MFR SELECTION.
- 10) THE ELEVATION OF COMMON DISCHARGE LINES OF 11-P-108A/B PUMPS HAS TO ENSURE A MINIMUM SLOPE 10% FROM THIS HPT POINT AND PV-2172/LV-1025 VALVES.
- 11) PROCESS DESIGN CONDITIONS FOR THIS LINE SHALL BE CONSIDERED INDEPENDENTLY FOR EACH OF THE FOLLOWING SCENARIOS:
 - A) DURING NORMAL OPERATION (UREA SOLUTION FLOWING):
DESIGN PRESSURE= 11 barg; DESIGN TEMPERATURE= 170 °C.
 - B) DURING WASHING SCENARIO (LW FLUID FLOWING):
DESIGN PRESSURE= 12 barg; DESIGN TEMPERATURE= 120 °C.
- 12) RESIDENCE TIME OF UREA SOLUTION FROM UF-85 INJECTION POINT AT 11-P-108A/B A/B SUCTION LINE TO GRAN.HEADER N.18 (REF.TO P&ID GD-B-06702) MUST BE MINIMUM 30 sec. AND MAX 45 sec.

- GENERAL NOTES:**
- 1) FOR SYMBOLS AND OTHER DETAILS PLEASE REFER TO PID 1208-01-PR-PID-051.
 - 2) FOR ALL "CD" LINES THE FLANGES ARE TO BE LOCATED AT MINIMUM DISTANCE FROM GRADE. ALL "CD" LINES SHALL HAVE SLOPE TO ENSURE FREE DRAINING TOWARDS 11-TK-104 TANK.
 - 3) SAFETY AND CONTROL VALVE IN/OUT LINES AND RELATED BYPASS LINE SIZE TO BE VERIFIED DURING ENGINEERING PHASE, AFTER CONTROL VALVES AND SAFETY VALVES SELECTION.
 - 4) MFR CONTRACTOR
 - 5) WHERE IT'S INDICATED "MIN" OR "MINIMUM DISTANCE" THE LENGTH OF THE INTERESTED PIPE TO BE KEPT AS SHORT AS POSSIBLE (ABOUT ONE HUNDRED MILLIMETERS) IN ORDER TO PREVENT DEAD ZONE.

EQUIPMENT LIST

11-P-108A/B

LICENSOR REF. : P56

DE	EXT	AFC	A
Eng. Phase	Purpose of Distribution (POD)	Purpose of Issue (POI)	Owner's Action
04	07.01.2024	APPROVED FOR CONSTRUCTION	M.Fahrari, A.Azma, A.Azma, M.Sariri
03	29.08.2023	APPROVED FOR CONSTRUCTION	M.Fahrari, A.Azma, A.Azma, M.Sariri
02	20.11.2022	APPROVED FOR CONSTRUCTION	M.Fahrari, M.Yadegarpanahi, A.Azma, M.Sariri
01	12.06.2018	APPROVED FOR CONSTRUCTION (WITH HOLD)	M.Yadegarpanahi, A.Azma, A.Azma, M.Sariri
00	04.04.2017	ISSUED FOR ENGINEERING	F.Mezari, A.Habibi, A.Azma, M.Sariri

THIS DOCUMENT IS THE PROPERTY OF HFC. IT IS CONFIDENTIAL AND ALL RIGHTS RESERVED. NEITHER THE WHOLE NOR PART OF THIS DOCUMENT MAY BE DISCLOSED TO ANY THIRD PARTY, REPRODUCED, STORED IN ANY RETRIEVAL SYSTEM OR TRANSMITTED IN ANY FORM OR BY ANY MEANS WITHOUT THE PRIOR WRITTEN CONSENT OF HFC.

OWNER:

MC:

EPCC CONTRACTOR:

PROJECT: HENGAM FERTILIZER PROJECT


TITLE: PIPING AND INSTRUMENTATION DIAGRAM VACUUM EVAPORATION SECTION 3 of 5

SCALE: N.T.S	OWNER PROJECT NO.: NA	DWG. NO.: 1208-11-PR-PID-066	REV. 04	SIZE: A1
DATE: 1 OF 1	PIDEC PROJECT NO.: 1208			

- 6) FOR THE DESCRIPTION OF ATTRIBUTES OF HYDRAULIC CONSTRAINTS OF LINES (SELF DRAINING, SLOPE, GRAVITY FLOW, ETC.) REFER TO DOC. "GENERAL REQUIREMENTS FOR PIPING" WHERE SPECIFIC REQUIREMENTS ARE INDICATED THAT PIPING SHALL FOLLOW. NO EXCEPTIONS ARE ALLOWED.
- 7) ALL DRIP RINGS MUST BE INSTALLED TO HAVE THE RELEVANT TAPPING IN THE BOTTOM PART (THE LOWEST POINT). NO EXCEPTIONS ARE ALLOWED.
- 8) ALL CHECK VALVES HAVE TO BE INSTALLED IN VERTICAL POSITION, UNLESS VENDOR DIFFERENT INDICATIONS.
- 9) MECHANIZATION OF PIPING AND INSTRUMENTATION HAS BEEN PERFORMED ACCORDING WITH LICENSOR'S STANDARDS AS MINIMUM REQUIREMENT AND IT SHALL BE COMPLETED BY ENGINEERING CONTRACTOR.
- 10) ALL "OD" LINES SHALL HAVE MAX SLOPE TOWARDS GROUND LEVEL. "OD" UNDERGROUND HEADER SHALL HAVE SLOPE TO ENSURE FREE DRAINING TOWARDS 18-TK-153 TANK.
- 11) ALL INSTRUMENT IN THIS PAGE HAVE PREFIX NO. OF 11. FOR EXAMPLE 11-PT-1035.
- 12) FOR STEAM AND CONDENSATE LINES CONTINUATION REFER TO DWG.: 1208-01-PR-UDD-051.
- 13) FOR CHEMICAL DRAINAGE CONTINUATION REFER TO TO DWG.: 1208-01-PR-UDD-056.
- 14) FOR OPEN DRAINAGE CONTINUATION REFER TO DWG.: 1208-01-PR-UDD-058.


11-P-108 A/B
GRANULATION FEED PUMPS

RATED CAPACITY : 162 m ³ /hr
SPECIFIC GRAVITY : 1.21
DIFF. PRESSURE : 7.42 bar
INSULATION : YES
TRIM LINE NO. : 11-UP11226-B40U-DT

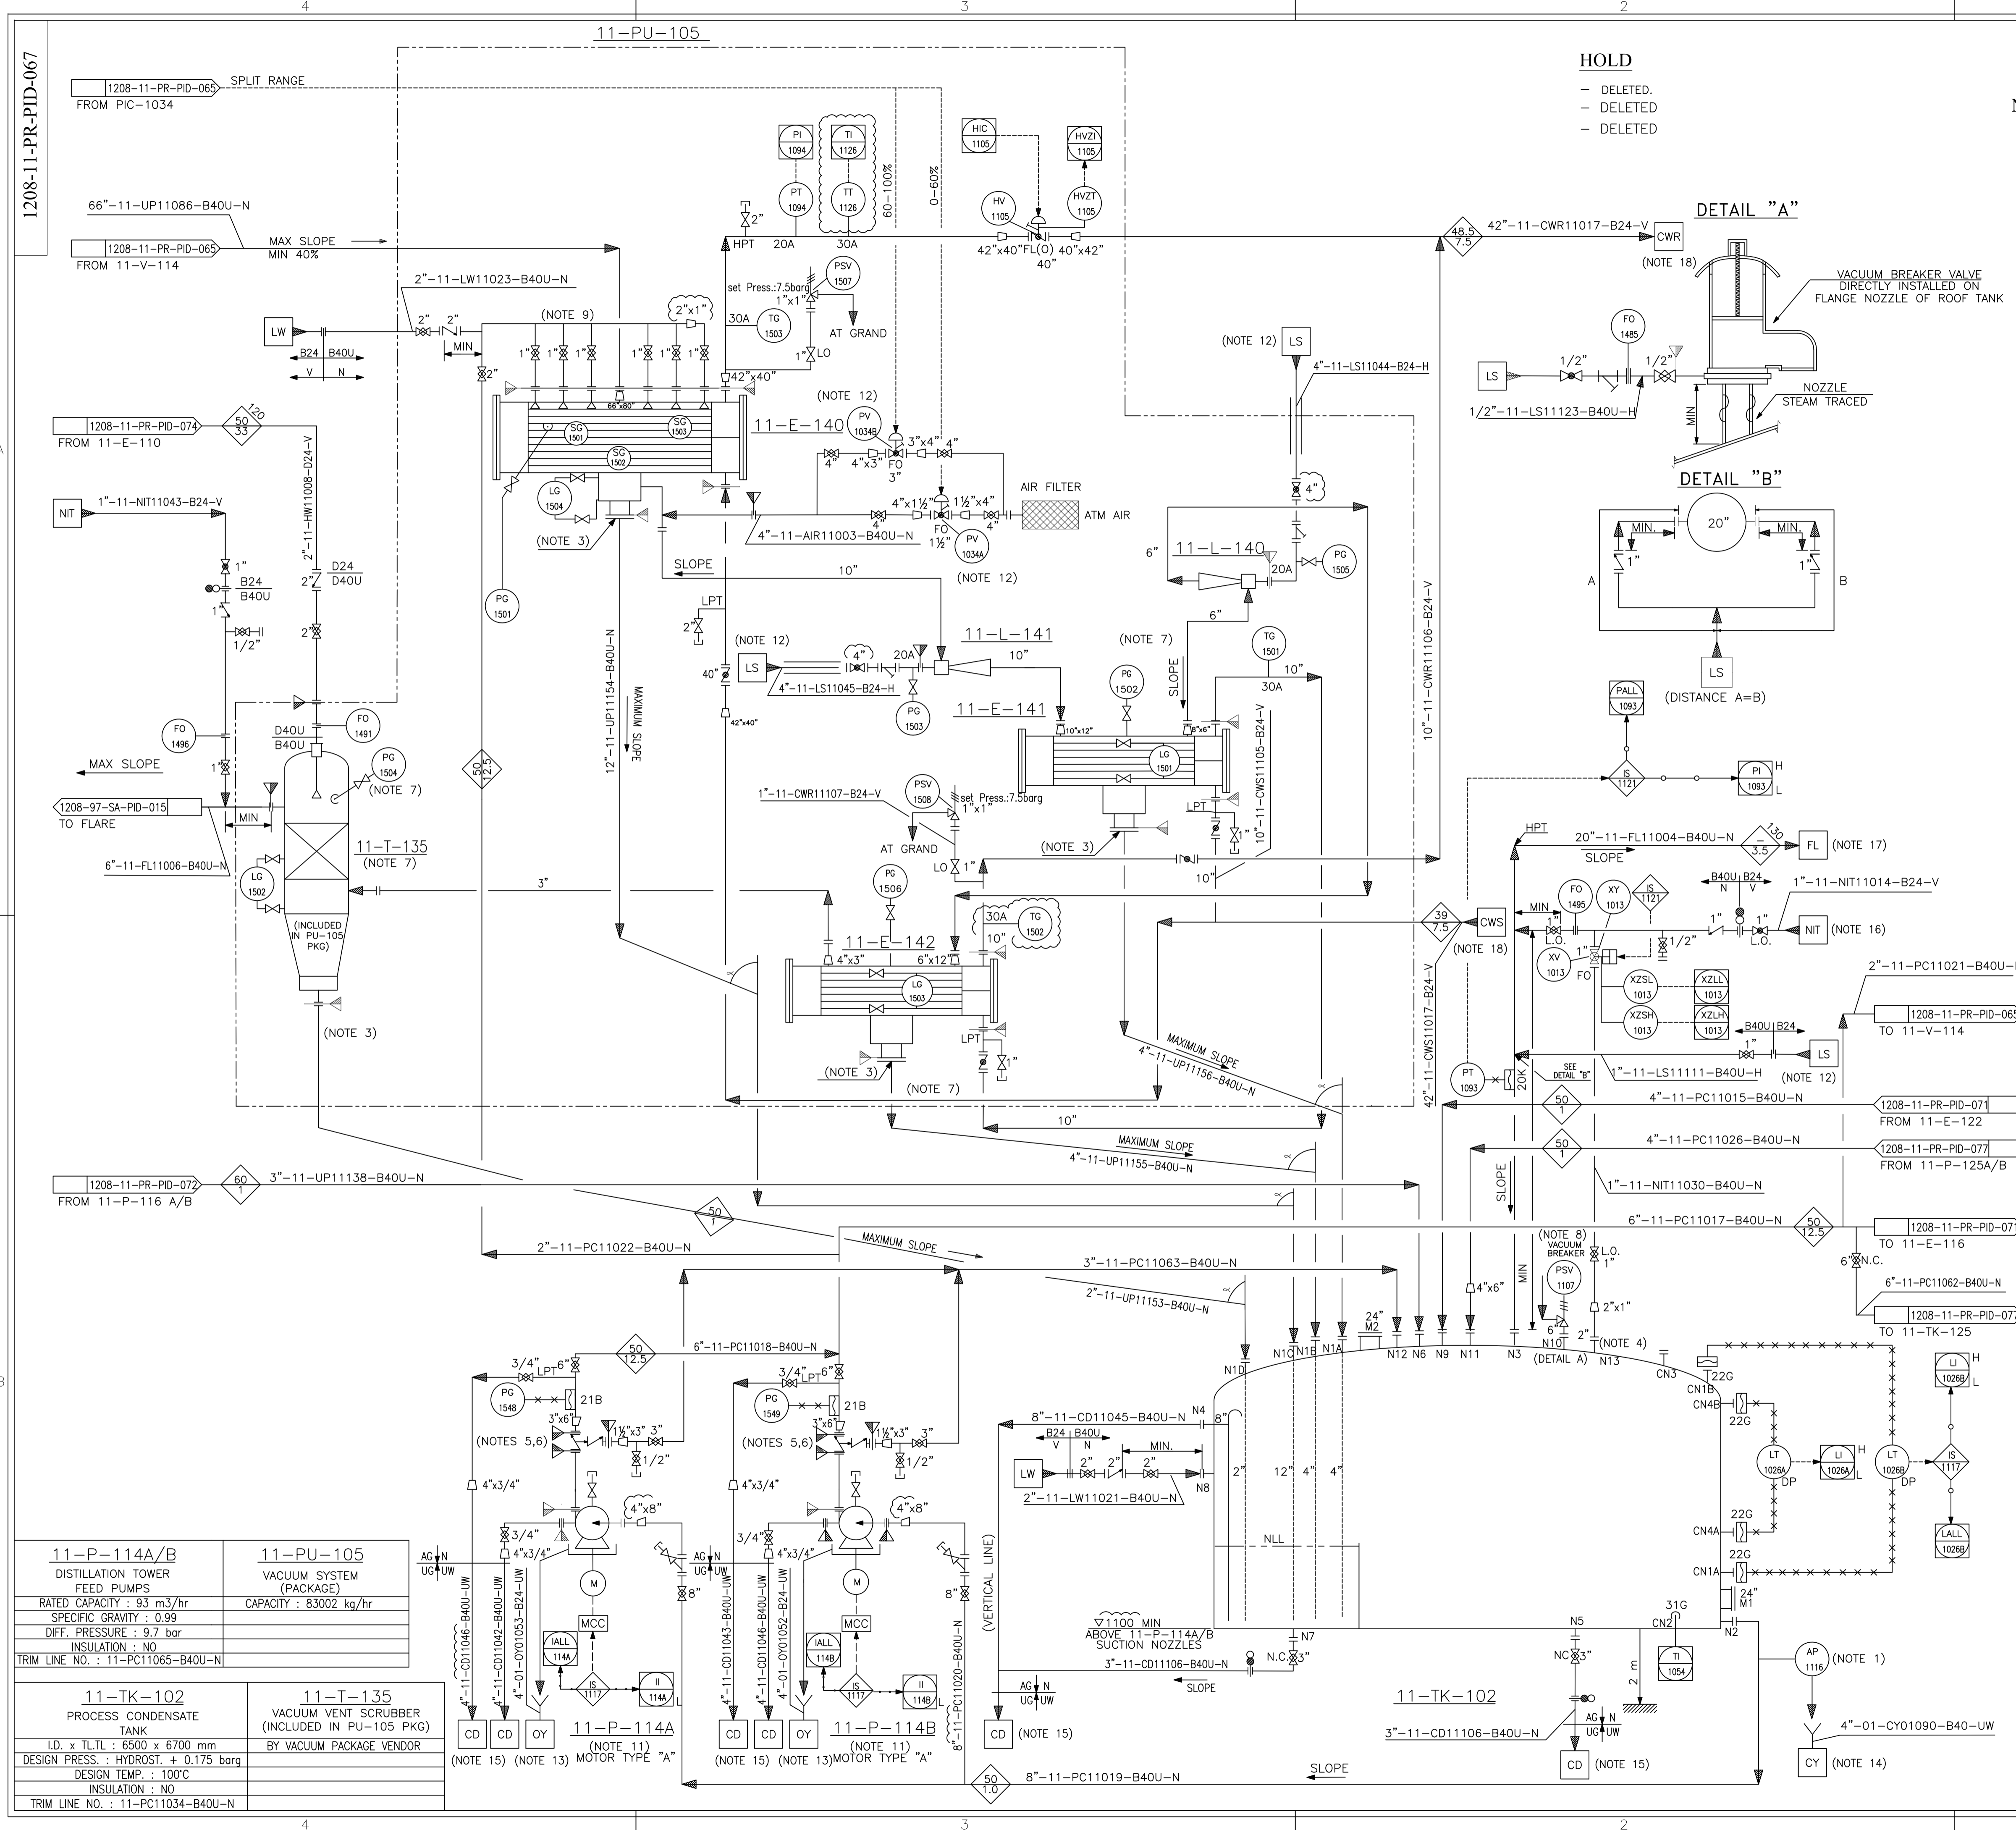

REFERENCE DRAWING	DWG. NO.
SYMBOLS AND IDENTIFICATIONS	1208-01-PR-PID-051-01

- NOTES:**
- FOR SAMPLE CONNECTION DETAILS AND PIPING ARRANGEMENT REFER TO P&ID 1208-11-PR-PID-080 AND 1208-11-PR-PID-081.
 - DELETED.
 - CONDENSATE OUTLET NOZZLE OF EACH EXCHANGER OF 11-PU-105 SHALL BE LOCATED MINIMUM 11m HIGHER THAN 11-TK-102 TANK ROOF.
 - NOZZLE PROJECTION LENGTH TO BE MINIMIZED AND STEAM TRACED.
 - MINIMUM FLOW DEVICE AND AUTOMATIC NON RETURN VALVE TO BE SUPPLIED BY PUMP MFR.
 - ARV TO BE INSTALLED IN VERTICAL POSITION.
 - ALL INSTRUMENT IN PACKAGE TO BE SUPPLIED BY 11-PU-105 PACKAGE MFR.
 - VACUUM BREAKER TO BE SUPPLIED BY TANK 11-TK-102 MFR. SEE DETAIL "A".
 - NUMBER OF CONNECTIONS CONFIRMED BY 11-PU-105 MFR.
 - <= 40' MAX
 - ALL PUMPS CONNECTIONS DEFINED AS PER PUMP MFR SELECTION.

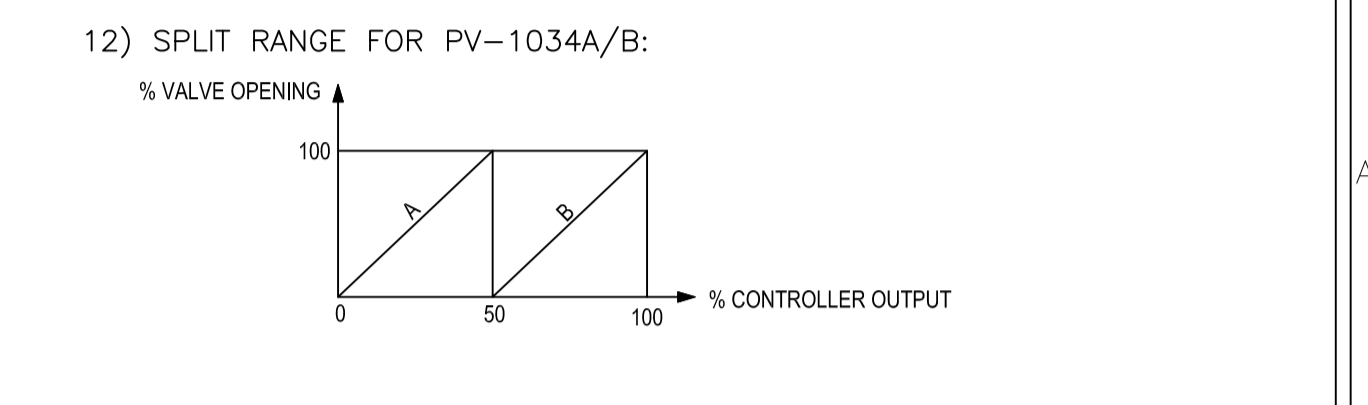

- GENERAL NOTES:**
- FOR SYMBOLS AND OTHER DETAILS PLEASE REFER TO PID 1208-01-PR-PID-051.
 - FOR ALL "CD" LINES THE FLANGES ARE TO BE LOCATED AT MINIMUM DISTANCE FROM GRADE. ALL "CD" LINES SHALL HAVE SLOPE TO ENSURE FREE DRAINING TOWARDS 11-TK-104 TANK.
 - SAFETY AND CONTROL VALVE IN/OUT LINES AND RELATED BYPASS LINE SIZE TO BE VERIFIED DURING ENGINEERING PHASE, AFTER CONTROL VALVES AND SAFETY VALVES SELECTION.
 - CONTRACTOR
 - WHERE IT'S INDICATED "MIN" OR "MINIMUM DISTANCE" THE LENGTH OF THE INTERESTED PIPE TO BE KEPT AS SHORT AS POSSIBLE (ABOUT ONE HUNDRED MILLIMETERS) IN ORDER TO PREVENT DEAD ZONE.
 - FOR THE DESCRIPTION OF ATTRIBUTES OF HYDRAULIC CONSTRAINTS OF LINES (SELF DRAINING, SLOPE, GRAVITY FLOW, ETC.) REFER TO DOC. "GENERAL REQUIREMENTS FOR PIPING" WHERE SPECIFIC REQUIREMENTS ARE INDICATED THAT PIPING SHALL FOLLOW. NO EXCEPTIONS ARE ALLOWED.
 - ALL DRIP RINGS MUST BE INSTALLED TO HAVE THE RELEVANT TAPPING IN THE BOTTOM PART (THE LOWEST POINT). NO EXCEPTIONS ARE ALLOWED.
 - ALL CHECK VALVES HAVE TO BE INSTALLED IN VERTICAL POSITION, UNLESS VENDOR DIFFERENT INDICATIONS.
 - MECHANIZATION OF PIPING AND INSTRUMENTATION HAS BEEN PERFORMED ACCORDING WITH LICENSOR'S STANDARDS AS MINIMUM REQUIREMENT AND IT SHALL BE COMPLETED BY ENGINEERING CONTRACTOR.
 - ALL "OD" LINES SHALL HAVE MAX SLOPE TOWARDS GROUND LEVEL. "OD" UNDERGROUND HEADER SHALL HAVE SLOPE TO ENSURE FREE DRAINING TOWARDS 18-TK-153 TANK.
 - ALL INSTRUMENT IN THIS PAGE HAVE PREFIX NO. OF 11. FOR EXAMPLE 11-FO-1495.
 - FOR STEAM AND CONDENSATE LINES CONTINUATION REFER TO DWG.: 1208-01-PR-UPD-051.
 - FOR OILY WATER DRAINAGE CONTINUATION REFER TO DWG.: 1208-01-PR-UPD-055.
 - FOR CHEMICAL DRAINAGE CONTINUATION REFER TO DWG.: 1208-01-PR-UPD-056.
 - FOR CLOSE DRAINAGE CONTINUATION REFER TO DWG.: 1208-01-PR-UPD-057.
 - FOR NITROGEN LINES CONNECTION REFER DWG.: 1208-01-PR-UPD-052.
 - FOR FLARE CONTINUATION REFER TO DWG.: 1208-01-PR-UPD-014
 - FOR COOLING WATER SUPPLY/RETURN CONTINUATION REFER TO DWG.: 1208-01-PR-UPD-053.

EQUIPMENT LIST

11-P-114A/B	11-PU-105
11-TK-102	11-T-135

11-P-114A/B DISTILLATION TOWER FEED PUMPS RATED CAPACITY : 93 m ³ /hr SPECIFIC GRAVITY : 0.99 DIFF. PRESSURE : 9.7 bar INSULATION : NO TRIM LINE NO. : 11-PC11065-B40U-N	11-PU-105 VACUUM SYSTEM (PACKAGE) CAPACITY : 83002 kg/hr
11-TK-102 PROCESS CONDENSATE TANK I.D. x T.L.T.L. : 6500 x 6700 mm DESIGN PRESS. : HYDROST. + 0.175 barg DESIGN TEMP. : 100°C INSULATION : NO TRIM LINE NO. : 11-PC11034-B40U-N	11-T-135 VACUUM VENT SCRUBBER (INCLUDED IN PU-105 PKG) BY VACUUM PACKAGE VENDOR

LICENSOR REF. : P57

DE	EXT	AFC	A
Eng. Phase	Purpose of Distribution (POD)	Purpose of Issue (POI)	Owner's Action
04	14.01.2024	APPROVED FOR CONSTRUCTION	M.Fakhrani A.Azma A.Azma M.Sarani
03	02.09.2023	APPROVED FOR CONSTRUCTION	M.Fakhrani A.Azma A.Azma M.Sarani
02	21.11.2022	APPROVED FOR CONSTRUCTION (WITH HOLD)	M.Fakhrani M.Yadgarparani A.Azma M.Sarani
01	12.06.2018	APPROVED FOR CONSTRUCTION (WITH HOLD)	M.Yadgarparani A.Azma A.Azma M.Sarani
00	04.04.2017	ISSUED FOR ENGINEERING	F.Mrazee A.Habibi A.Azma M.Sarani
REV.	ISSUE DATE	DESCRIPTION	PREPARED BY CHECKED BY PROJECT

OWNER:


MC:

EPCC CONTRACTOR:




PROJECT: **HENGAM FERTILIZER PROJECT**

TITLE: **PIPING AND INSTRUMENTATION DIAGRAM VACUUM EVAPORATION SECTION 4 OF 5**

SCALE: N.T.S	OWNER PROJECT NO.: NA	DWG. NO.:	REV. SIZE:
1 OF 1	PIDE PROJECT NO.: 1208	1208-11-PR-PID-067	04 A1

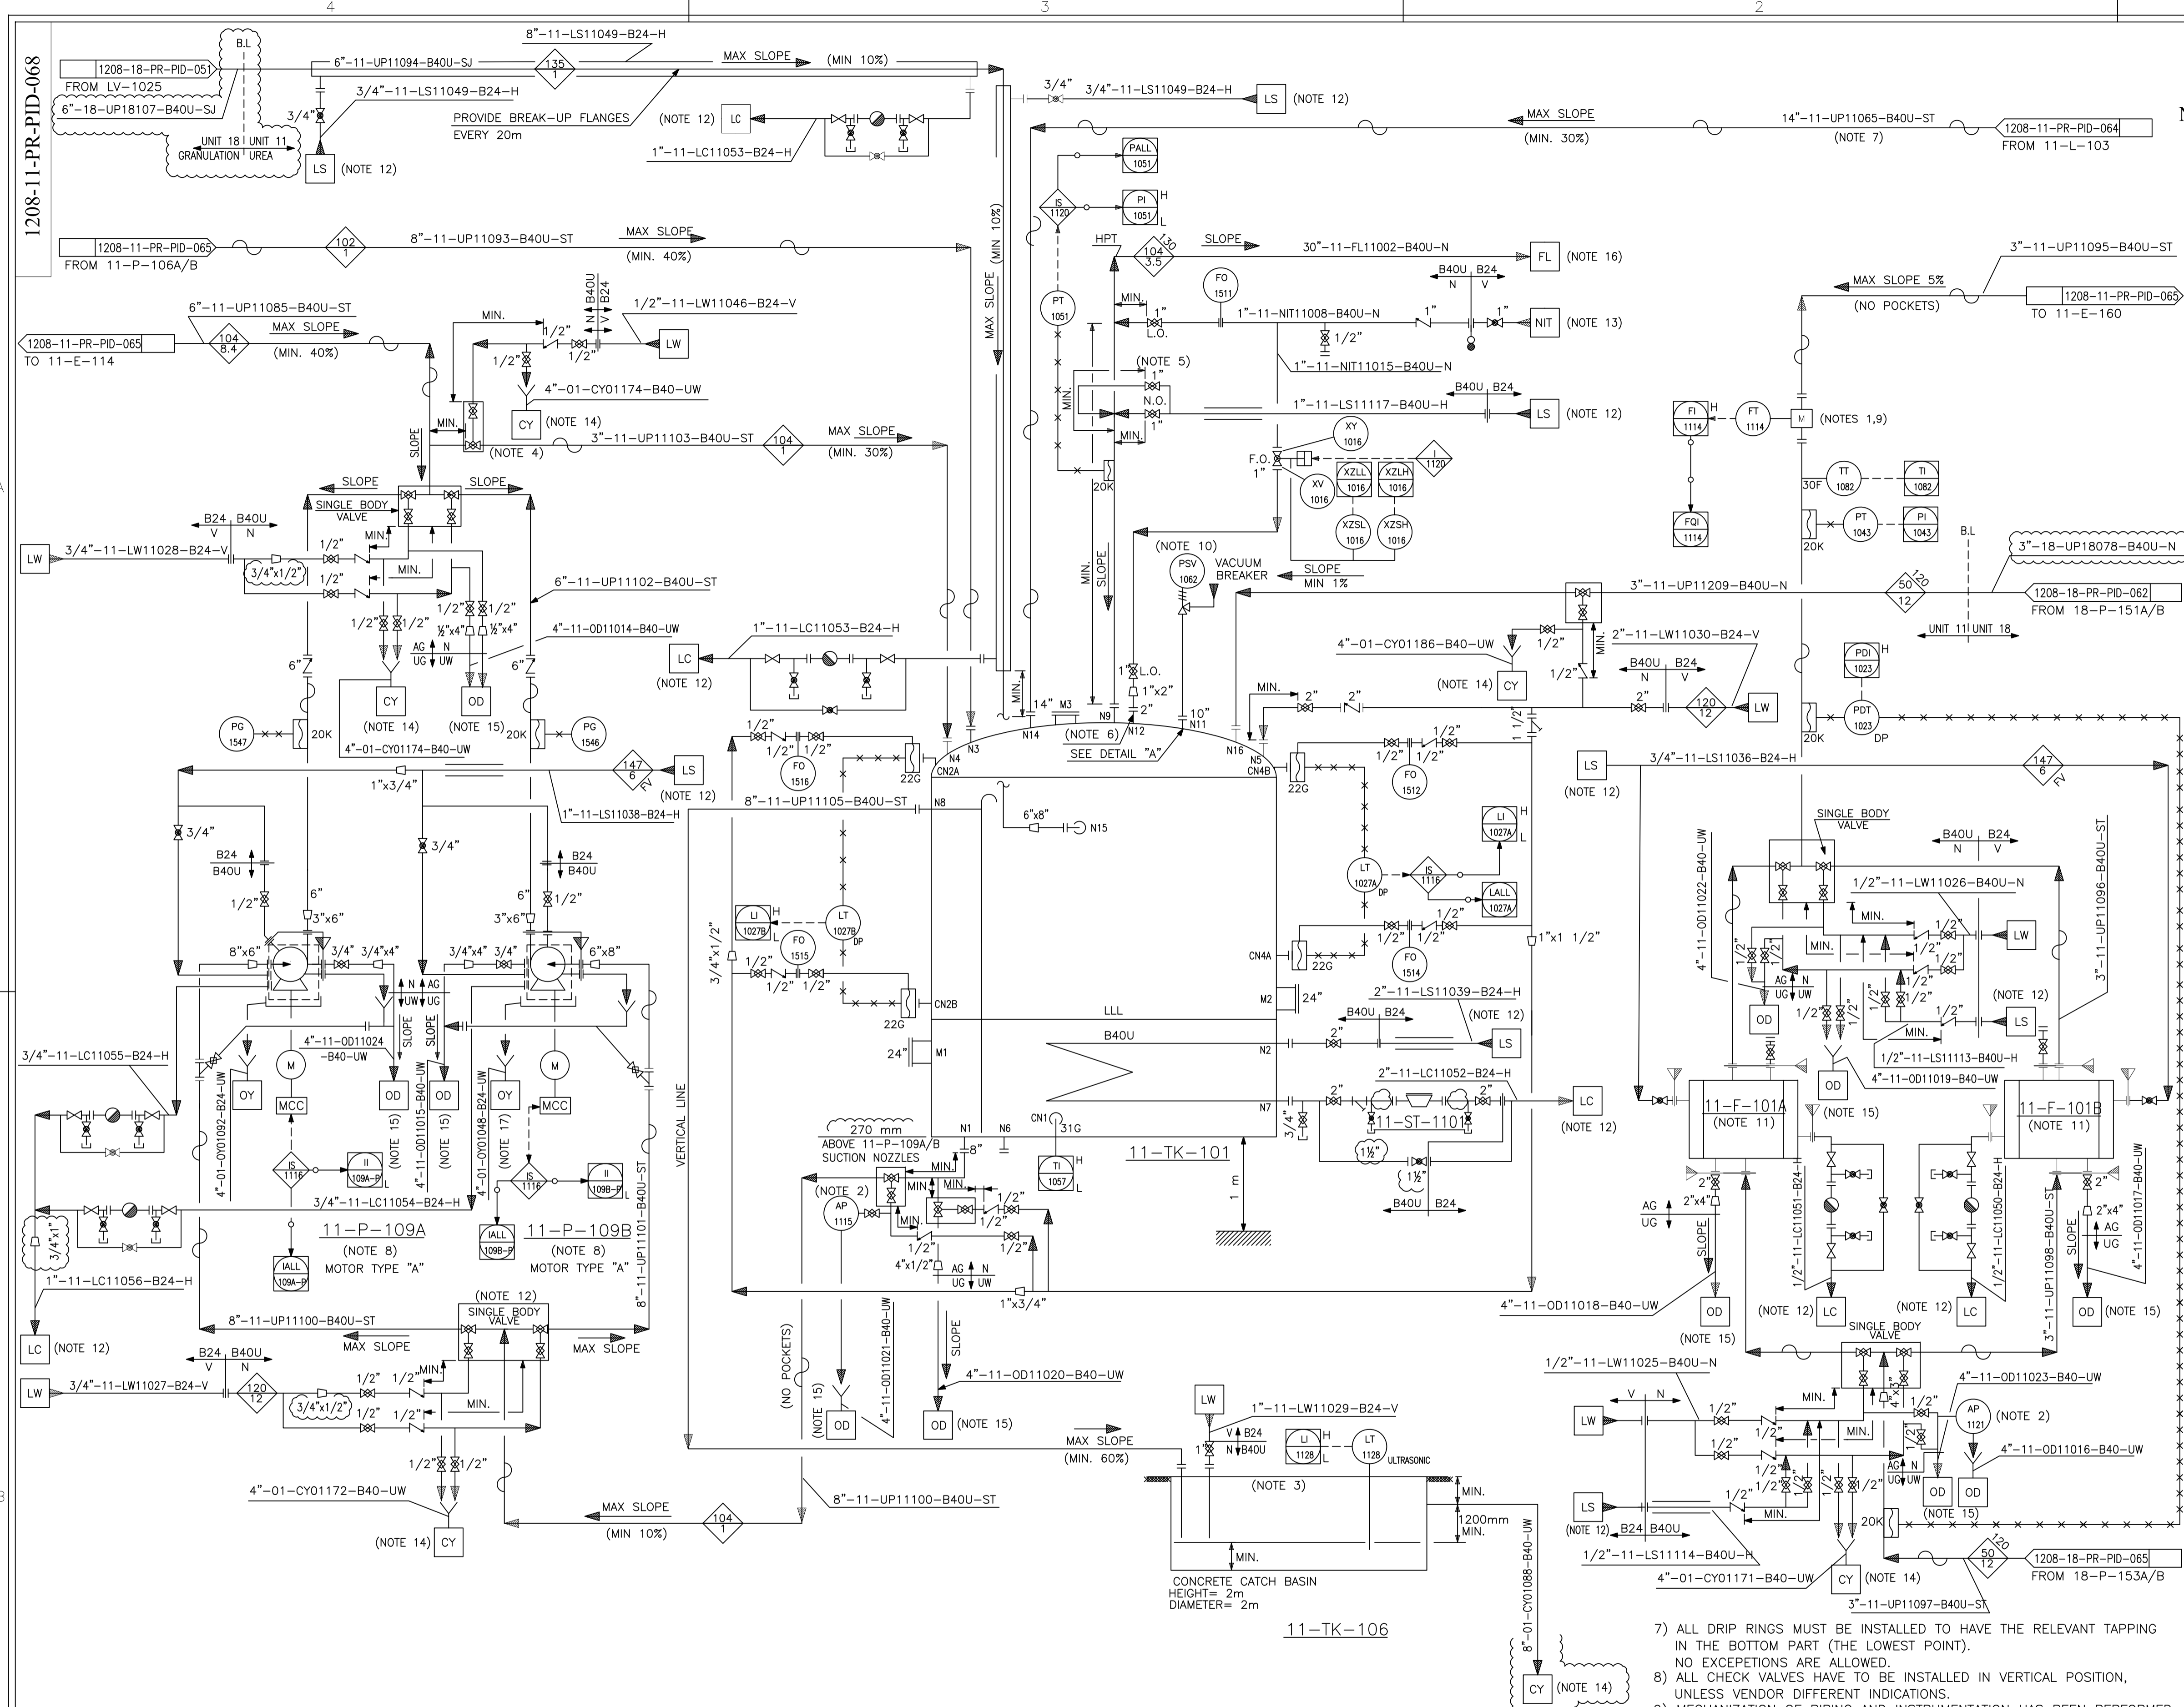

REFERENCE DRAWING	DWG. NO.
SYMBOLS AND IDENTIFICATIONS	1208-01-PR-PID-051-01

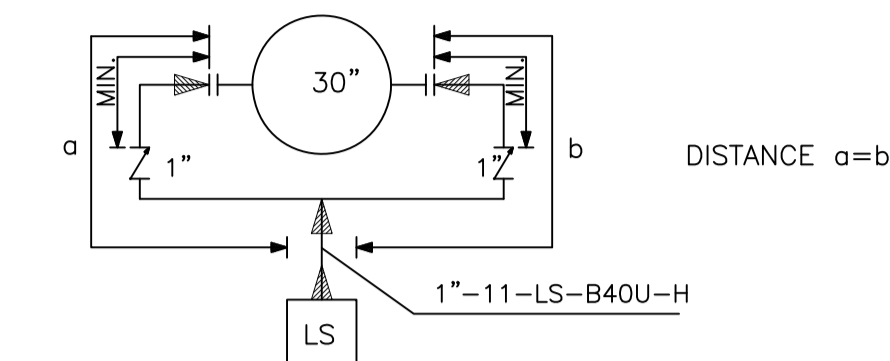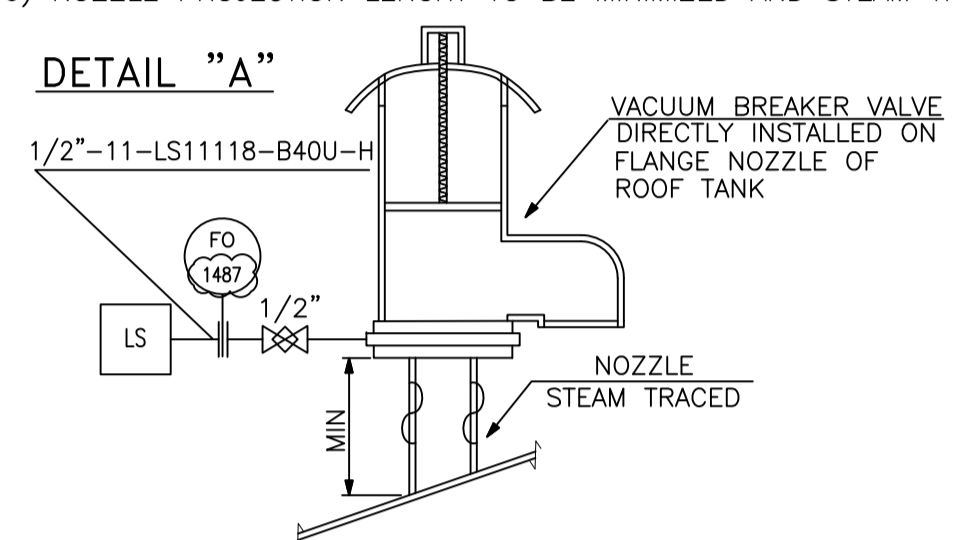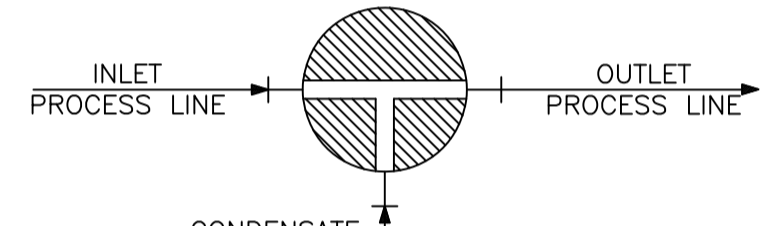


- NOTES:**
- UPSTREAM STRAIGHT RUN 5 TIMES FLOWMETER INLET DIAMETER. DOWNSTREAM STRAIGHT RUN 2 TIMES FLOWMETER OUTLET DIAMETER.
 - FOR SAMPLE CONNECTION DETAILS AND PIPING ARRANGEMENT REFER TO P&ID 1208-11-PR-PID-080 AND 1208-11-PR-PID-081.
 - TOP COVER MADE OF GRATING.
 - TO BE LOCATED AT STRUCTURE AT 11-P-108A/B FLOOR.
 - LS STEAM CONNECTIONS ARRANGEMENT:
 
 - NOZZLE PROJECTION LENGTH TO BE MINIMIZED AND STEAM TRACED.
 
 - PROVIDE TWO PHASE FLOW REINFORCED SUPPORT.
 - ALL PUMPS CONNECTIONS DEFINED AS PER PUMP MFR SELECTION.
 - STEAM TRACING SHALL BE AVOIDED AROUND FLOWMETER FT-1114 BODY.
 - VACUUM BREAKER TO BE SUPPLIED BY TANK MFR.
 - TO BE LOCATED IN GRAN. BUILDING GROUND LEVEL, CLOSE TO 18-P-153 A/B.
 - OPERATING POSITION OF VALVES WITH INCORPORATED WASHING CONNECTION AT 11-P-106A/B SUCTION AND DISCHARGE.
 

- GENERAL NOTES:**
- FOR SYMBOLS AND OTHER DETAILS PLEASE REFER TO DOC. 1208-01-PR-PID-051.
 - FOR ALL "OD" LINES THE FLANGES ARE TO BE LOCATED AT MINIMUM DISTANCE FROM GRADE. ALL "CD" LINES SHALL HAVE SLOPE TO ENSURE FREE DRAINING TOWARDS 11-TK-104 TANK.
 - SAFETY AND CONTROL VALVE IN/OUT LINES TO BE VERIFIED DURING ENGINEERING PHASE, AFTER CONTROL VALVES AND SAFETY VALVES SELECTION.
 - MFR CONTRACTOR
 - WHERE IT'S INDICATED "MIN" OR "MINIMUM DISTANCE" THE LENGTH OF THE INTERESTED PIPE TO BE KEPT AS SHORT AS POSSIBLE (ABOUT ONE HUNDRED MILLIMETERS) IN ORDER TO PREVENT DEAD ZONE.
 - FOR THE DESCRIPTION OF ATTRIBUTES OF HYDRAULIC CONSTRAINTS OF LINES (SELF DRAINING, SLOPE, GRAVITY FLOW, ETC.) REFER TO DOC. "GENERAL REQUIREMENTS FOR PIPING" WHERE SPECIFIC REQUIREMENTS ARE INDICATED THAT PIPING SHALL FOLLOW. NO EXCEPTIONS ARE ALLOWED.

LICENSOR REF. : P58

DE	EXT	AFC	A
Eng. Phase	Purpose of Distribution (POD)	Purpose of Issue (POI)	Owner's Action

REV.	DATE	DESCRIPTION	PREPARED BY	CHECKED BY	APPROVED BY	PROJECT
04	17.01.2024	APPROVED FOR CONSTRUCTION	M.Fahrari	A.Azma	A.Azma	M.Sarafi
03	30.08.2023	APPROVED FOR CONSTRUCTION	M.Fahrari	A.Azma	A.Azma	M.Sarafi
02	21.11.2022	APPROVED FOR CONSTRUCTION (WITH HOLD)	M.Fahrari	M.Yadgarpanahi	A.Azma	M.Sarafi
01	12.06.2018	APPROVED FOR CONSTRUCTION (WITH HOLD)	M.Yadgarpanahi	A.Azma	A.Azma	M.Sarafi
00	04.04.2017	ISSUED FOR ENGINEERING	F.Mozai	A.Habibi	A.Azma	M.Sarafi

OWNER:  MC:  EPCC CONTRACTOR: 

PROJECT: HENGAM FERTILIZER PROJECT

TITLE: PIPING AND INSTRUMENTATION DIAGRAM VACUUM EVAPORATION SECTION 5 of 5

SCALE: N.T.S. OWNER PROJECT NO.: NA DWG. NO.: 1208-11-PR-PID-068 REV. SIZE: 04 A1

11-TK-101	11-P-109A/B	11-F-101A/B	11-TK-106
UREA SOLUTION TANK	UREA SOLUTION RECOVERY PUMPS	UREA SOLUTION FILTERS	CATCH BASIN FOR 11-TK-101
I.D. x T.L.T.: 18400 x 7000 mm	RATED CAPACITY : 65 m ³ /hr	MAX. CAPACITY : 22100 Kg/hr	MATERIAL : CONCRETE
DESIGN PRESS. : HYDROST.+0.175 barg	SPECIFIC GRAVITY : 1.175	DESIGN PRESS. S/T : 12 barg	DESIGN PRESS. : FULL OF WATER
DESIGN TEMP. : 170°C	DIFF. PRESSURE : 6 bar	DESIGN TEMP. S/T : 150°C	DESIGN TEMP. : 170°C
INSULATION : YES	INSULATION : YES	INSULATION : NO	GEOMETRIC VOLUME : 6.28 m ³
TRIM LINE NO. : 11-UP11176-B40U-ST	TRIM LINE NO. : 11-UP11201-B40U-ST	TRIM LINE NO. : 11-UP11224-B40U-ST	

EQUIPMENT LIST-P-109A/B

11-TK-101 11-F-101A/B
11-TK-106

16) FOR FLARE CONTINUATION REFER TO DWG.: 1208-97-SA-PID-014
17) FOR OILY WATER DRAINAGE CONTINUATION REFER TO DWG.: 1208-01-PR-UDD-055.

HOLD
- DELETED

- NOTES:**
- 1) FOR SAMPLE CONNECTION DETAILS AND PIPING ARRANGEMENT REFER TO P&ID. 1208-11-PR-PID-080 AND 1208-11-PR-PID-081.
 - 2) FT-1027 AND FV-1027 TO BE LOCATED NEAR AND AT GROUND LEVEL.
 - 3) MINIMUM FLOW DEVICE AND AUTOMATIC NOT RETURN VALVE TO BE SUPPLIED BY PUMP MFR.
 - 4) ARV VALVE TO BE INSTALLED IN VERTICAL POSITION.
 - 5) STEAM TRACING SHALL BE AVOIDED AROUND FLOWMETER FT-1027.
 - 6) ALL PUMPS CONNECTIONS DEFINED AS PER PUMP MFR SELECTION.

- GENERAL NOTES:**
- 1) FOR SYMBOLS AND OTHER DETAILS PLEASE REFER TO PID 1208-01-PR-PID-051.
 - 2) FOR ALL "CD" LINES THE FLANGES ARE TO BE LOCATED AT MINIMUM DISTANCE FROM GRADE. ALL "CD" LINES SHALL HAVE SLOPE TO ENSURE FREE DRAINING TOWARDS 11-TK-104 TANK.
 - 3) SAFETY AND CONTROL VALVE IN/OUT LINES AND RELATED BYPASS LINE SIZE TO BE VERIFIED DURING ENGINEERING PHASE, AFTER CONTROL VALVES AND SAFETY VALVES SELECTION.
 - 4) MFR CONTRACTOR
 - 5) WHERE IT'S INDICATED "MIN" OR "MINIMUM DISTANCE" THE LENGTH OF THE INTERESTED PIPE TO BE KEPT AS SHORT AS POSSIBLE (ABOUT ONE HUNDRED MILLIMETERS) IN ORDER TO PREVENT DEAD ZONE.
 - 6) FOR THE DESCRIPTION OF ATTRIBUTES OF HYDRAULIC CONSTRAINTS OF LINES (SELF DRAINING, SLOPE, GRAVITY FLOW, ETC.) REFER TO DOC. "GENERAL REQUIREMENTS FOR PIPING" WHERE SPECIFIC REQUIREMENTS ARE INDICATED THAT PIPING SHALL FOLLOW. NO EXCEPTIONS ARE ALLOWED.
 - 7) ALL DRIP RINGS MUST BE INSTALLED TO HAVE THE RELEVANT TAPPING IN THE BOTTOM PART (THE LOWEST POINT). NO EXCEPTIONS ARE ALLOWED.
 - 8) ALL CHECK VALVES HAVE TO BE INSTALLED IN VERTICAL POSITION, UNLESS VENDOR DIFFERENT INDICATIONS.
 - 9) MECHANIZATION OF PIPING AND INSTRUMENTATION HAS BEEN PERFORMED ACCORDING WITH LICENSOR'S STANDARDS AS MINIMUM REQUIREMENT AND IT SHALL BE COMPLETED BY ENGINEERING CONTRACTOR.
 - 10) ALL "OD" LINES SHALL HAVE MAX SLOPE TOWARDS GROUND LEVEL. "OD" UNDERGROUND HEADER SHALL HAVE SLOPE TO ENSURE FREE DRAINING TOWARDS 18-TK-153 TANK.
 - 11) ALL INSTRUMENT IN THIS PAGE HAVE PREFIX NO. OF 11. FOR EXAMPLE 11-FT-1027.
 - 12) FOR STEAM AND CONDENSATE LINES CONTINUATION REFER TO DWG.: 1208-01-PR-udd-051.
 - 13) FOR COOLING WATER SUPPLY/RETURN CONTINUATION REFER TO DWG.: 1208-01-PR-udd-053.
 - 14) FOR OILY WATER DRAINAGE CONTINUATION REFER TO DWG.: 1208-01-PR-udd-055.
 - 15) FOR CHEMICAL DRAINAGE CONTINUATION REFER TO DWG.: 1208-01-PR-udd-056.
 - 16) FOR CLOSE DRAINAGE CONTINUATION REFER TO DWG.: 1208-01-PR-udd-057.
 - 17) FOR UREA BLOW DOWN NETWORK REFER TO DWG.: 1208-01-SA-udd-003.

HOLD
- DELETED
- DELETED

EQUIPMENT LIST	
11-T-102	11-P-115A/B

LICENSOR REF. : P59

DE	EXT	AFC	A			
Eng. Phase	Purpose of Distribution (POD)	Purpose of Issue (POI)	Owner's Action			
04	31.12.2023	APPROVED FOR CONSTRUCTION	M.Fahrasi A.Azma A.Azma M.Saromi			
03	30.08.2023	APPROVED FOR CONSTRUCTION	M.Fahrasi A.Azma A.Azma M.Saromi			
02	21.11.2022	APPROVED FOR CONSTRUCTION (WITH HOLD)	M.Fahrasi M.Yadranpanahi A.Azma M.Saromi			
01	12.06.2018	APPROVED FOR CONSTRUCTION (WITH HOLD)	M.Yadranpanahi A.Azma A.Azma M.Saromi			
00	04.04.2017	ISSUED FOR ENGINEERING	F.Mizaki A.Habibi A.Azma M.Saromi			
REV.	DATE	DESCRIPTION	PREPARED BY	CHECKED BY	APPROVED BY	PROJECT
OWNER :	MC :	EPCC CONTRACTOR :				


THIS DOCUMENT IS THE PROPERTY OF HFC. IT IS CONFIDENTIAL AND ALL RIGHTS RESERVED. NEITHER THE WHOLE NOR PART OF THIS DOCUMENT MAY BE DISCLOSED TO ANY THIRD PARTY, REPRODUCED, STORED IN ANY RETRIEVAL SYSTEM OR TRANSMITTED IN ANY FORM OR BY ANY MEANS WITHOUT THE PRIOR WRITTEN CONSENT OF HFC.



HENGAM FERTILIZER PROJECT

PIPING AND INSTRUMENTATION DIAGRAM
PROCESS CONDENSATE TREATMENT SECTION 1 of 4

SCALE : N.T.S	OWNER PROJECT NO. : NA	DWG. NO. :	REV. :	SIZE :
1 OF 1	PIDE PROJECT NO. : 1208	1208-11-PR-PID-069	04	A1

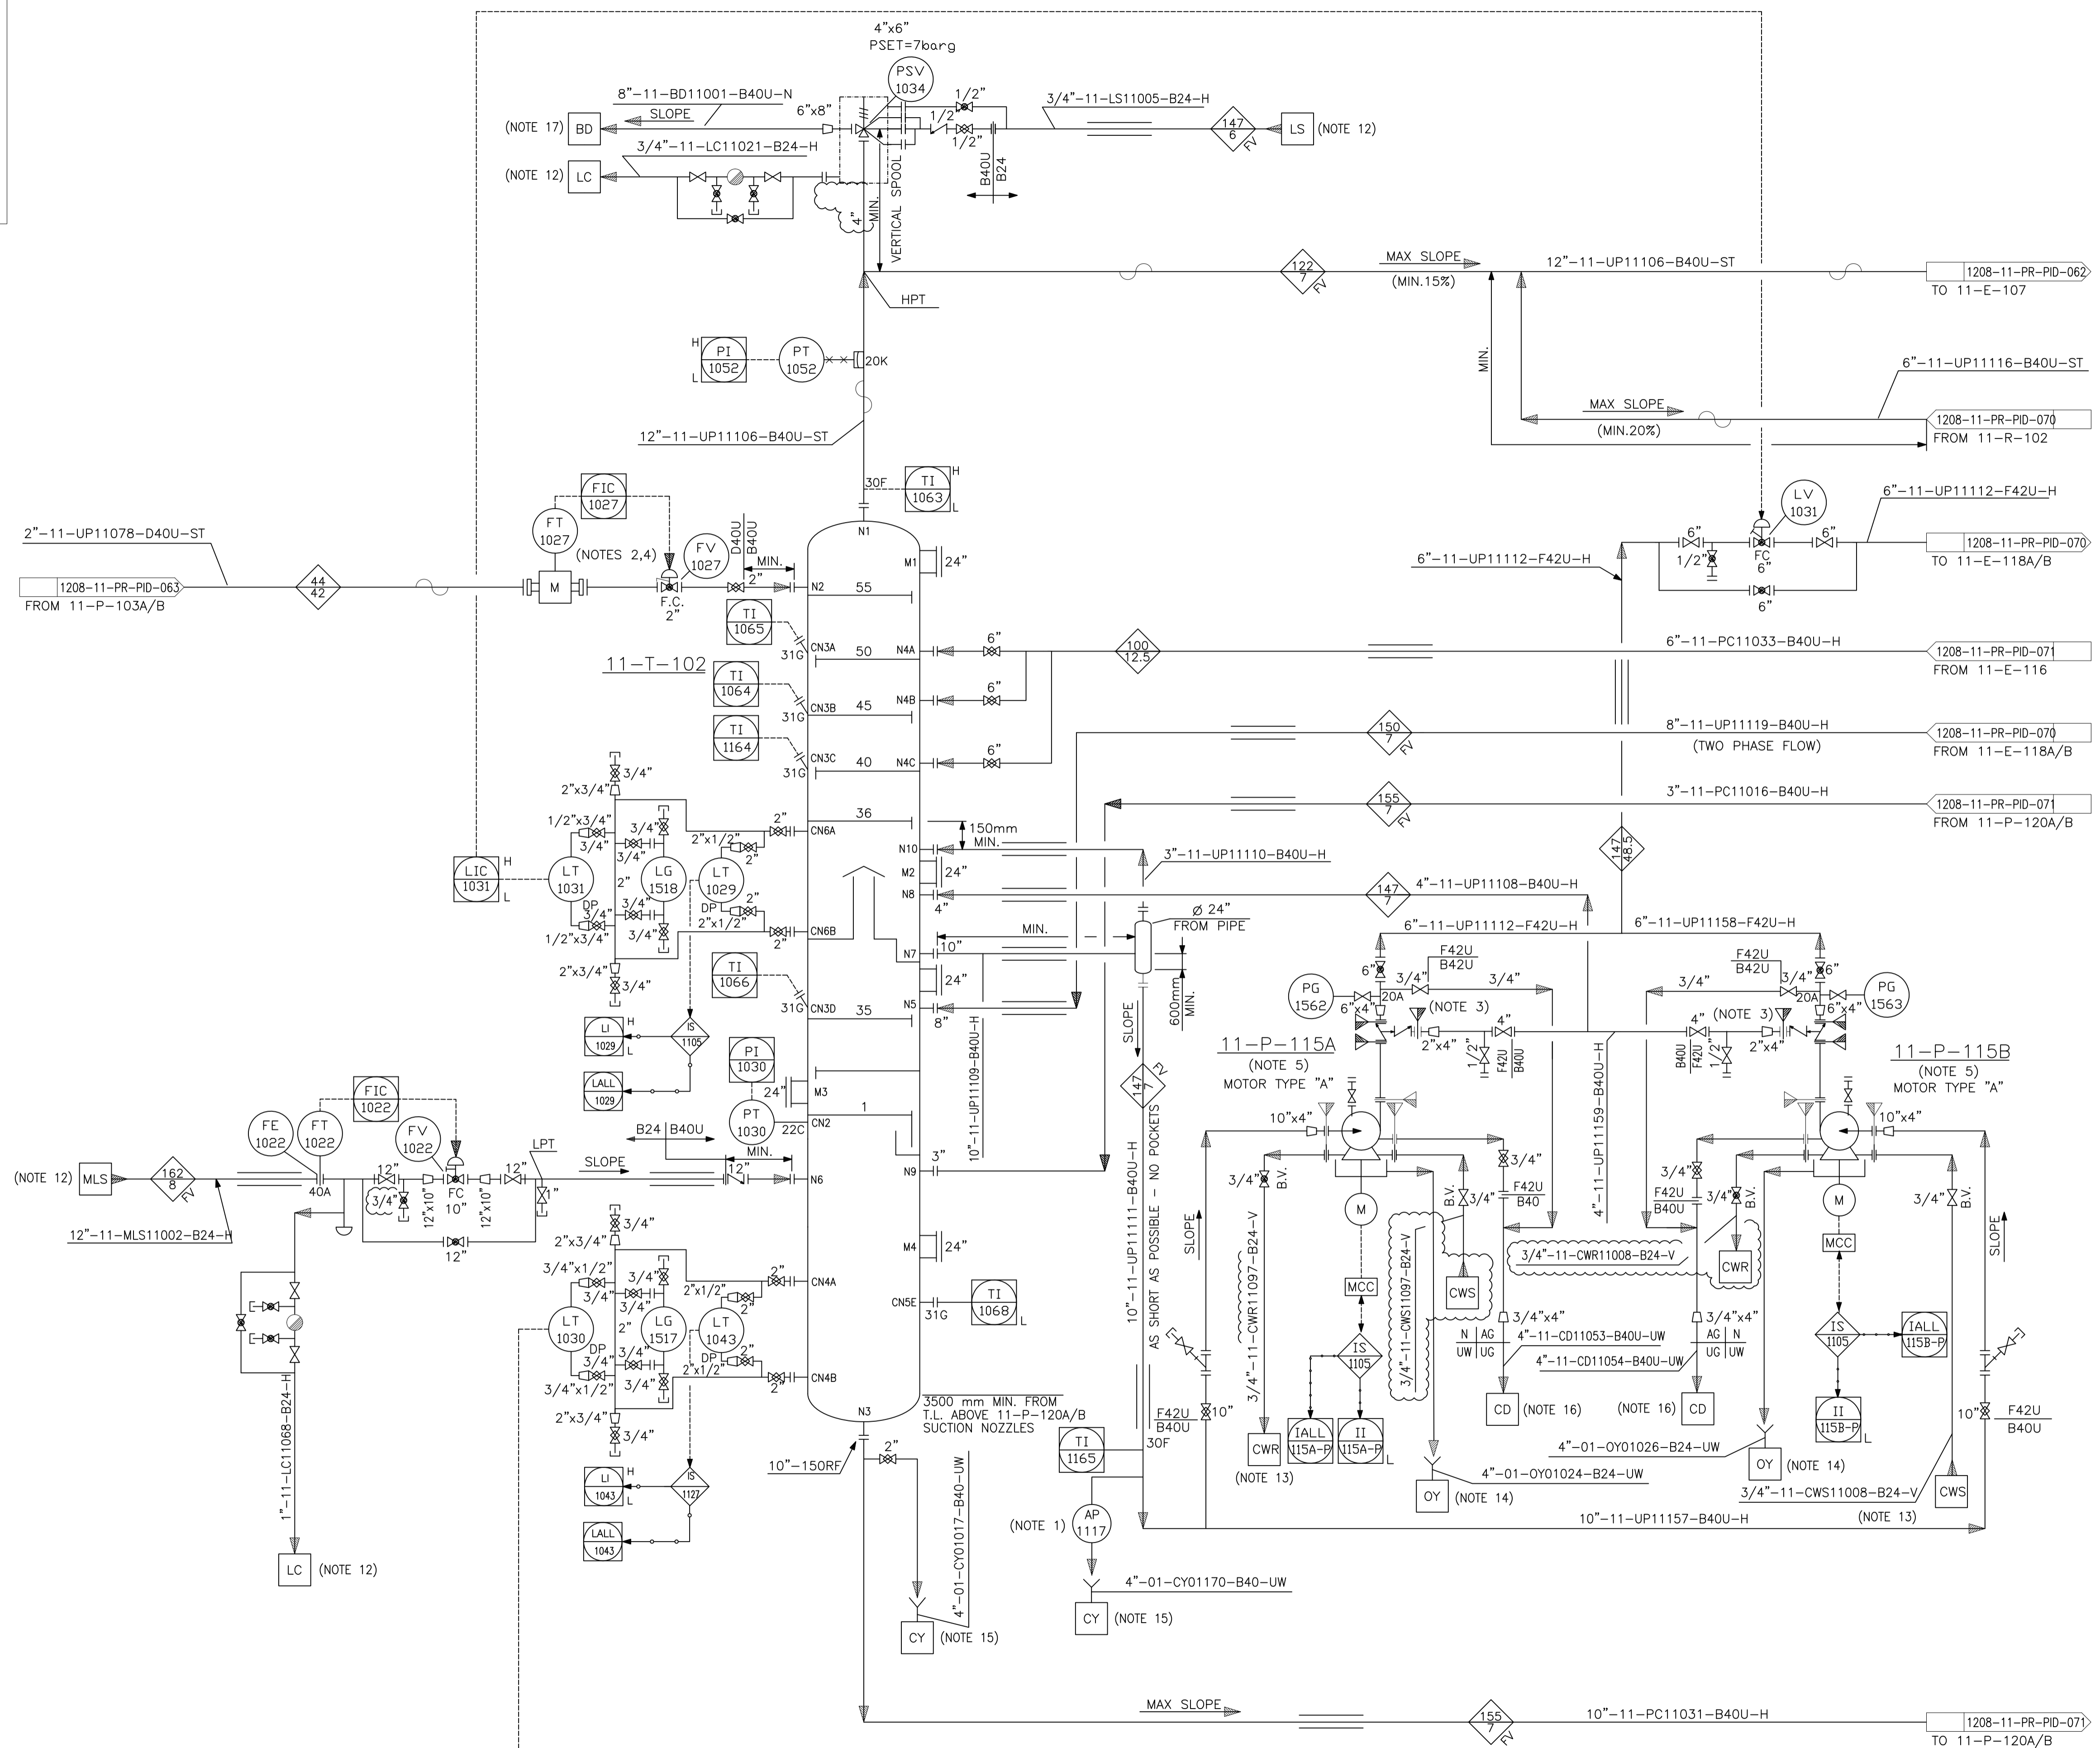

11-T-102	11-P-115A/B
DISTILLATION TOWER	HYDROLYZER FEED PUMPS
I.D. x T.L.T.L : 1900 x 28080 mm	RATED CAPACITY : 113 m ³ /hr
DESIGN PRESS. : 7 barg/F.V.	SPECIFIC GRAVITY : 0.92
DESIGN TEMP. : 185°C	DIFF. PRESSURE : 31.8 bar
INSULATION : YES	INSULATION : YES
TRIM LINE NO. : 11-PC11035-B40U-H	TRIM LINE NO. : 11-UP11223-F42U-H

- NOTES:**
- 1) FOR SAMPLE CONNECTION DETAILS AND PIPING ARRANGEMENT REFER TO P&ID 1208-11-PR-PID-080 AND 1208-11-PR-PID-081.
 - 2) TWO PHASE FLOW REINFORCED SUPPORT.
 - 3) TO BE INSTALLED AFTER BLOWING THE HS LINES
 - 4) PSV-1035 TO BE LOCATED AS CLOSE AS POSSIBLE TO 11-R-102, BUT AT HIGHER ELEVATION THAN "BD" HEADER IN ORDER TO ENSURE SLOPE TOWARDS HEADER.
 - 5) TRIM LINE NO. FOR AP-11118: 11-UP11227-F42U-H

- GENERAL NOTES:**
- 1) FOR SYMBOLS AND OTHER DETAILS PLEASE REFER TO PID 1208-01-PR-PID-051
 - 2) FOR ALL "CD" LINES THE FLANGES ARE TO BE LOCATED AT MINIMUM DISTANCE FROM GRADE. ALL "CD" LINES SHALL HAVE SLOPE TO ENSURE FREE DRAINING TOWARDS 11-TK-104 TANK.
 - 3) SAFETY AND CONTROL VALVE IN/OUT LINES AND RELATED BYPASS LINE SIZE TO BE VERIFIED DURING ENGINEERING PHASE, AFTER CONTROL VALVES AND SAFETY VALVES SELECTION.
 - 4) \blacktriangleright MFR CONTRACTOR
 - 5) WHERE IT'S INDICATED "MIN" OR "MINIMUM DISTANCE" THE LENGTH OF THE INTERESTED PIPE TO BE KEPT AS SHORT AS POSSIBLE (ABOUT ONE HUNDRED MILLIMETERS) IN ORDER TO PREVENT DEAD ZONE.
 - 6) FOR THE DESCRIPTION OF ATTRIBUTES OF HYDRAULIC CONSTRAINTS OF LINES (SELF DRAINING, SLOPE, GRAVITY FLOW, ETC.) REFER TO DOC. "GENERAL REQUIREMENTS FOR PIPING" WHERE SPECIFIC REQUIREMENTS ARE INDICATED THAT PIPING SHALL FOLLOW. NO EXCEPTIONS ARE ALLOWED.
 - 7) ALL DRIP RINGS MUST BE INSTALLED TO HAVE THE RELEVANT TAPPING IN THE BOTTOM PART (THE LOWEST POINT). NO EXCEPTIONS ARE ALLOWED.
 - 8) ALL CHECK VALVES HAVE TO BE INSTALLED IN VERTICAL POSITION, UNLESS VENDOR DIFFERENT INDICATIONS.
 - 9) MECHANIZATION OF PIPING AND INSTRUMENTATION HAS BEEN PERFORMED ACCORDING WITH LICENSOR'S STANDARDS AS MINIMUM REQUIREMENT AND IT SHALL BE COMPLETED BY ENGINEERING CONTRACTOR.
 - 10) ALL "OD" LINES SHALL HAVE MAX SLOPE TOWARDS GROUND LEVEL. "OD" UNDERGROUND HEADER SHALL HAVE SLOPE TO ENSURE FREE DRAINING TOWARDS 18-TK-153 TANK.
 - 11) ALL INSTRUMENT IN THIS PAGE HAVE PREFIX NO. OF 11. FOR EXAMPLE 11-LV-1032.
 - 12) FOR STEAM AND CONDENSATE LINES CONTINUATION REFER TO DWG.: 1208-01-PR-UDD-051.
 - 13) FOR CHEMICAL DRAINAGE CONTINUATION REFER TO DWG.: 1208-01-PR-UDD-056.
 - 14) FOR UREA BLOW DOWN NETWORK REFER TO DWG.: 1208-01-SA-UDD-003.

HOLD
~~DELETED~~
~~DELETED~~

EQUIPMENT LIST	
11-E-118A/B	11-R-102

LICENSOR REF. : P60

DE	EXT	AFC	A
Eng. Phase	Purpose of Distribution (POD)	Purpose of Issue (POI)	Owner's Action
03	26.08.2023	APPROVED FOR CONSTRUCTION	M.Fakhraei, A.Azma, A.Azma, M.Saremi
02	21.11.2022	APPROVED FOR CONSTRUCTION (WITH HOLD)	M.Fakhraei, M.Yazdarpasani, A.Azma, M.Saremi
01	12.06.2018	APPROVED FOR CONSTRUCTION (WITH HOLD)	M.Yazdarpasani, A.Azma, A.Azma, M.Saremi
00	04.04.2017	ISSUED FOR ENGINEERING	F.Mizaei, A.Habibi, A.Azma, M.Saremi


REV.	DATE	DESCRIPTION	PREPARED BY	CHECKED BY	APPROVED BY	PROJECT
OWNER :	MC :	EPC CONTRACTOR :				




PROJECT : HENGAM FERTILIZER PROJECT

PIPING AND INSTRUMENTATION DIAGRAM
PROCESS CONDENSATE TREATMENT SECTION 2 OF 4

SCALE : N.T.S	OWNER PROJECT NO. : NA	DWG. NO. : 1208-11-PR-PID-070	REV. : 03	SIZE : A1
SHT. : 1 OF 1	PIDEC PROJECT NO. : 1208			

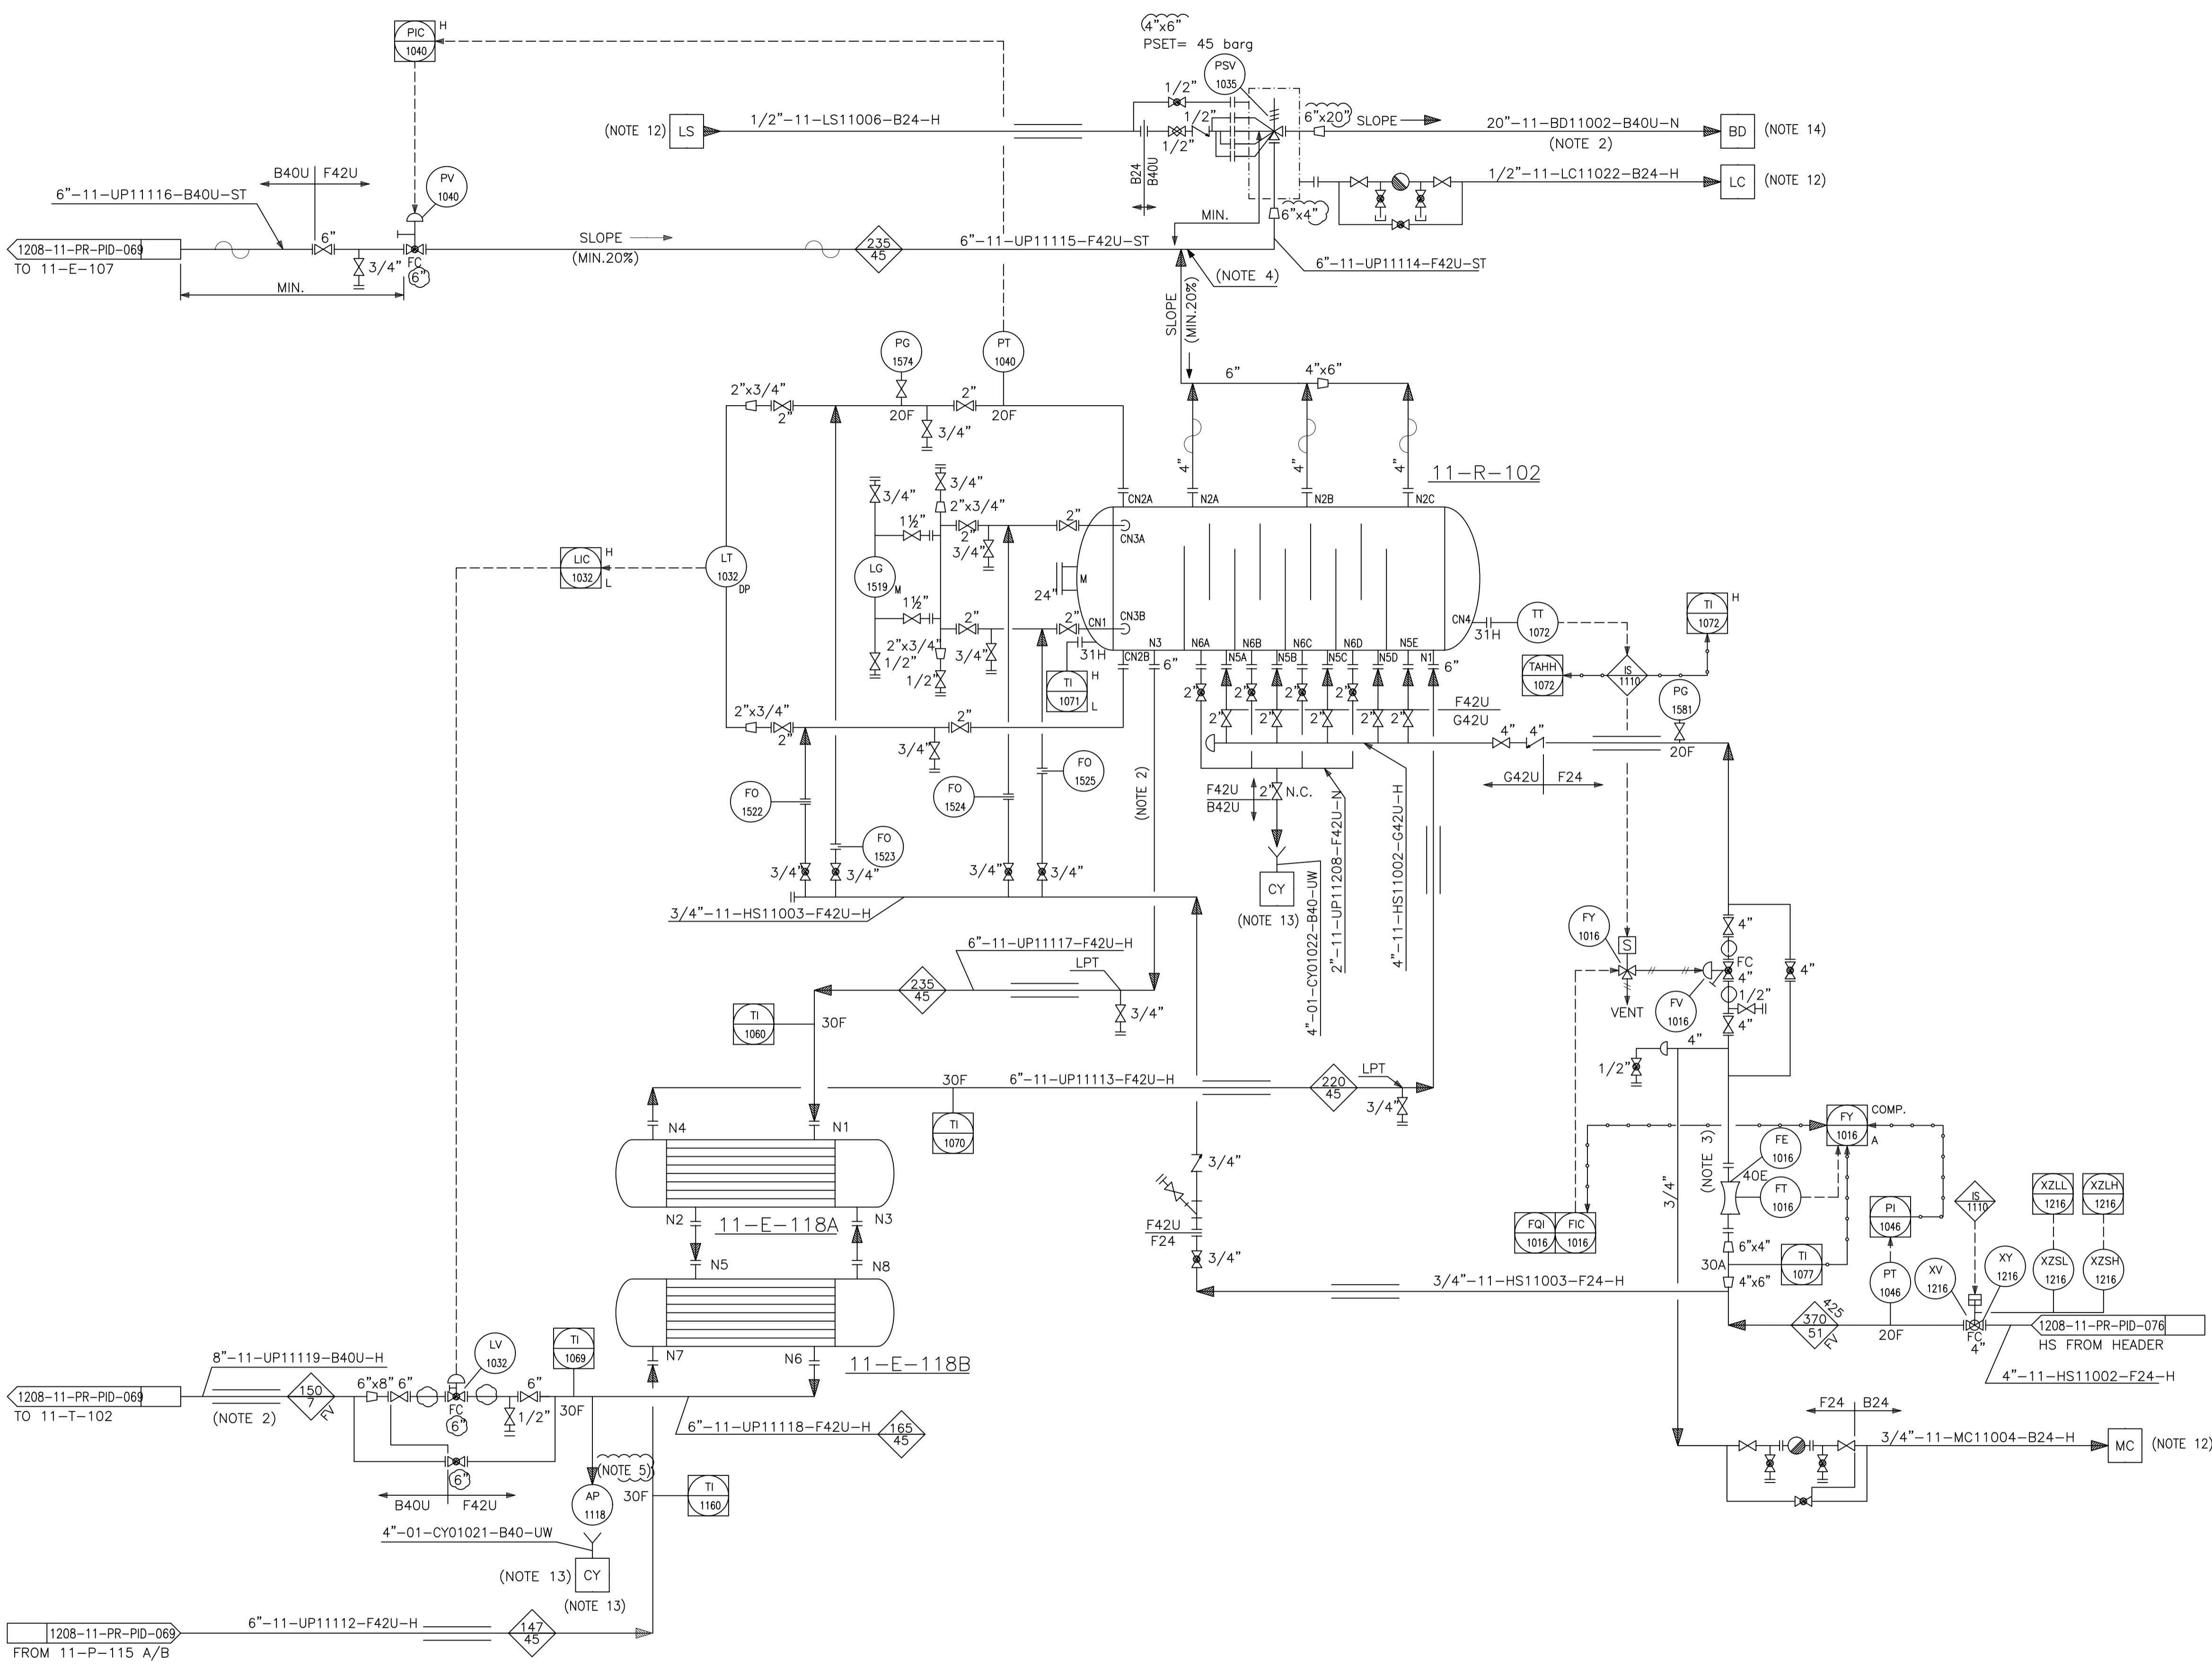

11-E-118A/B HYDROLYZER PREHEATER	11-R-102 UREA HYDROLYZER
SHELL I.D. : 650 mm	I.D. x TL: 2700 x 9000 mm
SHELL LENGTH : 8500 mm	DESIGN PRESS. : 45 barg/F.V.
DESIGN PRESS. S/T : 45/45 barg	DESIGN TEMP. : 265°C
DESIGN TEMP. S/T : 265/265°C	INSULATION : YES
INSULATION : YES	TRIM LINE NO. : 11-UP11177-F42U-H

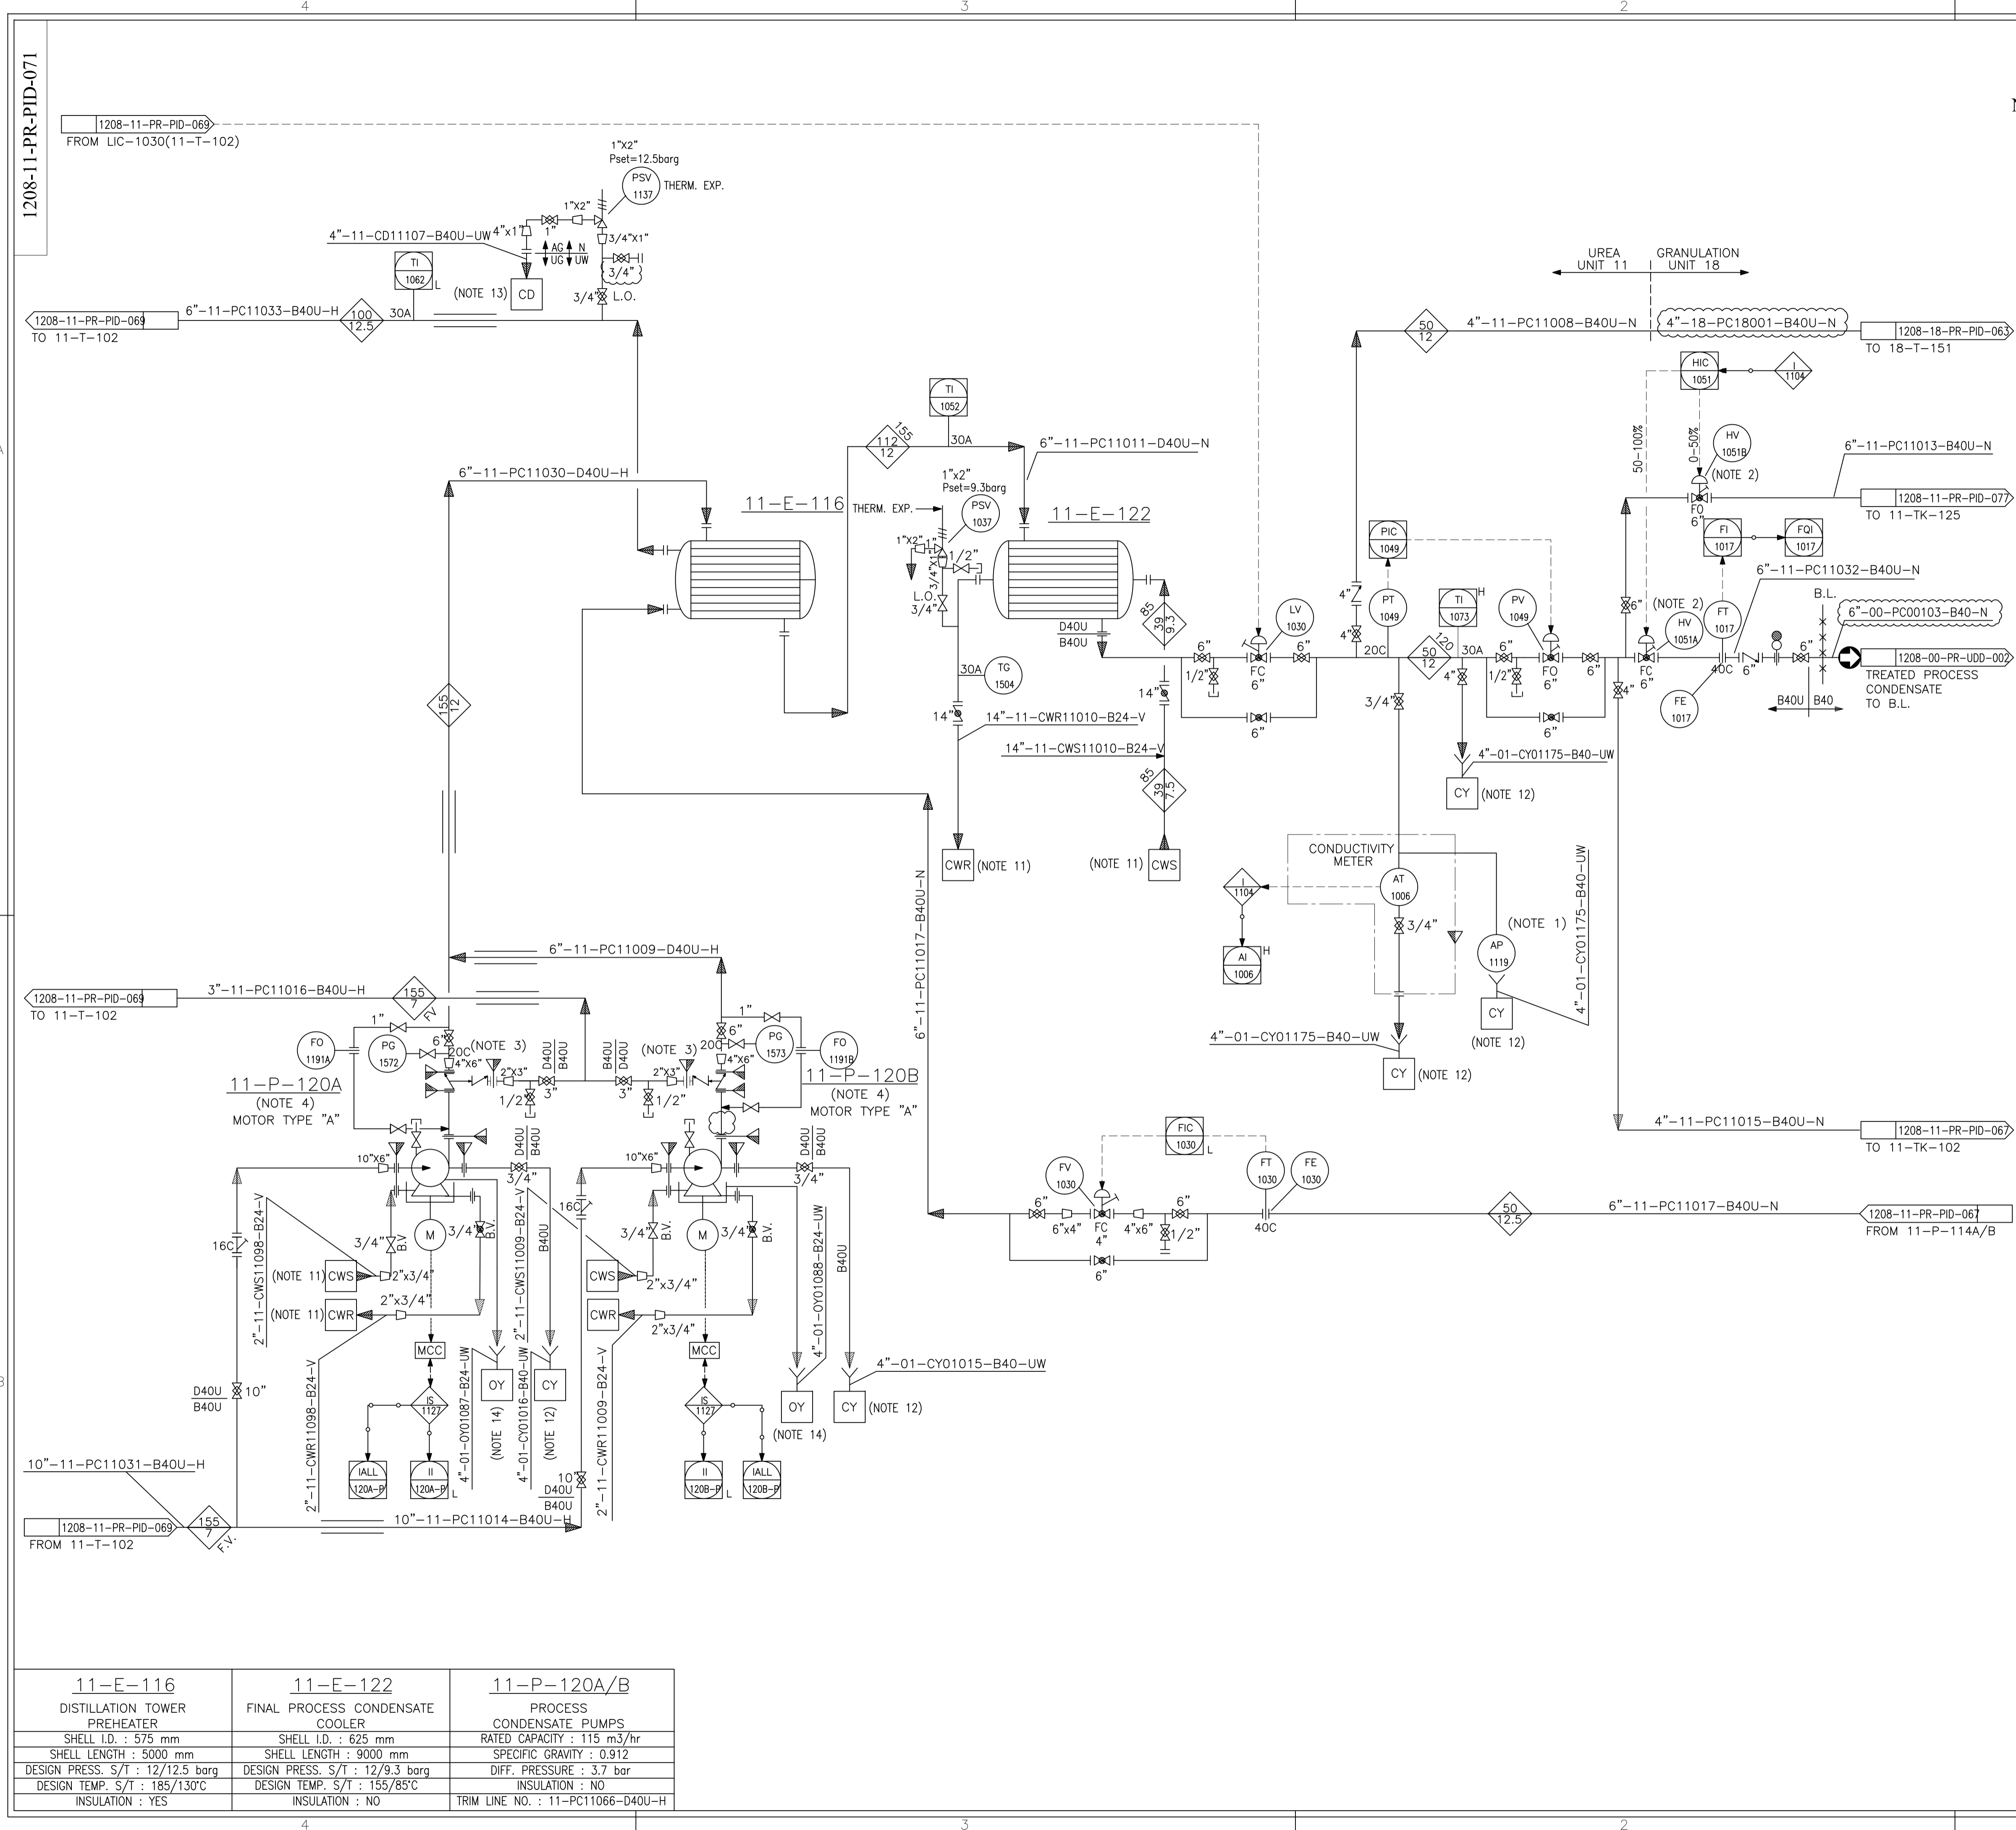

REFERENCE DRAWING	DWG. NO.
SYMBOLS AND IDENTIFICATIONS	1208-01-PR-PID-051-01

- NOTES:**
- FOR SAMPLE CONNECTION DETAILS AND PIPING ARRANGEMENT REFER TO P&ID. 1208-11-PR-PID-080 AND 1208-11-PR-PID-081.
 - HV-1051A AND HV-1051B OPENING AND CLOSING MUST BE DONE ACCORDING TO FOLLOW CURVES :

HV-1051B

HV-1051A
 - MINIMUM FLOW DEVICE AND AUTOMATIC NON RETURN VALVE TO BE SUPPLIED BY PUMP MFR. ARV TO BE INSTALLED IN VERTICAL POSITION.
 - ALL PUMPS CONNECTIONS DEFINED AS PER PUMP MFR SELECTION.

- GENERAL NOTES**
- FOR SYMBOLS AND OTHER DETAILS PLEASE REFER TO PID. 1208-01-PR-PID-051.
 - ALL "OD" LINES SHALL HAVE SLOPE TO ENSURE FREE DRAINING TOWARDS 18-TK-153 TANK.
 - SAFETY AND CONTROL VALVE IN/OUT LINES AND RELATED BY-PASS LINE SIZE TO BE VERIFIED DURING ENGINEERING PHASE, AFTER CONTROL VALVES AND SAFETY VALVES SELECTION.
 - CONTRACTOR
 - WHERE IT'S INDICATED "MIN" OR "MINIMUM DISTANCE" THE LENGTH OF THE INTERESTED PIPE TO BE KEPT AS SHORT AS POSSIBLE (ABOUT ONE HUNDRED MILLIMETERS) IN ORDER TO PREVENT DEAD ZONE.
 - FOR THE DESCRIPTION OF ATTRIBUTES OF HYDRAULIC CONSTRAINTS OF LINES (SELF DRAINING, SLOPE, GRAVITY FLOW, ETC.) REFER TO DOC. "GENERAL REQUIREMENTS FOR PIPING" WHERE SPECIFIC REQUIREMENTS ARE INDICATED THAT PIPING SHALL FOLLOW. NO EXCEPTIONS ARE ALLOWED.
 - ALL DRIP RINGS MUST BE INSTALLED TO HAVE THE RELEVANT TAPPING IN THE BOTTOM PART (THE LOWEST POINT). NO EXCEPTIONS ARE ALLOWED.
 - ALL CHECK VALVES HAVE TO BE INSTALLED IN VERTICAL POSITION, UNLESS VENDOR DIFFERENT INDICATIONS.
 - MECHANIZATION OF PIPING AND INSTRUMENTATION HAS BEEN PERFORMED ACCORDING WITH LICENSOR'S STANDARDS AS MINIMUM REQUIREMENT AND IT SHALL BE COMPLETED BY ENGINEERING CONTRACTOR.
 - ALL INSTRUMENT IN THIS PAGE HAVE PREFIX NO. OF 11. FOR EXAMPLE 11-FT-1030.
 - FOR COOLING WATER SUPPLY/RETURN CONTINUATION REFER TO DWG.: 1208-01-PR-UDD-053.
 - FOR CHEMICAL DRAINAGE CONTINUATION REFER TO DWG.: 1208-01-PR-UDD-056.
 - FOR CLOSE DRAINAGE CONTINUATION REFER TO DWG.: 1208-01-PR-UDD-057.
 - FOR OILY WATER DRAINAGE CONTINUATION REFER TO DWG.: 1208-01-PR-UDD-055.

EQUIPMENT LIST

11-E-116	11-P-120A/B
11-E-122	

HOLD
- DELETED
- DELETED

LICENSOR REF. : P61

DE	EXT	AFC	A
Eng. Phase	Purpose of Distribution (POD)	Purpose of Issue (POI)	Owner's Action
04	07.01.2024	APPROVED FOR CONSTRUCTION	M.Fahrasi, A.Azma, A.Azma, M.Sareri
03	30.08.2023	APPROVED FOR CONSTRUCTION	M.Fahrasi, A.Azma, A.Azma, M.Sareri
02	21.11.2022	APPROVED FOR CONSTRUCTION (WITH HOLD)	M.Fahrasi, M.Yazdani, A.Azma, M.Sareri
01	12.06.2018	APPROVED FOR CONSTRUCTION (WITH HOLD)	M.Yazdani, A.Azma, A.Azma, M.Sareri
00	04.04.2017	ISSUED FOR ENGINEERING	F.Mizani, A.Habibi, A.Azma, M.Sareri

OWNER:

MC:

EPCC CONTRACTOR:



PROJECT: **HENGAM FERTILIZER PROJECT**

TITLE: **PIPING AND INSTRUMENTATION DIAGRAM
PROCESS CONDENSATE TREATMENT SECTION 3 OF 4**

SCALE: N.T.S. OWNER PROJECT NO.: NA DWG. NO.: 1208-11-PR-PID-071 REV. SIZE: 04 A1
 HEIGHT: 1 OF 1 PIDE PROJECT NO.: 1208

1208-11-PR-PID-071

11-E-116	11-E-122	11-P-120A/B
DISTILLATION TOWER PREHEATER	FINAL PROCESS CONDENSATE COOLER	PROCESS CONDENSATE PUMPS
SHELL I.D. : 575 mm	SHELL I.D. : 625 mm	RATED CAPACITY : 115 m3/hr
SHELL LENGTH : 5000 mm	SHELL LENGTH : 9000 mm	SPECIFIC GRAVITY : 0.912
DESIGN PRESS. S/T : 12/12.5 barg	DESIGN PRESS. S/T : 12/9.3 barg	DIFF. PRESSURE : 3.7 bar
DESIGN TEMP. S/T : 185/130°C	DESIGN TEMP. S/T : 155/85°C	INSULATION : NO
INSULATION : YES	INSULATION : NO	TRIM LINE NO. : 11-PC11066-D40U-H

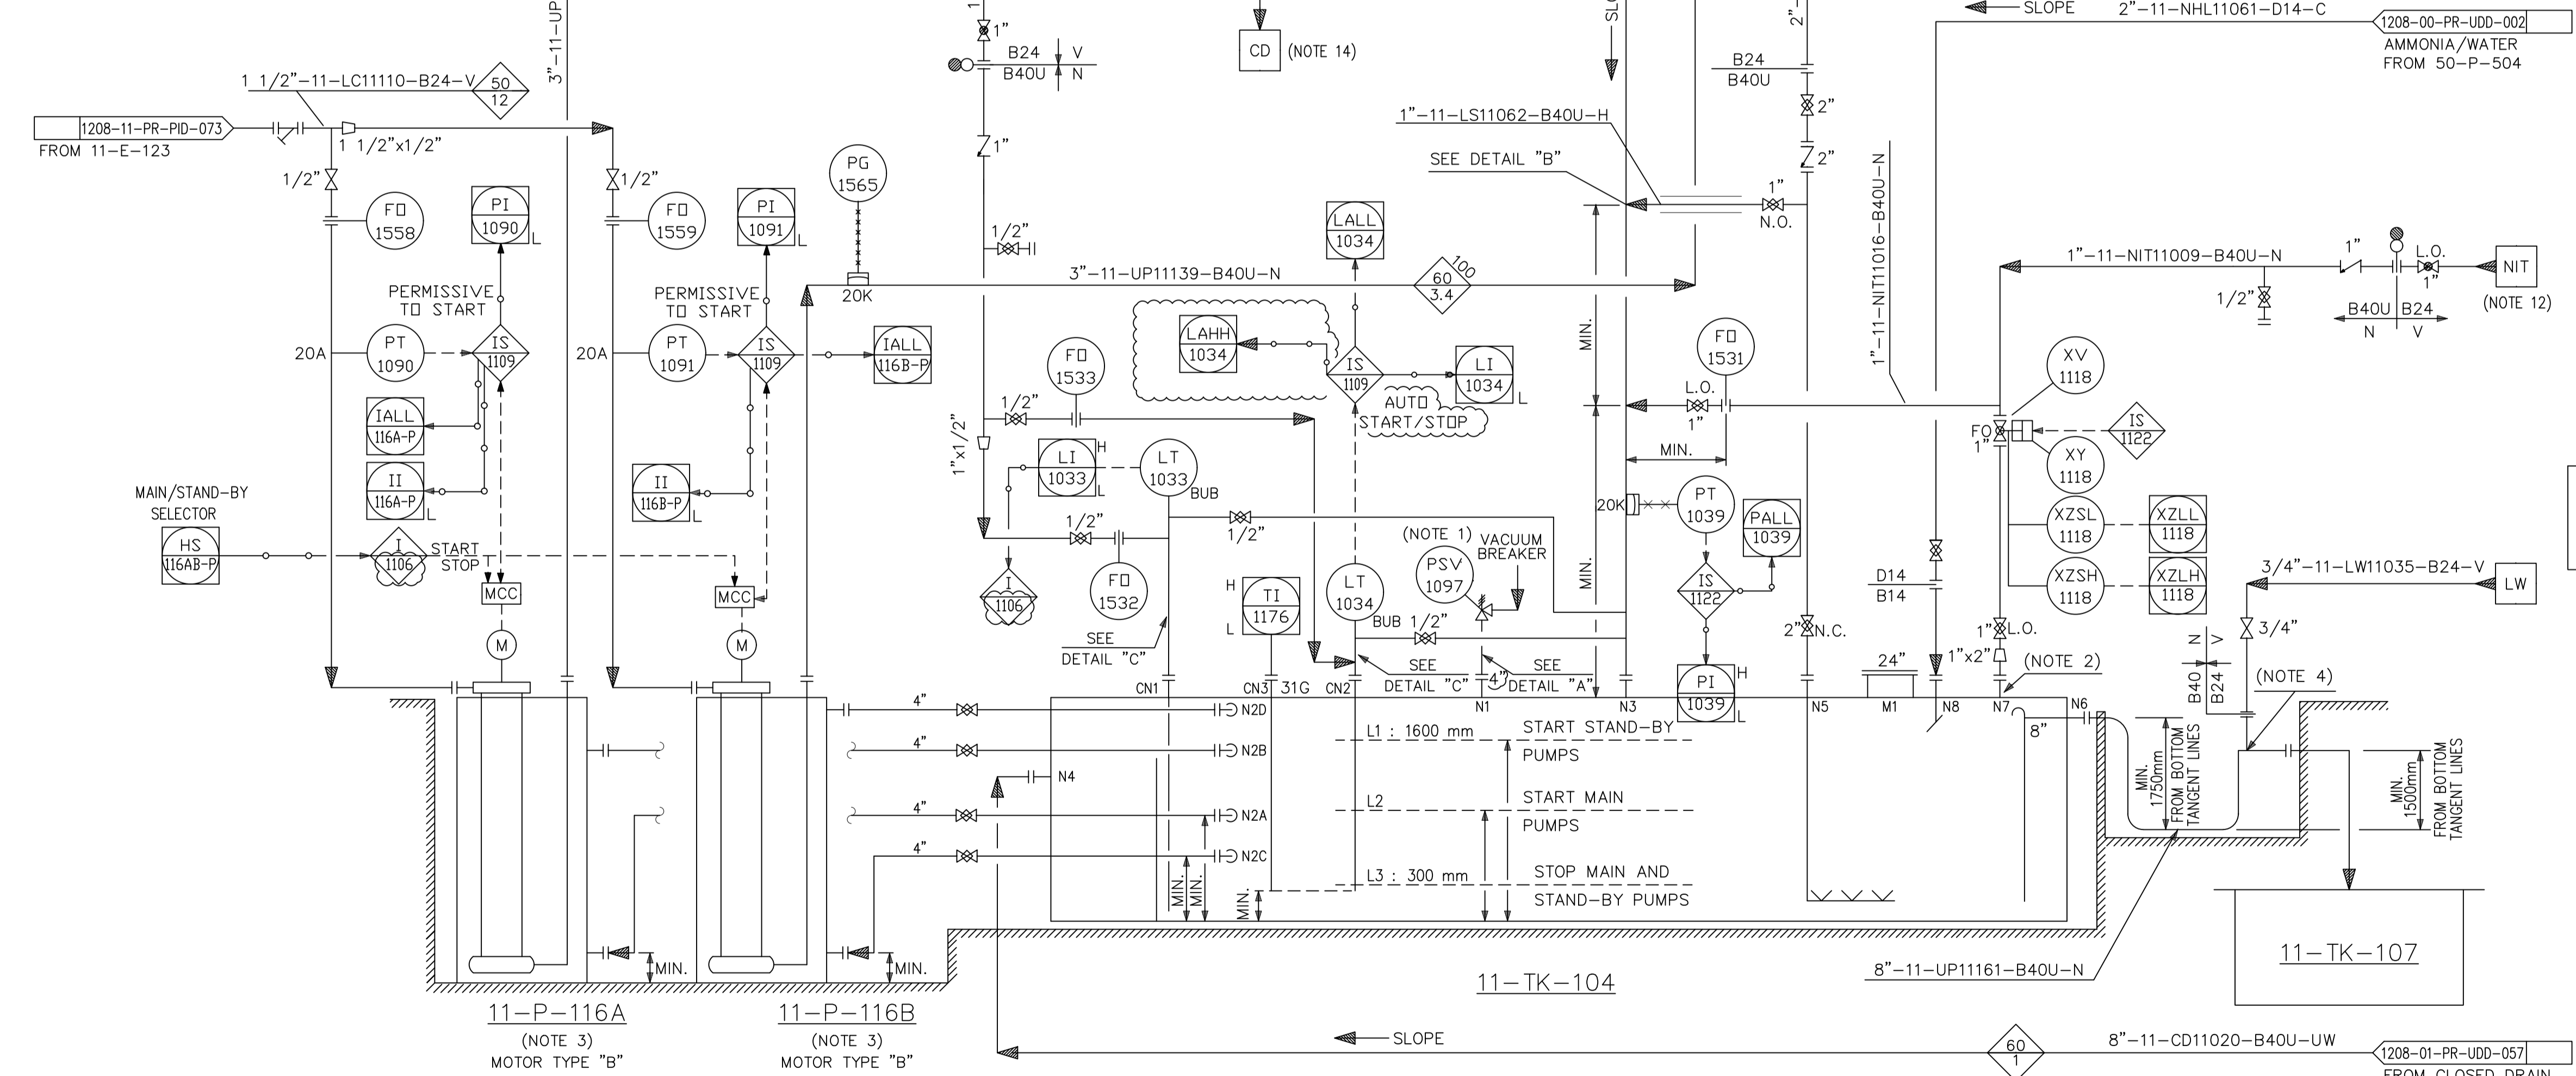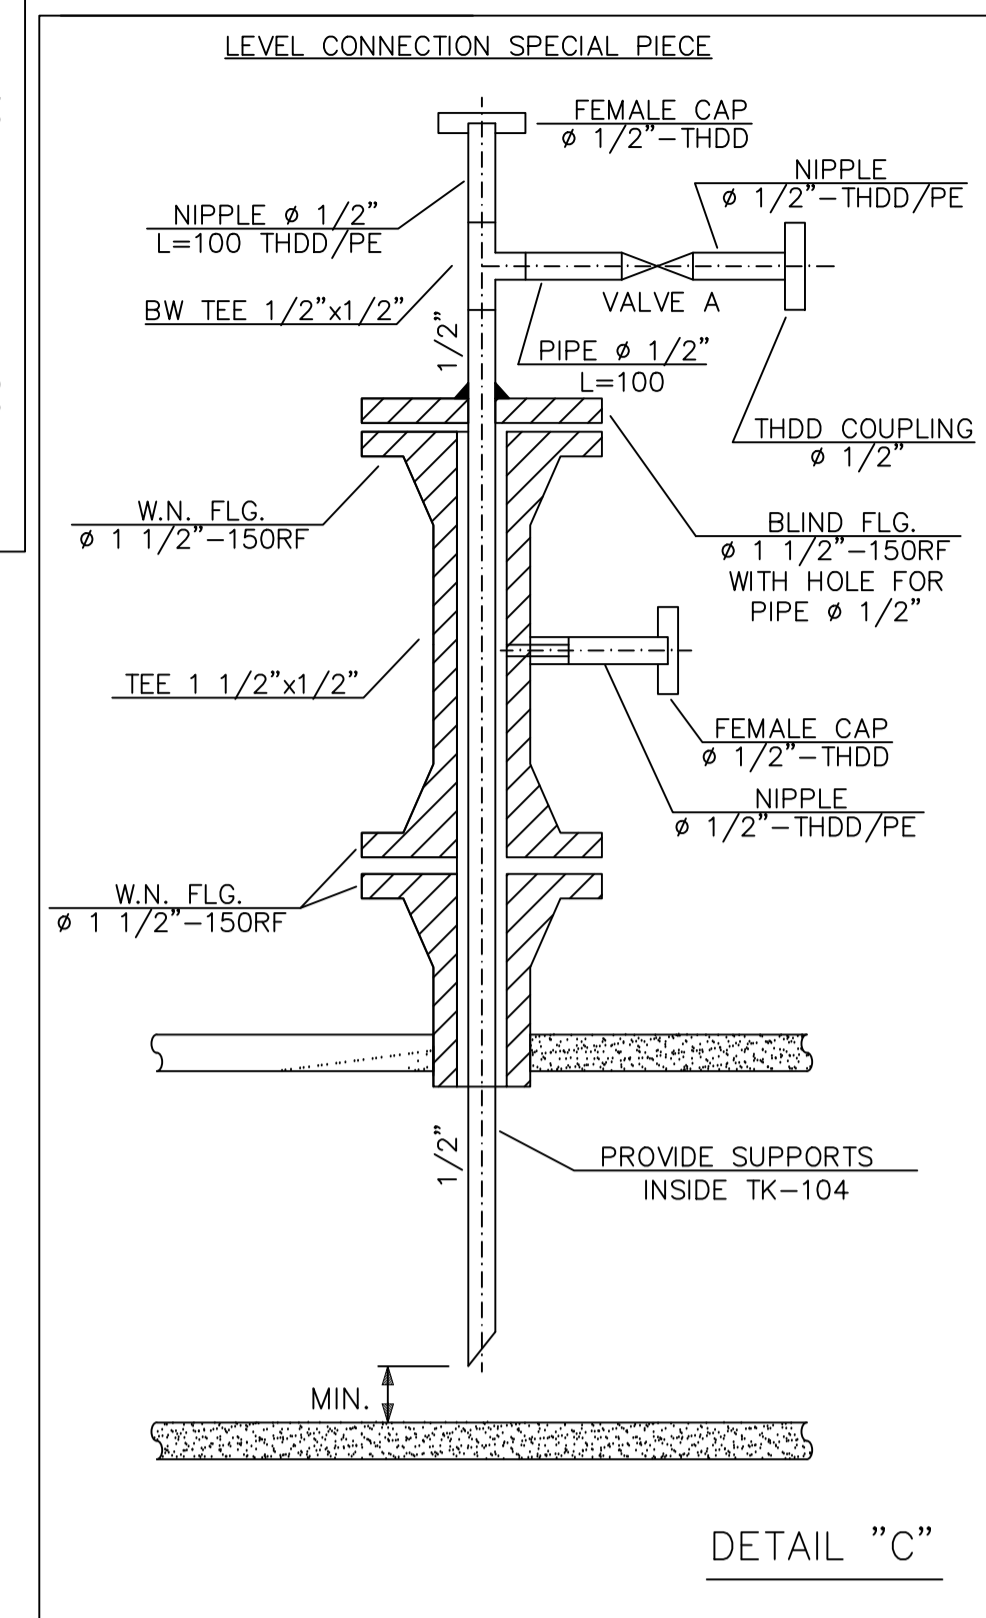

11-TK-104	11-TK-107	11-P-116A/B
CARBONATE CLOSE DRAIN TANK	CLOSE DRAIN EMERGENCY TANK	CLOSE DRAIN RECOVERY PUMPS
I.D x HEIGHT : 3000 x 2000 mm	L x H x W : 3000 x 3700 x 2000 mm	RATED CAPACITY : 10 m ³ /hr
TYPE : FLATE ROOF	TYPE : UNDERGROUND	SPECIFIC GRAVITY : 0.97
DESIGN PRESS. : HYDROST. + 0.172 barg	DESIGN PRESS. : ATM (FULL OF WATER mmH2O)	DIFF. PRESSURE : 2.47 bar
DESIGN TEMP. : 100°C	DESIGN TEMP. : 85°C	INSULATION : NO
INSULATION : NO	INSULATION : NO	AUTO START
TRIM LINE NO. : 11-UP11178-B40U-N		

REFERENCE DRAWING	DWG. NO.
SYMBOLS AND IDENTIFICATIONS	1208-01-PR-PID-051-01


- NOTES:**
- TO BE SUPPLIED BY TANK MANUFACTURER.
 - PROJECTION LENGTH TO BE MINIMIZED AND STEAM TRACED.
 - ALL PUMPS CONNECTIONS DEFINED AS PER PUMP MFR SELECTION.
 - TAPPING ON TOP OF PIPING.

- GENERAL NOTES:**
- FOR SYMBOLS AND OTHER DETAILS PLEASE REFER TO PID 1208-01-PR-PID-051.
 - FOR ALL "CD" LINES THE FLANGES ARE TO BE LOCATED AT MINIMUM DISTANCE FROM GRADE. ALL "CD" LINES SHALL HAVE SLOPE TO ENSURE FREE DRAINING TOWARDS 11-TK-104 TANK.
 - SAFETY AND CONTROL VALVE IN/OUT LINES AND RELATED BYPASS LINE SIZE TO BE VERIFIED DURING ENGINEERING PHASE, AFTER CONTROL VALVES AND SAFETY VALVES SELECTION.
 - MFR CONTRACTOR
 - WHERE IT'S INDICATED "MIN" OR "MINIMUM DISTANCE" THE LENGTH OF THE INTERESTED PIPE TO BE KEPT AS SHORT AS POSSIBLE (ABOUT ONE HUNDRED MILLIMETERS) IN ORDER TO PREVENT DEAD ZONE.
 - FOR THE DESCRIPTION OF ATTRIBUTES OF HYDRAULIC CONSTRAINTS OF LINES (SELF DRAINING, SLOPE, GRAVITY FLOW, ETC.) REFER TO DOC. "GENERAL REQUIREMENTS FOR PIPING" WHERE SPECIFIC REQUIREMENTS ARE INDICATED THAT PIPING SHALL FOLLOW. NO EXCEPTIONS ARE ALLOWED.
 - ALL DRIP RINGS MUST BE INSTALLED TO HAVE THE RELEVANT TAPPING IN THE BOTTOM PART (THE LOWEST POINT). NO EXCEPTIONS ARE ALLOWED.
 - ALL CHECK VALVES HAVE TO BE INSTALLED IN VERTICAL POSITION, UNLESS VENDOR DIFFERENT INDICATIONS.
 - MECHANIZATION OF PIPING AND INSTRUMENTATION HAS BEEN PERFORMED ACCORDING WITH LICENSOR'S STANDARDS AS MINIMUM REQUIREMENT AND IT SHALL BE COMPLETED BY ENGINEERING CONTRACTOR.
 - ALL INSTRUMENT IN THIS PAGE HAVE PREFIX NO. OF 11. FOR EXAMPLE 11-HV-1017.
 - FOR STEAM AND CONDENSATE LINES CONTINUATION REFER TO DWG.: 1208-01-PR-IDD-051.
 - FOR NITROGEN LINES CONNECTION REFER DWG.: 1208-01-PR-IDD-052.
 - FOR CHEMICAL DRAINAGE CONTINUATION REFER TO TO DWG.: 1208-01-PR-IDD-056.
 - FOR CLOSE DRAINAGE CONTINUATION REFER TO DWG.: 1208-01-PR-IDD-057.
 - FOR FLARE CONTINUATION REFER TO DWG.: 1208-97-SA-PID-014.

HOLD
- DELETED

EQUIPMENT LIST

11-TK-104	11-P-116A/B
11-TK-107	

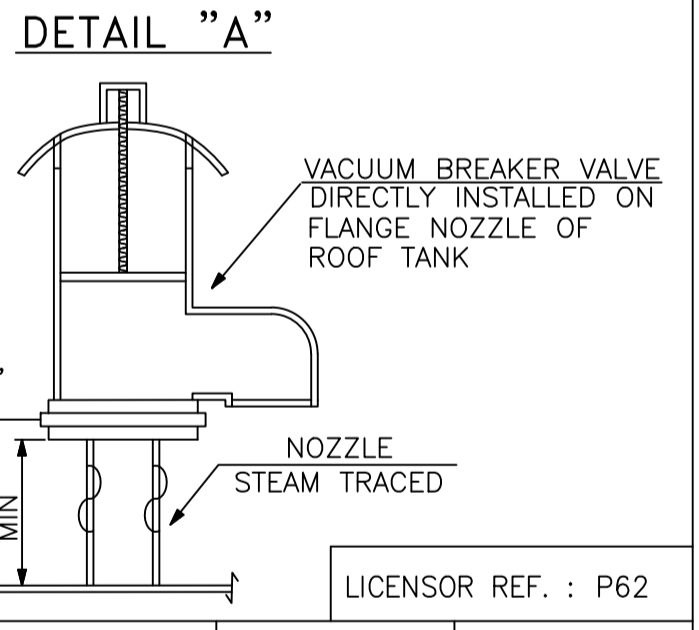

DE	EXT	AFC	A
Eng. Phase	Purpose of Distribution (POD)	Purpose of Issue (POI)	Owner's Action
03	30.08.2023	APPROVED FOR CONSTRUCTION	M.Fakhraei, A.Azma, A.Azma, M.Saremi
02	21.11.2022	APPROVED FOR CONSTRUCTION (WITH HOLD)	M.Fakhraei, M.Yazdparast, A.Azma, M.Saremi
01	12.06.2018	APPROVED FOR CONSTRUCTION (WITH HOLD)	M.Yazdparast, A.Azma, A.Azma, M.Saremi
00	04.04.2017	ISSUED FOR ENGINEERING	F.Mizaei, A.Habibi, A.Azma, M.Saremi

OWNER:

MC:


EPC CONTRACTOR:


PROJECT: **HENGAM FERTILIZER PROJECT**

TITLE: **PIPING AND INSTRUMENTATION DIAGRAM**
PROCESS CONDENSATE TREATMENT SECTION 4 OF 4

SCALE: N.T.S. OWNER PROJECT NO.: NA DWG. NO.: 1208-11-PR-PID-072 REV: 03 SIZE: A1


SHT.: 1 OF 1 PIDEC PROJECT NO.: 1208

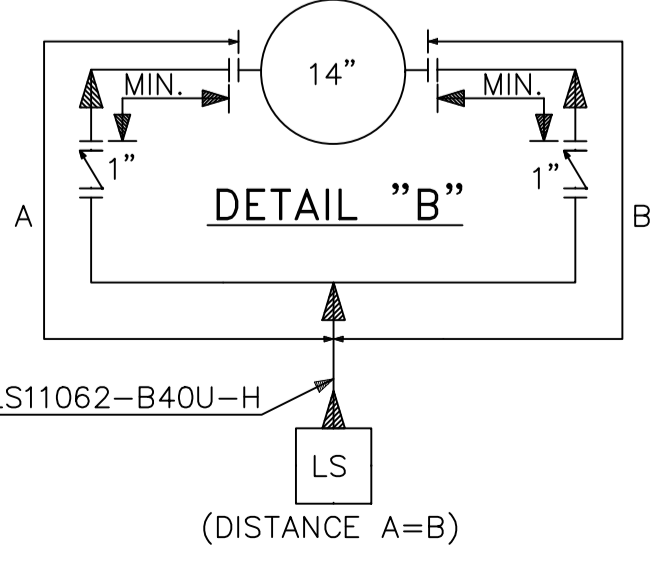

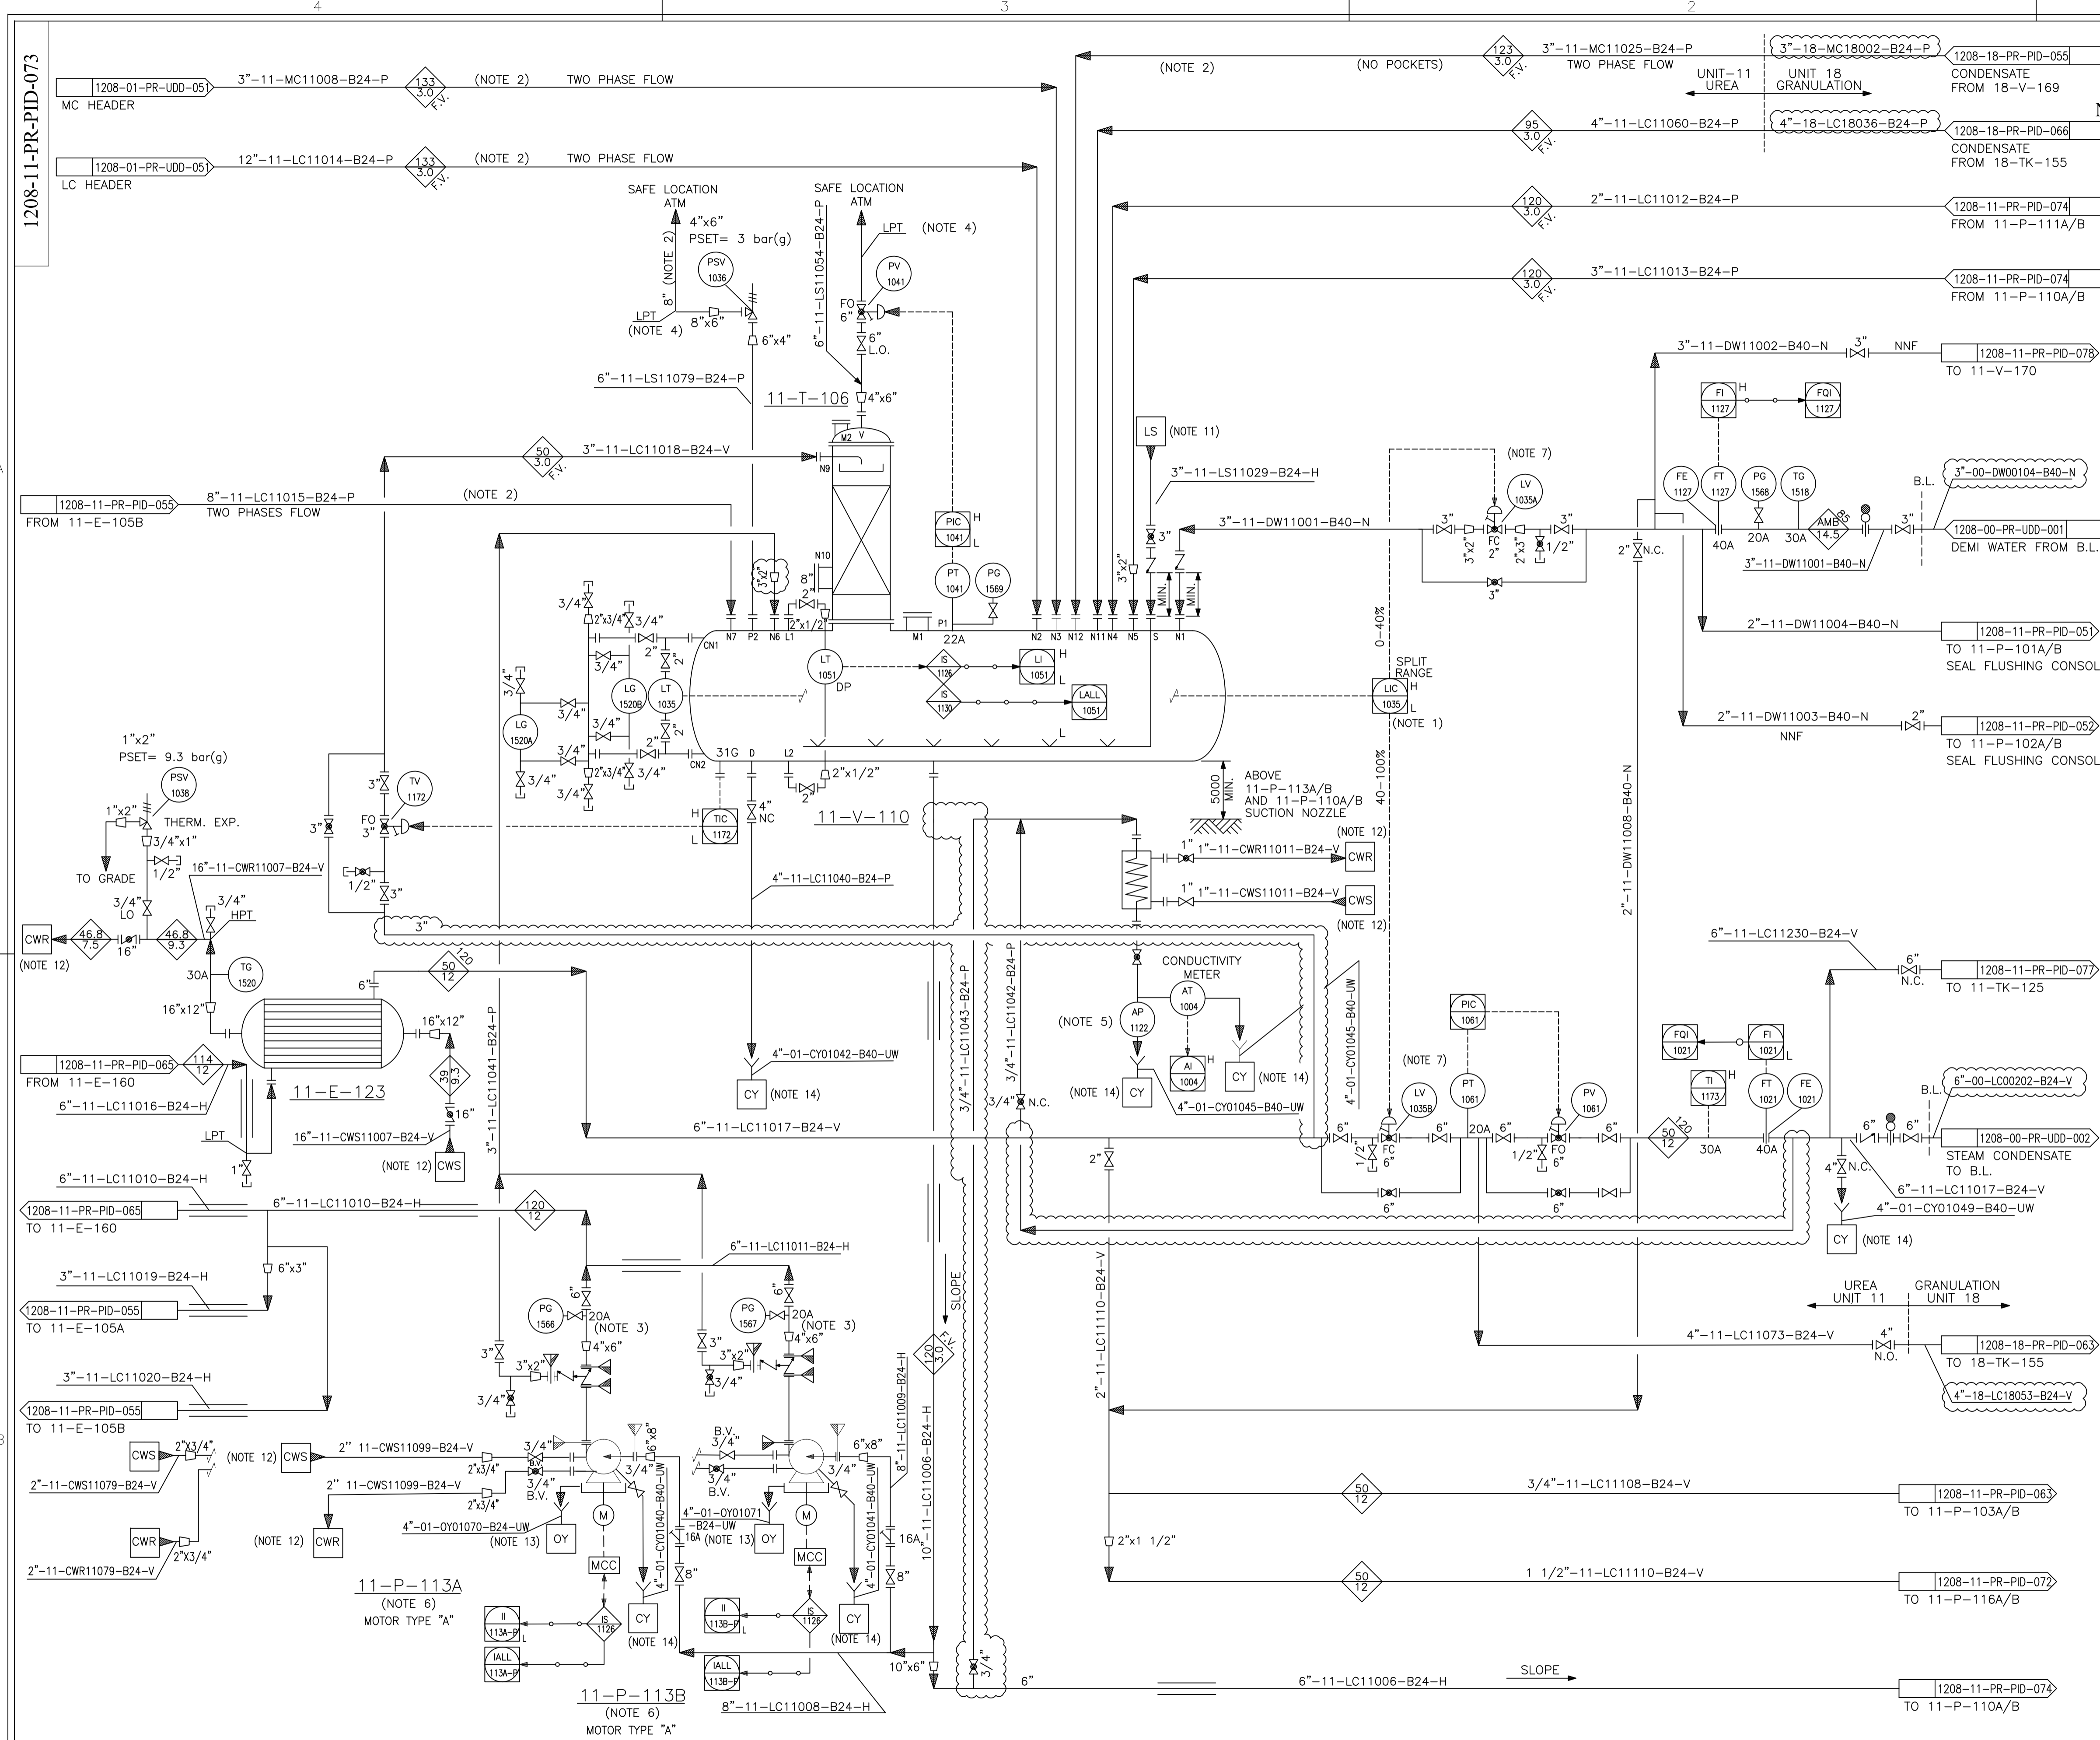

REFERENCE DRAWING	DWG. NO.
SYMBOLS AND IDENTIFICATIONS	1208-01-PR-PID-051-01

- NOTES:**
- 1) LV-1035A/B SHALL BE OPERATED SEPARATELY WHEN THE LEVEL CONTROLLER IS MANUAL MODE.
 - 2) PROVIDE TWO PHASE FLOW REINFORCED SUPPORT.
 - 3) MINIMUM FLOW DEVICE TO BE SUPPLIED BY VENDOR; AUTOMATIC NON RETURN BY-PASS (TO BE SUPPLIED BY PUMPS MFR.).
 - 4) DRIP HOLE d=13mm AT LOW POINT AND SHALL BE PIPED TO GRADE LEVEL.
 - 5) FOR SAMPLE CONNECTION DETAILS AND PIPING ARRANGEMENT REFER TO P&ID 1208-11-PR-PID-080 AND 1208-11-PR-PID-081.
 - 6) ALL PUMPS CONNECTIONS DEFINED AS PER PUMP MFR SELECTION.
 - 7) SPLIT CURVE FOR LV-1035 A/B AS FOLLOWING:

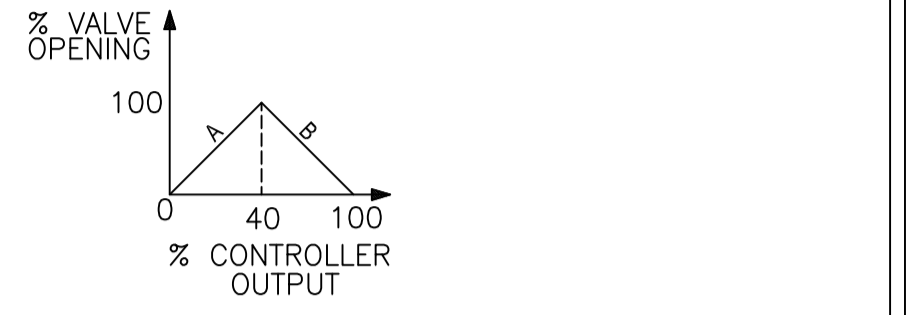

- GENERAL NOTES:**
- 1) FOR SYMBOLS AND OTHER DETAILS PLEASE REFER TO PID. 1208-01-PR-PID-051.
 - 2) FOR ALL "CD" LINES THE FLANGES ARE TO BE LOCATED AT MINIMUM DISTANCE FROM GRADE. ALL "CD" LINES SHALL HAVE SLOPE TO ENSURE FREE DRAINING TOWARDS 11-TK-104 TANK.
 - 3) SAFETY AND CONTROL VALVE IN/OUT LINES AND RELATED BY-PASS LINE SIZE TO BE VERIFIED DURING ENGINEERING PHASE, AFTER CONTROL VALVES AND SAFETY VALVES SELECTION.
 - 4) CONTRACTOR
 - 5) WHERE IT'S INDICATED "MIN" OR "MINIMUM DISTANCE" THE LENGTH OF THE INTERESTED PIPE TO BE KEPT AS SHORT AS POSSIBLE (ABOUT ONE HUNDRED MILLIMETERS) IN ORDER TO PREVENT DEAD ZONE.
 - 6) FOR THE DESCRIPTION OF ATTRIBUTES OF HYDRAULIC CONSTRAINTS OF LINES (SELF DRAINING, SLOPE, GRAVITY FLOW, ETC.) REFER TO DOC. "GENERAL REQUIREMENTS FOR PIPING" WHERE SPECIFIC REQUIREMENTS ARE INDICATED THAT PIPING SHALL FOLLOW. NO EXCEPTIONS ARE ALLOWED.
 - 7) ALL DRIP RINGS MUST BE INSTALLED TO HAVE THE RELEVANT TAPPING IN THE BOTTOM PART (THE LOWEST POINT). NO EXCEPTIONS ARE ALLOWED.
 - 8) ALL CHECK VALVES HAVE TO BE INSTALLED IN VERTICAL POSITION, UNLESS VENDOR DIFFERENT INDICATIONS.
 - 9) MECHANIZATION OF PIPING AND INSTRUMENTATION HAS BEEN PERFORMED ACCORDING WITH LICENSOR'S STANDARDS AS MINIMUM REQUIREMENT AND IT SHALL BE COMPLETED BY ENGINEERING CONTRACTOR.
 - 10) ALL INSTRUMENT IN THIS PAGE HAVE PREFIX NO. OF 11. FOR EXAMPLE 11-FI-1127.
 - 11) FOR STEAM AND CONDENSATE LINES CONTINUATION REFER TO DWG.: 1208-01-PR-UDD-051.
 - 12) FOR COOLING WATER SUPPLY/RETURN CONTINUATION REFER TO DWG.: 1208-01-PR-UDD-053.
 - 13) FOR OILY WATER DRAINAGE CONTINUATION REFER TO DWG.: 1208-01-PR-UDD-055.
 - 14) FOR CHEMICAL DRAINAGE CONTINUATION REFER TO TO DWG.: 1208-01-PR-UDD-056.

HOLD
- DELETED
- DELETED

EQUIPMENT LIST

11-T-106	11-E-123	11-P-113A/B	11-V-110
----------	----------	-------------	----------

LICENSOR REF. : P63

DE	EXT	AFC	OWNER'S ACTION
Eng. Phase	Purpose of Distribution (POD)	Purpose of Issue (POI)	Owner's Action
04	01.01.2024	APPROVED FOR CONSTRUCTION	M.Fahrmani, A.Azma, A.Azma, M.Saromi
03	09.09.2023	APPROVED FOR CONSTRUCTION	M.Fahrmani, A.Azma, A.Azma, M.Saromi
02	22.11.2022	APPROVED FOR CONSTRUCTION (WITH HOLD)	M.Fahrmani, M.Yazdani, A.Azma, M.Saromi
01	12.06.2018	APPROVED FOR CONSTRUCTION (WITH HOLD)	M.Yazdani, A.Azma, A.Azma, M.Saromi
00	04.04.2017	ISSUED FOR ENGINEERING	F.Mizake, A.Habibi, A.Azma, M.Saromi

THIS DOCUMENT IS THE PROPERTY OF HFC. IT IS CONFIDENTIAL AND ALL RIGHTS RESERVED. NEITHER THE WHOLE NOR PART OF THIS DOCUMENT MAY BE DISCLOSED TO ANY THIRD PARTY. REPRODUCED, STORED IN ANY RETRIEVAL SYSTEM OR TRANSMITTED IN ANY FORM OR BY ANY MEANS WITHOUT THE PRIOR WRITTEN CONSENT OF HFC.

OWNER:

MC:


EPCC CONTRACTOR:

PROJECT: **HENGAM FERTILIZER PROJECT**

TITLE: **PIPING AND INSTRUMENTATION DIAGRAM**
STEAM CONDENSATE RECOVERY SYSTEM

11-T-106	11-V-110	11-P-113A/B	11-E-123
STEAM RECOVERY TOWER	STEAM CONDENSATE ACCUMULATOR	STEAM CONDENSATE PUMPS	STEAM CONDENSATE COOLER
I.D. x T.L.T.L : 1560 x 2500 mm	I.D. x T.L.T.L : 3330 x 9000 mm	RATED CAPACITY : 104 m ³ /hr	SHELL LENGTH : 6000 mm
DESIGN PRESS. : 3.5/F.V. barg	DESIGN PRESS. : 3.5/F.V. barg	SPECIFIC GRAVITY : 0.943	SHELL I.D. : 725 mm
DESIGN TEMP. : 180°C	DESIGN TEMP. : 180°C	DIFF. PRESSURE : 6.88 bar	DESIGN TEMP. S/T : 12/9.3 barg
INSULATION : YES	INSULATION : YES	INSULATION : NO	DESIGN TEMP. S/T : 150/85°C
TRIM LINE NO. : 11-LC11079-B24-H	TRIM LINE NO. : 11-LC11233-B24-H		

SCALE: N.T.S	OWNER PROJECT NO.: NA	DWG. NO.:	REV.:	SIZE:
1/1	PIDEC PROJECT NO.: 1208	1208-11-PR-PID-073	04	A1

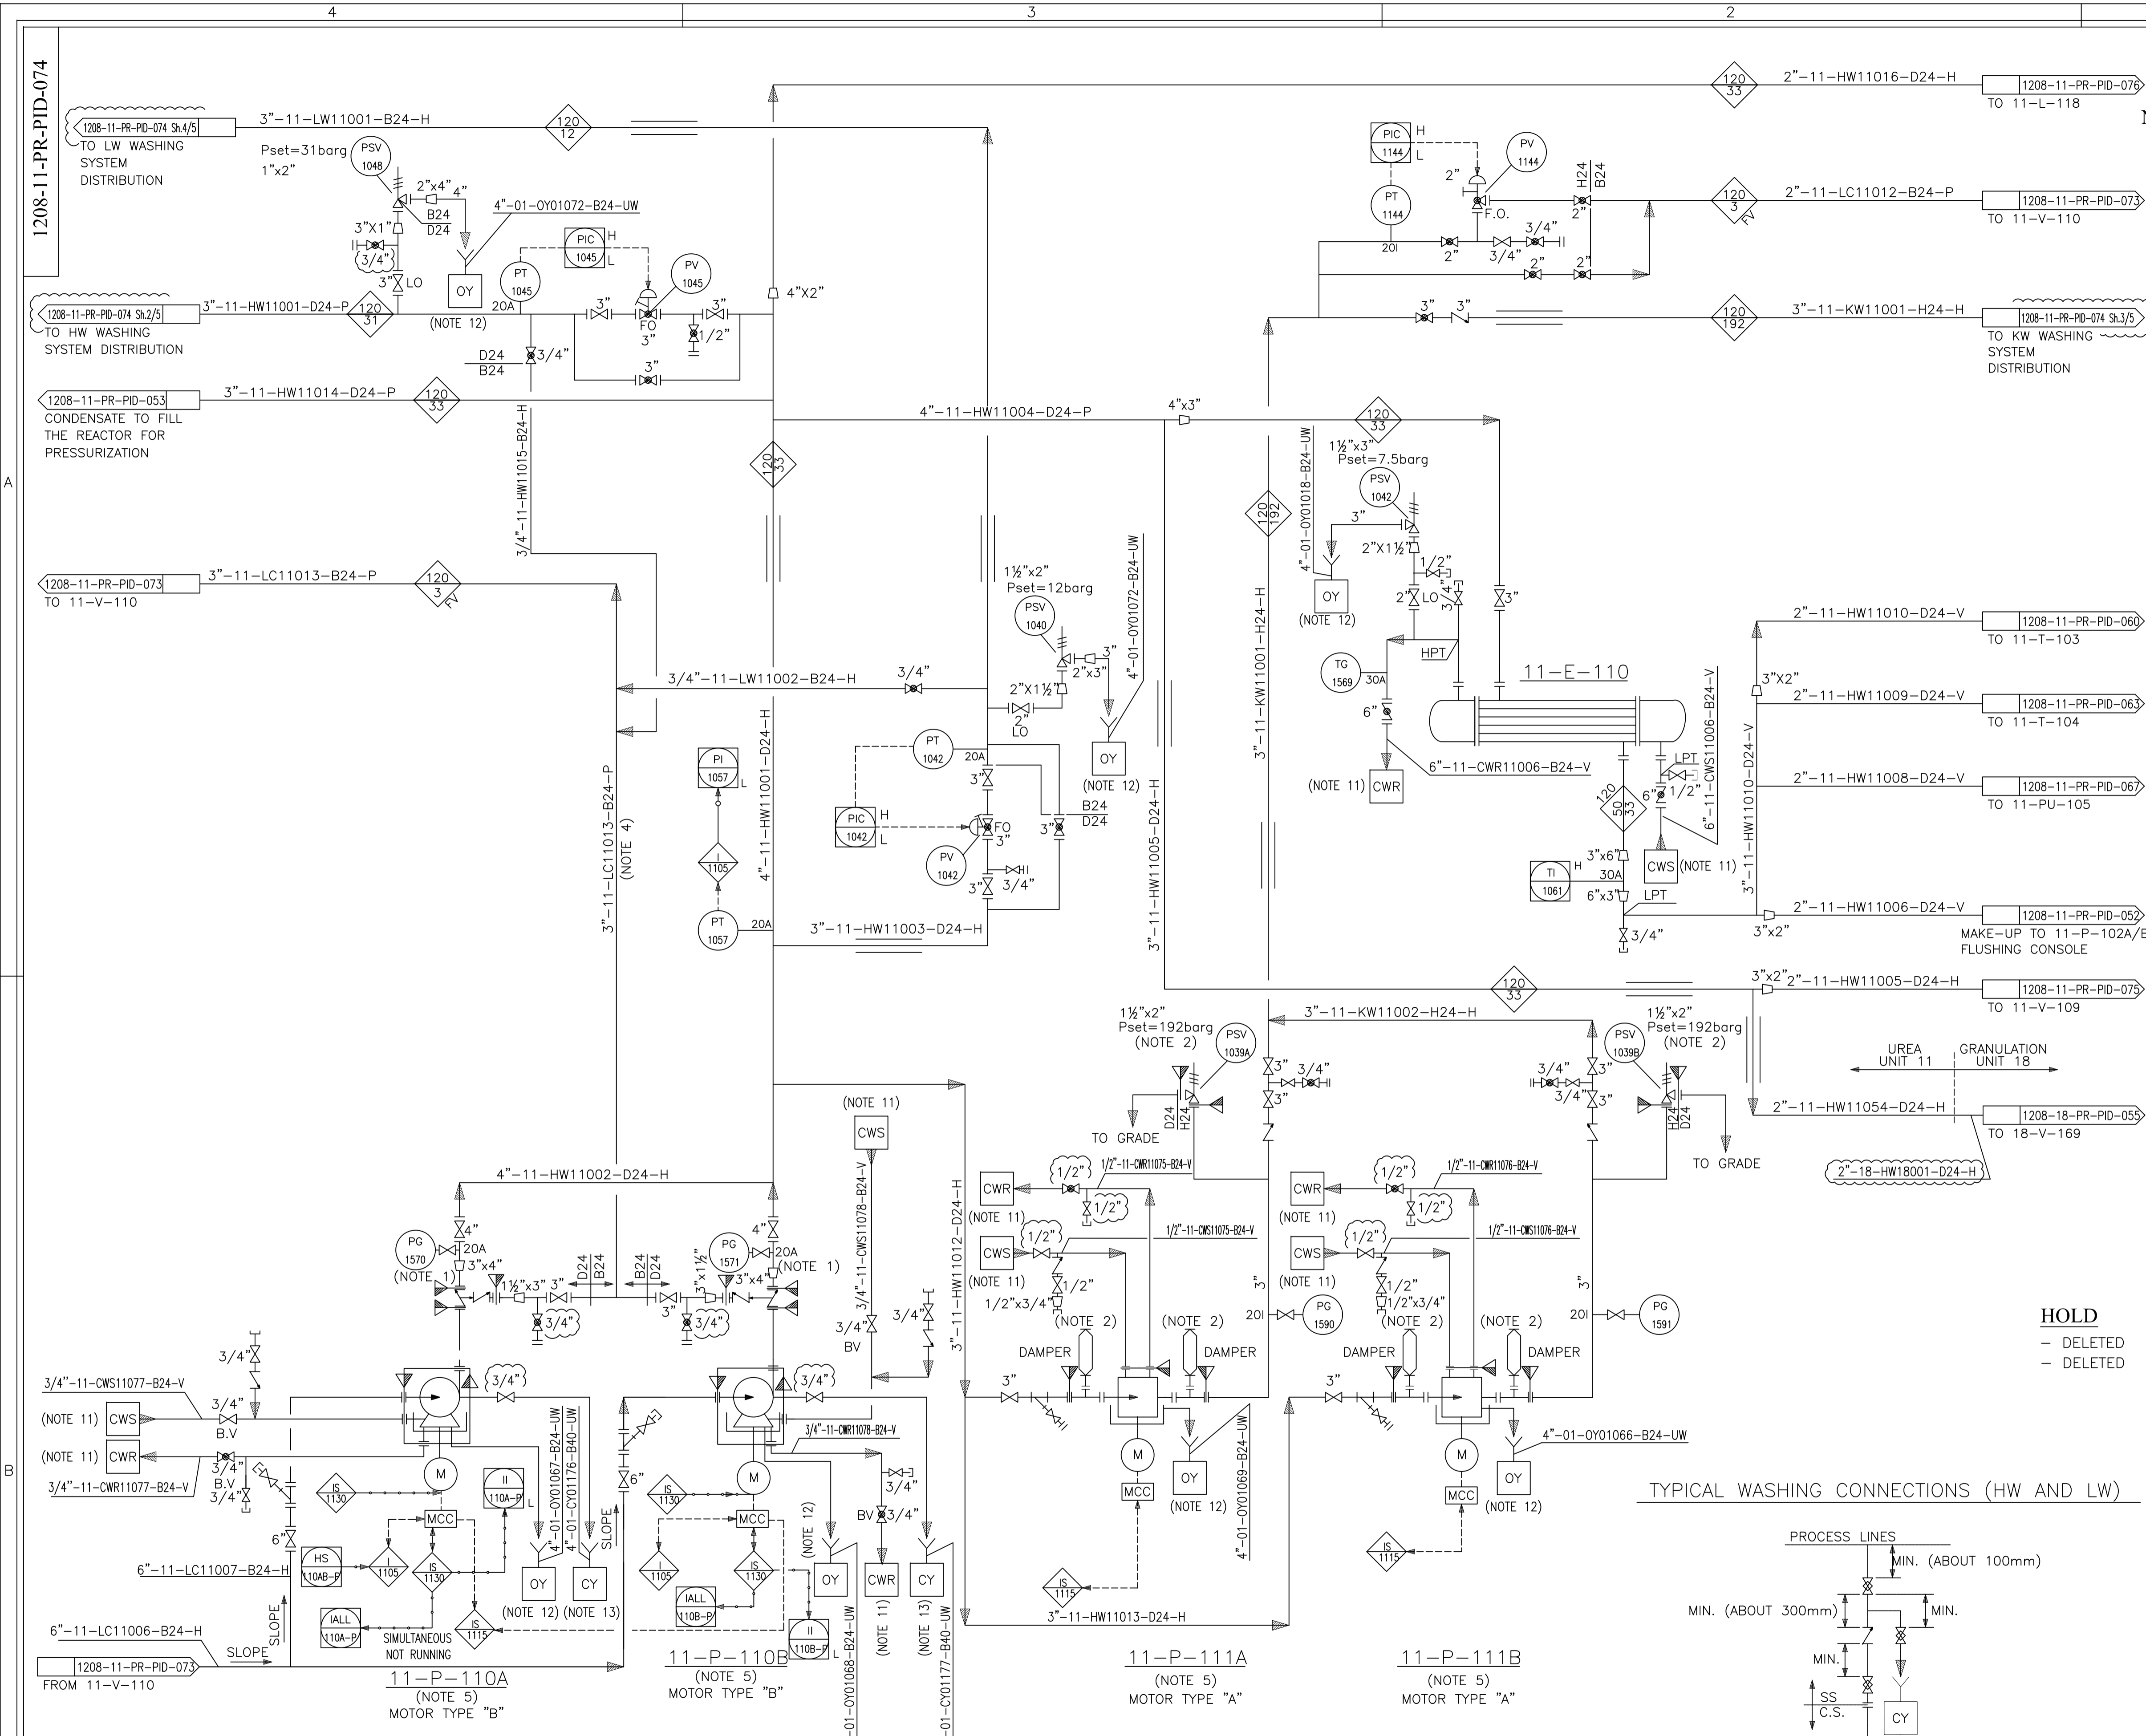


REFERENCE DRAWING	DWG. NO.
SYMBOLS AND IDENTIFICATIONS	1208-01-PR-PID-051-01


- NOTES:**
- 1) MINIMUM FLOW DEVICE AND AUTOMATIC NON RETURN VALVE TO BE SUPPLIED BY 11-P-110A/B MFR.
 - 2) TO BE SUPPLIED BY 11-P-111A/B MFR.
 - 3) FOR WASHING POINTS CLOSE TO EACH OTHER A COMMON CY CAN BE PROVIDED FOR WASHING POINTS FAR FROM EACH OTHER SEPARATED CY SHALL PROVIDED.
 - 4) THE SIZE OF MINIMUM FLOW LINE OF THE PUMP VERIFIED BASED ON PUMP SELECTION.
 - 5) 11-P-110A/B AND 11-P-111A/B ARE UNDER EMERGENCY POWER NETWORK.

- GENERAL NOTES**
- 1) FOR SYMBOLS AND OTHER DETAILS PLEASE REFER TO PID. 1208-01-PR-PID-051.
 - 2) ALL "OD" LINES SHALL HAVE SLOPE TO ENSURE FREE DRAINING TOWARDS 18-TK-153 TANK.
 - 3) SAFETY AND CONTROL VALVE IN/OUT LINES AND RELATED BY-PASS LINE SIZE TO BE VERIFIED DURINGENGINEERING PHASE, AFTER CONTROL VALVES AND SAFETY VALVES SELECTION.
 - 4) MFR CONTRACTOR
 - 5) WHERE IT'S INDICATED "MIN" OR "MINIMUM DISTANCE" THE LENGTH OF THE INTERESTED PIPE TO BE KEPT AS SHORT AS POSSIBLE (ABOUT ONE HUNDRED MILLIMETERS) IN ORDER TO PREVENT DEAD ZONE.
 - 6) FOR THE DESCRIPTION OF ATTRIBUTES OF HYDRAULIC CONSTRAINTS OF LINES (SELF DRAINING, SLOPE, GRAVITY FLOW, ETC.) REFER TO DOC. "GENERAL REQUIREMENTS FOR PIPING" WHERE SPECIFIC REQUIREMENTS ARE INDICATED THAT PIPING SHALL FOLLOW. NO EXCEPTIONS ARE ALLOWED.
 - 7) ALL DRIP RINGS MUST BE INSTALLED TO HAVE THE RELEVANT TAPPING IN THE BOTTOM PART (THE LOWEST POINT). NO EXCEPTIONS ARE ALLOWED.
 - 8) ALL CHECK VALVES HAVE TO BE INSTALLED IN VERTICAL POSITION, UNLESS VENDOR DIFFERENT INDICATIONS.
 - 9) MECHANIZATION OF PIPING AND INSTRUMENTATION HAS BEEN PERFORMED ACCORDING WITH LICENSOR'S STANDARDS AS MINIMUM REQUIREMENT AND IT SHALL BE COMPLETED BY ENGINEERING CONTRACTOR.
 - 10) ALL INSTRUMENT IN THIS PAGE HAVE PRIFIX NO. OF 11. FOR EXAMPLE 11-PV-1045.
 - 11) FOR COOLING WATER SUPPLY/RETURN CONTINUATION REFER TO DWG.: 1208-01-PR-UDD-053.
 - 12) FOR OILY WATER DRAINAGE CONTINUATION REFER TO DWG.: 1208-01-PR-UDD-055.
 - 13) FOR CHEMICAL DRAINAGE CONTINUATION REFER TO DWG.: 1208-01-PR-UDD-056.

TYPICAL WASHING CONNECTIONS (KW)

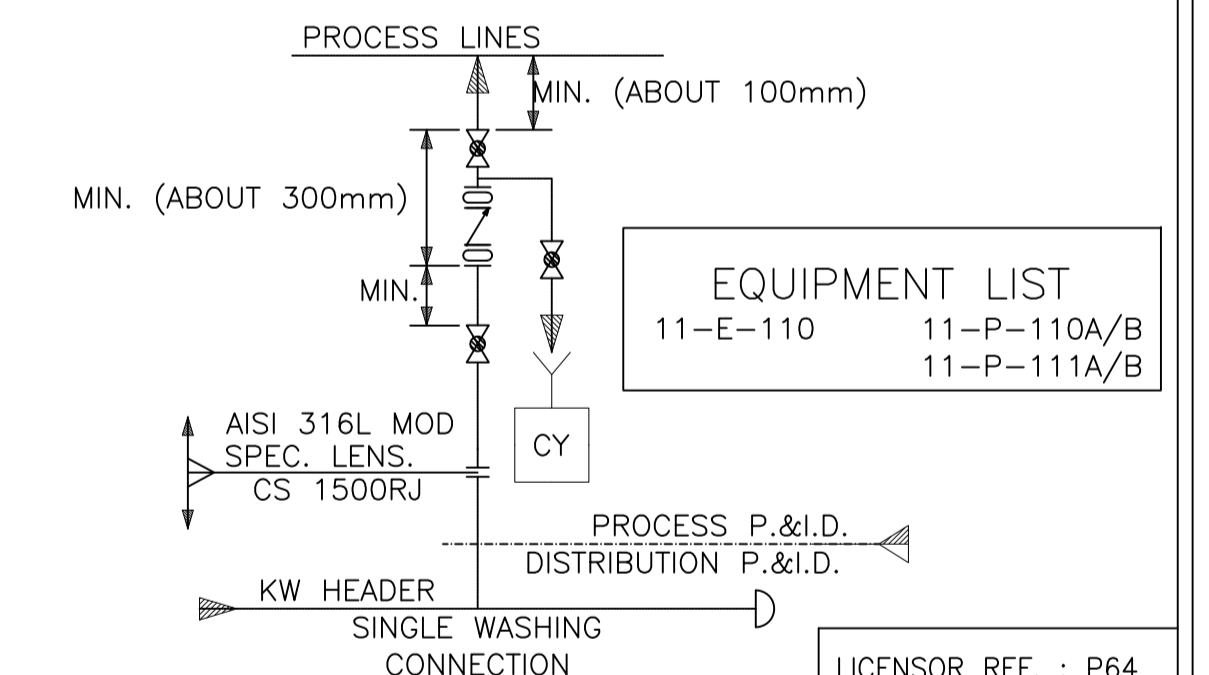

TYPICAL WASHING CONNECTIONS (HW AND LW)

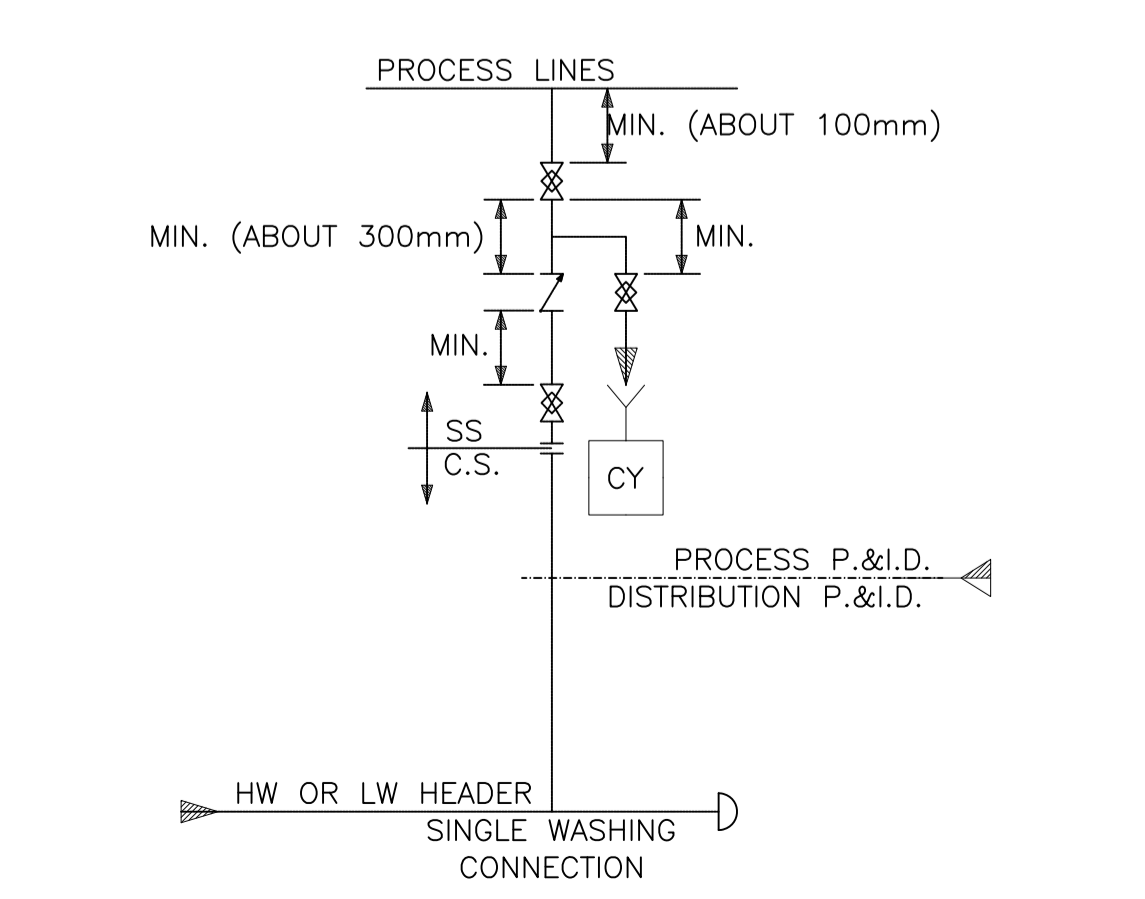

11-E-110	11-P-110A/B	11-P-111A/B
FLUSHING CONDENSATE COOLER	STEAM CONDENSATE FLUSHING PUMPS	HP FLUSHING PUMPS
SHELL LENGTH : 5100 mm	RATED CAPACITY : 45 m ³ /hr	RATED CAPACITY : 10 m ³ /hr
SHELL I.D : 438 mm	SPECIFIC GRAVITY : 0.943	SPECIFIC GRAVITY : 0.943
DESIGN PRESS. S/T : 34/7 barg	DIFF. PRESSURE : 25.4 bar	DIFF. PRESSURE : 147 bar
DESIGN TEMP. S/T : 150/85°C	INSULATION : NO	INSULATION : NO
INSULATION : NO	BY AUTO START FCS	BY AUTO START FCS
	TRIM LINE NO. : 11-HW11056-D24-H	TRIM LINE NO. : 11-KW11030-H24-H

THIS DOCUMENT IS THE PROPERTY OF HFC. IT IS CONFIDENTIAL AND ALL RIGHTS RESERVED. NEITHER THE WHOLE NOR PART OF THIS DOCUMENT MAY BE DISCLOSED TO ANY THIRD PARTY. REPRODUCED, STORED IN ANY RETRIEVAL SYSTEM OR TRANSMITTED IN ANY FORM OR BY ANY MEANS WITHOUT THE PRIOR WRITTEN CONSENT OF HFC.

REV.	ISSUE DATE	DESCRIPTION	PREPARED BY	CHECKED BY	APPROVED BY	PROJECT
04	29.01.2024	APPROVED FOR CONSTRUCTION	M.Fahriadi	A.Azma	A.Azma	M.Sarimi
03	04.09.2023	APPROVED FOR CONSTRUCTION	M.Fahriadi	A.Azma	A.Azma	M.Sarimi
02	23.11.2022	APPROVED FOR CONSTRUCTION (WITH HOLD)	M.Fahriadi	M.Yadavpanah	A.Azma	M.Sarimi
01	12.06.2018	APPROVED FOR CONSTRUCTION (WITH HOLD)	M.Yadavpanah	A.Azma	A.Azma	M.Sarimi
00	04.04.2017	ISSUED FOR ENGINEERING	F.Mizani	A.Habibi	A.Azma	M.Sarimi

OWNER:

MC:


EPCC CONTRACTOR:

PROJECT: **HENGAM FERTILIZER PROJECT**

TITLE: **PIPING AND INSTRUMENTATION DIAGRAM WASHING SYSTEM**


SCALE: N.T.S	OWNER PROJECT NO.: NA	DWG. NO.:	REV.:	SIZE:
	PIDEK PROJECT NO.: 1208	1208-11-PR-PID-074	04	A1

PLANT NORTH

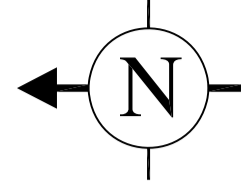

NOTES:

1208-11-PR-PID-074

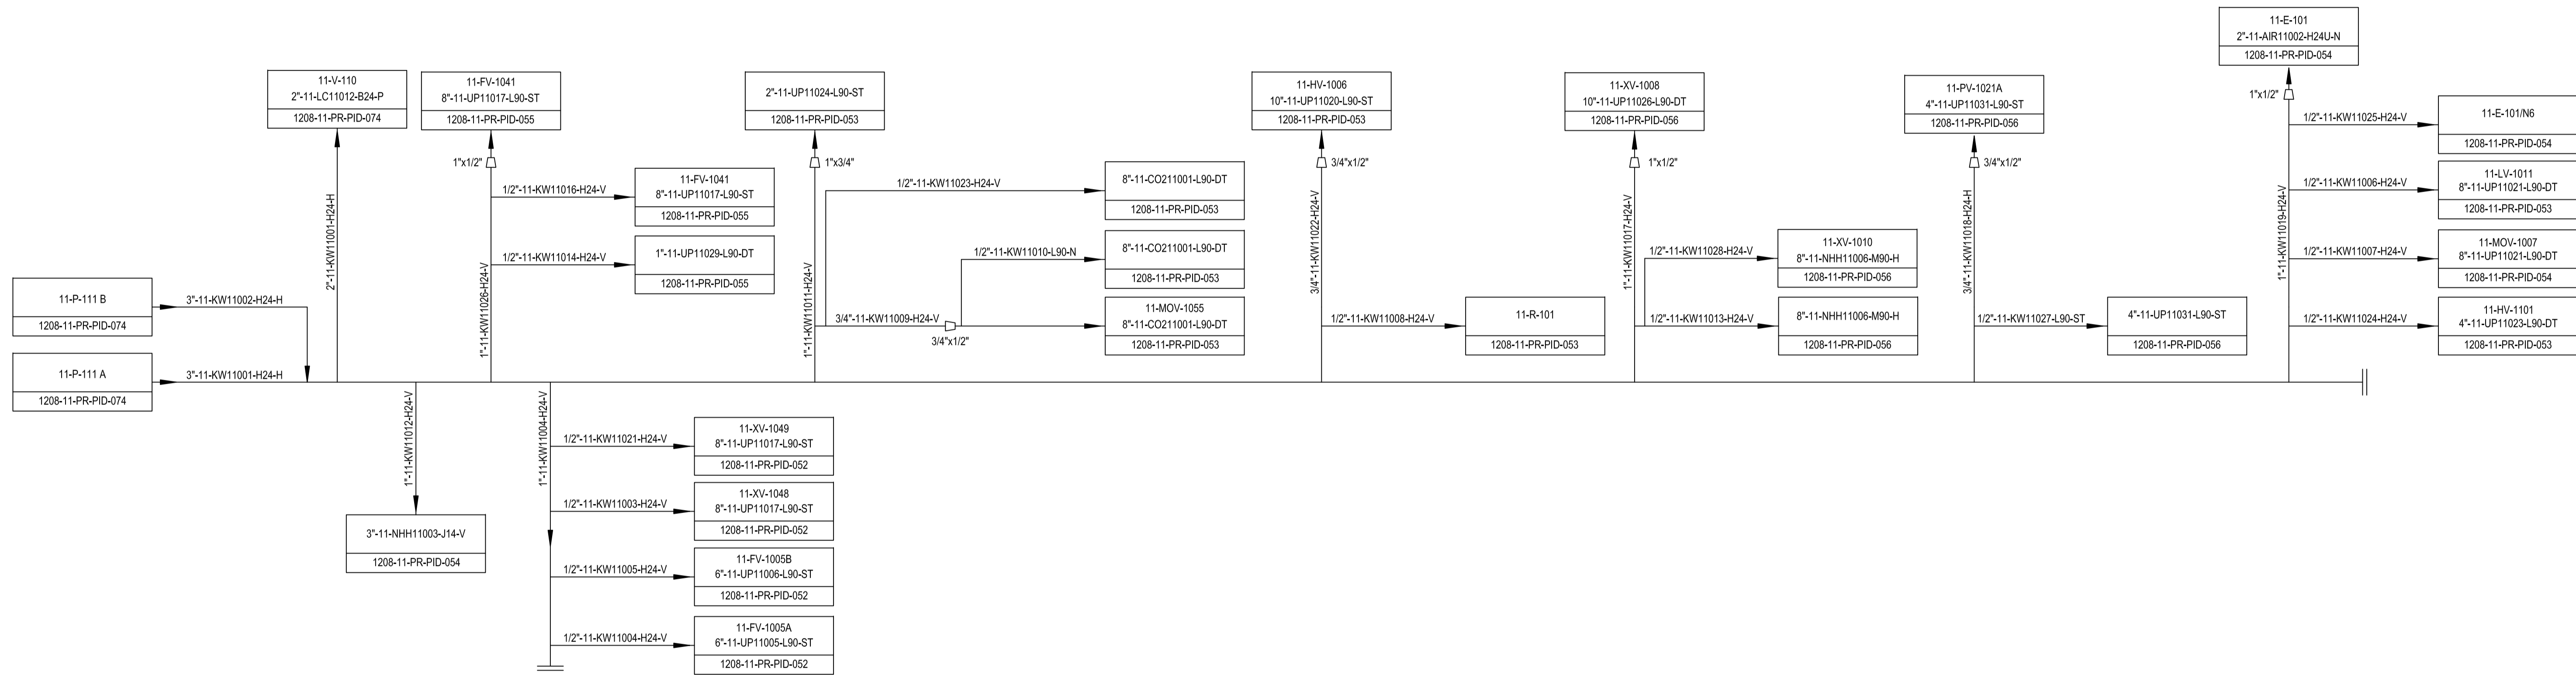

DE	EXT	AFC	A
Eng. Phase	Purpose of Distribution (POD)	Purpose of Issue (POI)	Owner's Action

REV.	ISSUE DATE	DESCRIPTION	PREPARED BY	CHECKED BY	APPROVED BY	PROJECT
04	29.01.2024	APPROVED FOR CONSTRUCTION	M.Fakhradi	A.Azma	A.Azma	M.Sarafi
03	04.09.2023	APPROVED FOR CONSTRUCTION	M.Fakhradi	A.Azma	A.Azma	M.Sarafi
02	23.11.2022	APPROVED FOR CONSTRUCTION (WITH HOLD)	M.Fakhradi	M.Yazdani	A.Azma	M.Sarafi
01	12.06.2018	APPROVED FOR CONSTRUCTION (WITH HOLD)	M.Yazdani	A.Azma	A.Azma	M.Sarafi
00	04.04.2017	ISSUED FOR ENGINEERING	F.Mizani	A.Habibi	A.Azma	M.Sarafi

OWNER:

MC:


EPCC CONTRACTOR:

PROJECT: HENGAM FERTILIZER PROJECT

TITLE: PIPING AND INSTRUMENTATION DIAGRAM WASHING SYSTEM

SCALE: N.T.S	OWNER PROJECT NO.: NA	DWG. NO.: 1208-11-PR-PID-074	REV. 04	SIZE: A1
SHEET: 3 OF 5		PIDEC PROJECT NO.: 1208		

PLANT NORTH

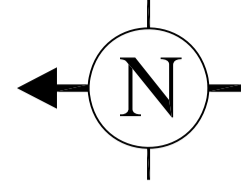

1208-11-PR-PID-074


NOTES:

A

A

B

B

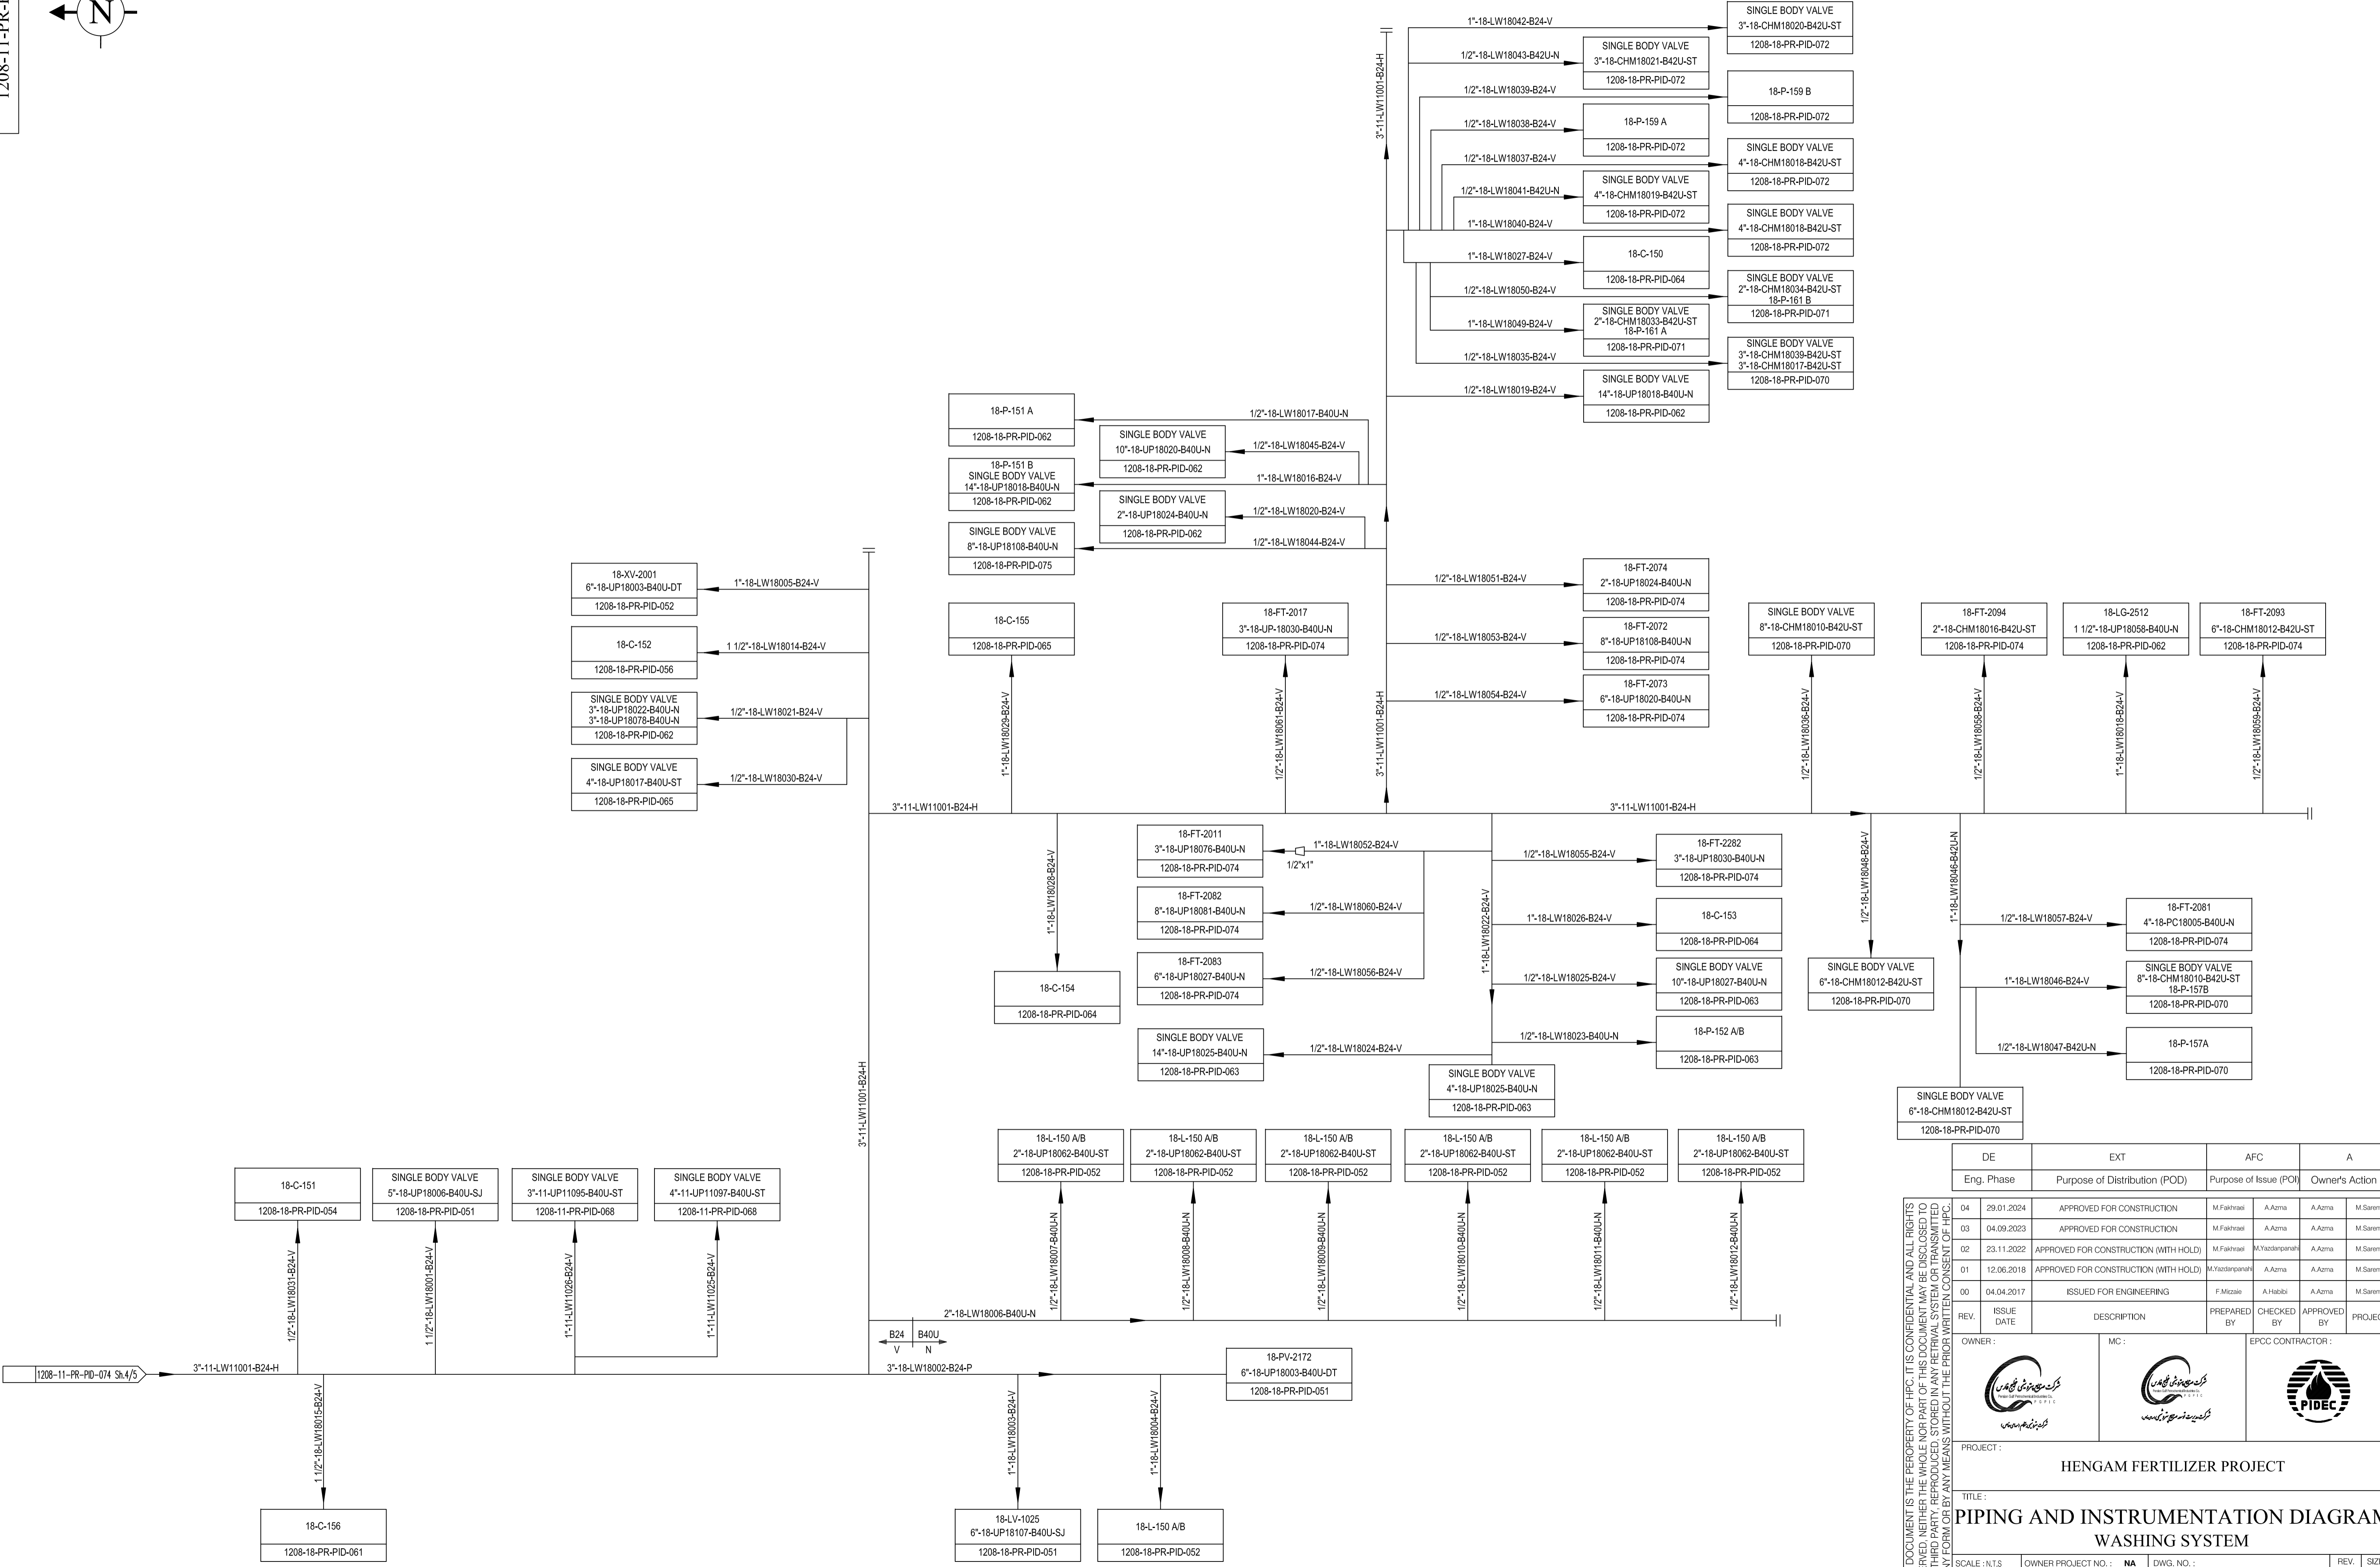

DE	EXT	AFC	A
Eng. Phase	Purpose of Distribution (POD)	Purpose of Issue (POI)	Owner's Action
04	29.01.2024	APPROVED FOR CONSTRUCTION	M.Fakhradi, A.Azma, A.Azma, M.Saromi
03	04.09.2023	APPROVED FOR CONSTRUCTION	M.Fakhradi, A.Azma, A.Azma, M.Saromi
02	23.11.2022	APPROVED FOR CONSTRUCTION (WITH HOLD)	M.Fakhradi, M.Yadollahpour, A.Azma, M.Saromi
01	12.06.2018	APPROVED FOR CONSTRUCTION (WITH HOLD)	M.Yadollahpour, A.Azma, A.Azma, M.Saromi
00	04.04.2017	ISSUED FOR ENGINEERING	F.Mezaki, A.Habibi, A.Azma, M.Saromi
REV.	ISSUE DATE	DESCRIPTION	PREPARED BY, CHECKED BY, APPROVED BY, PROJECT

OWNER:

MC:


EPCC CONTRACTOR:

PROJECT: HENGAM FERTILIZER PROJECT

TITLE: PIPING AND INSTRUMENTATION DIAGRAM WASHING SYSTEM

SCALE: N.T.S	OWNER PROJECT NO.: NA	DWG. NO.: 1208-11-PR-PID-074	REV. 04	SIZE: A1
DATE: 5 OF 5	PIDEC PROJECT NO.: 1208			

- NOTES:
- 11-V-109 INLET NOZZLE TO BE LOCATED 4000 mm BELOW 11-E-101 SHELL SIDE OUTLET NOZZLE.
 - TO BE INSTALLED AFTER BLOWING OF THE LINES.
 - FOR SAMPLE CONNECTION DETAILS AND PIPING ARRANGEMENT REFER TO P&ID. 1208-11-PR-PID-080 AND 1208-11-PR-PID-081.
 - TO BE LOCATED AT SAFE LOCATION ABOVE 11-V-101 PLATFORM.
 - LV-1009 A/B OPERATE IN SPLIT RANG AS SHOWN:

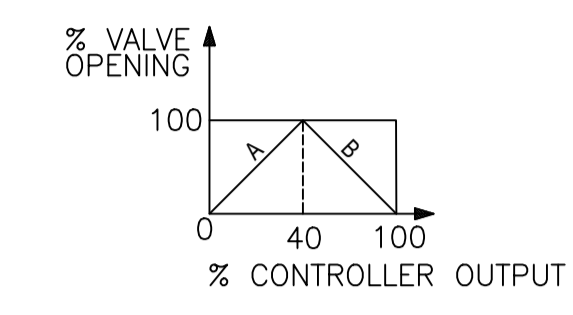

- GENERAL NOTES:
- FOR SYMBOLS AND OTHER DETAILS PLEASE REFER TO DOC. 1208-01-PR-PID-051.
 - FOR ALL "CD" LINES THE FLANGES ARE TO BE LOCATED AT MINIMUM DISTANCE FROM GRADE. ALL "CD" LINES SHALL HAVE SLOPE TO ENSURE FREE DRAINING TOWARDS 11-TK-104 TANK.
 - SAFETY AND CONTROL VALVE IN/OUT LINES AND RELATED BY-PASS LINE SIZE TO BE VERIFIED DURING ENGINEERING PHASE, AFTER CONTROL VALVES AND SAFETY VALVES SELECTION.
 - MFR CONTRACTOR
 - WHERE IT'S INDICATED "MIN" OR "MINIMUM DISTANCE" THE LENGTH OF THE INTERESTED PIPE TO BE KEPT AS SHORT AS POSSIBLE (ABOUT ONE HUNDRED MILLIMETERS) IN ORDER TO PREVENT DEAD ZONE.
 - FOR THE DESCRIPTION OF ATTRIBUTES OF HYDRAULIC CONSTRAINTS OF LINES (SELF DRAINING, SLOPE, GRAVITY FLOW, ETC.) REFER TO DOC. "GENERAL REQUIREMENTS FOR PIPING" WHERE SPECIFIC REQUIREMENTS ARE INDICATED THAT PIPING SHALL FOLLOW. NO EXCEPTIONS ARE ALLOWED.
 - ALL DRIP RINGS MUST BE INSTALLED TO HAVE THE RELEVANT TAPPING IN THE BOTTOM PART (THE LOWEST POINT). NO EXCEPTIONS ARE ALLOWED.
 - ALL CHECK VALVES HAVE TO BE INSTALLED IN VERTICAL POSITION, UNLESS VENDOR DIFFERENT INDICATIONS.
 - MECHANIZATION OF PIPING AND INSTRUMENTATION HAS BEEN PERFORMED ACCORDING WITH LICENSOR'S STANDARDS AS MINIMUM REQUIREMENT AND IT SHALL BE COMPLETED BY ENGINEERING CONTRACTOR.
 - ALL INSTRUMENT IN THIS PAGE HAVE PREFIX NO. OF 11. FOR EXAMPLE 11-PV-1020.
 - FOR STEAM AND CONDENSATE LINES CONTINUATION REFER TO DWG.: 1208-01-PR-UDD-051.
 - FOR COOLING WATER SUPPLY/RETURN CONTINUATION REFER TO DWG.: 1208-01-PR-UDD-053.
 - FOR OILY WATER DRAINAGE CONTINUATION REFER TO DWG.: 1208-01-PR-UDD-055.

- HOLD
- DELETED
 - DELETED

EQUIPMENT LIST	
11-V-109	
11-L-115	

LICENSOR REF. : P65

DE	EXT	AFC	A
Eng. Phase	Purpose of Distribution (POD)	Purpose of Issue (POI)	Owner's Action
03	30.08.2023	APPROVED FOR CONSTRUCTION	M.Fakhrani, A.Azma, A.Azma, M.Saremi
02	23.11.2022	APPROVED FOR CONSTRUCTION	M.Fakhrani, M.Yadgarparani, A.Azma, M.Saremi
01	12.06.2018	APPROVED FOR CONSTRUCTION (WITH HOLD)	M.Yadgarparani, A.Azma, A.Azma, M.Saremi
00	04.04.2017	ISSUED FOR ENGINEERING	F.Mizani, A.Habibi, A.Azma, M.Saremi

OWNER:


MC:

EPC CONTRACTOR:


PROJECT: HENGAM FERTILIZER PROJECT

TITLE: PIPING AND INSTRUMENTATION DIAGRAM STEAM SYSTEM 1 of 2

SCALE: N.T.S	OWNER PROJECT NO.: NA	DWG. NO.:	REV.:	SIZE:
SHT.: 1 OF 1	PIDEC PROJECT NO.: 1208	1208-11-PR-PID-075	03	A1

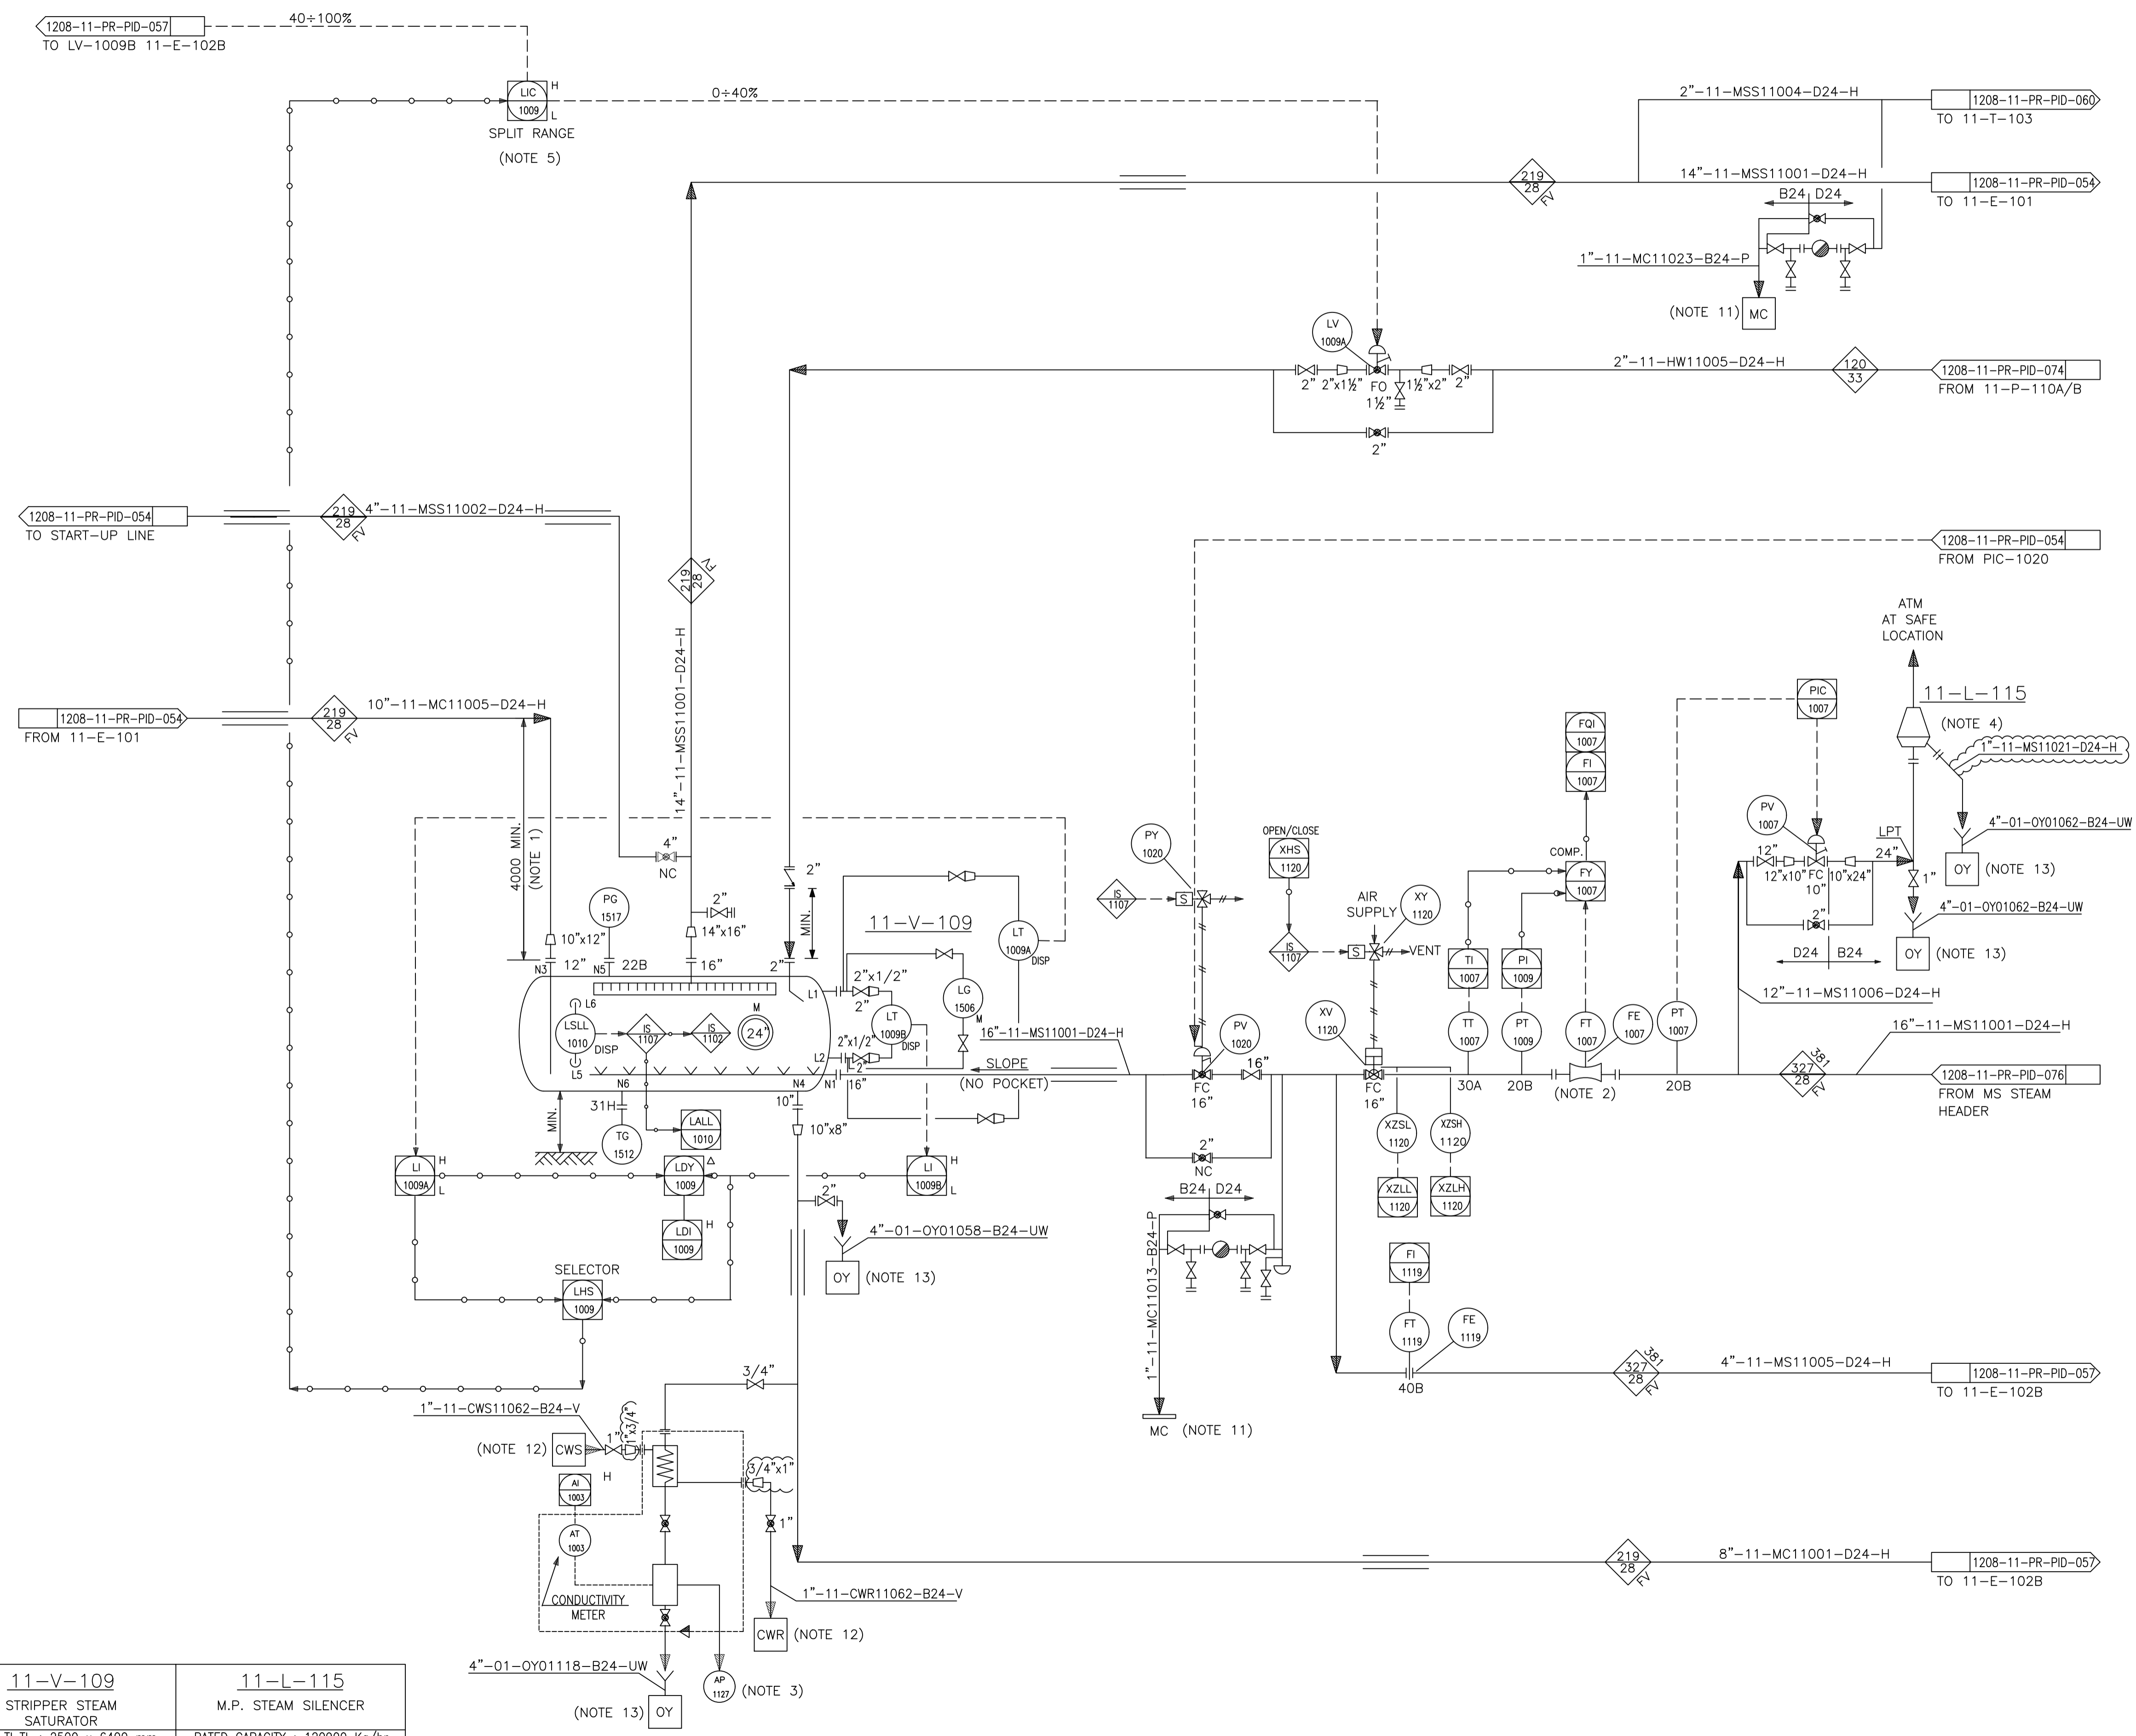


<p>11-V-109</p> <p>STRIPPER STEAM SATURATOR</p> <p>I.D. x T.L.T.L : 2500 x 6400 mm</p> <p>DESIGN PRESS. : 28/F.V. barg</p> <p>DESIGN TEMP. : 280°C</p> <p>INSULATION : YES</p> <p>TRIM LINE NO. : 11-MC11014-D24-H</p>	<p>11-L-115</p> <p>M.P. STEAM SILENCER</p> <p>RATED CAPACITY : 120900 Kg/hr</p> <p>DESIGN PRESS. : (5 barg)</p> <p>DESIGN TEMP. : 381°C</p> <p>INSULATION : NO</p>
---	---

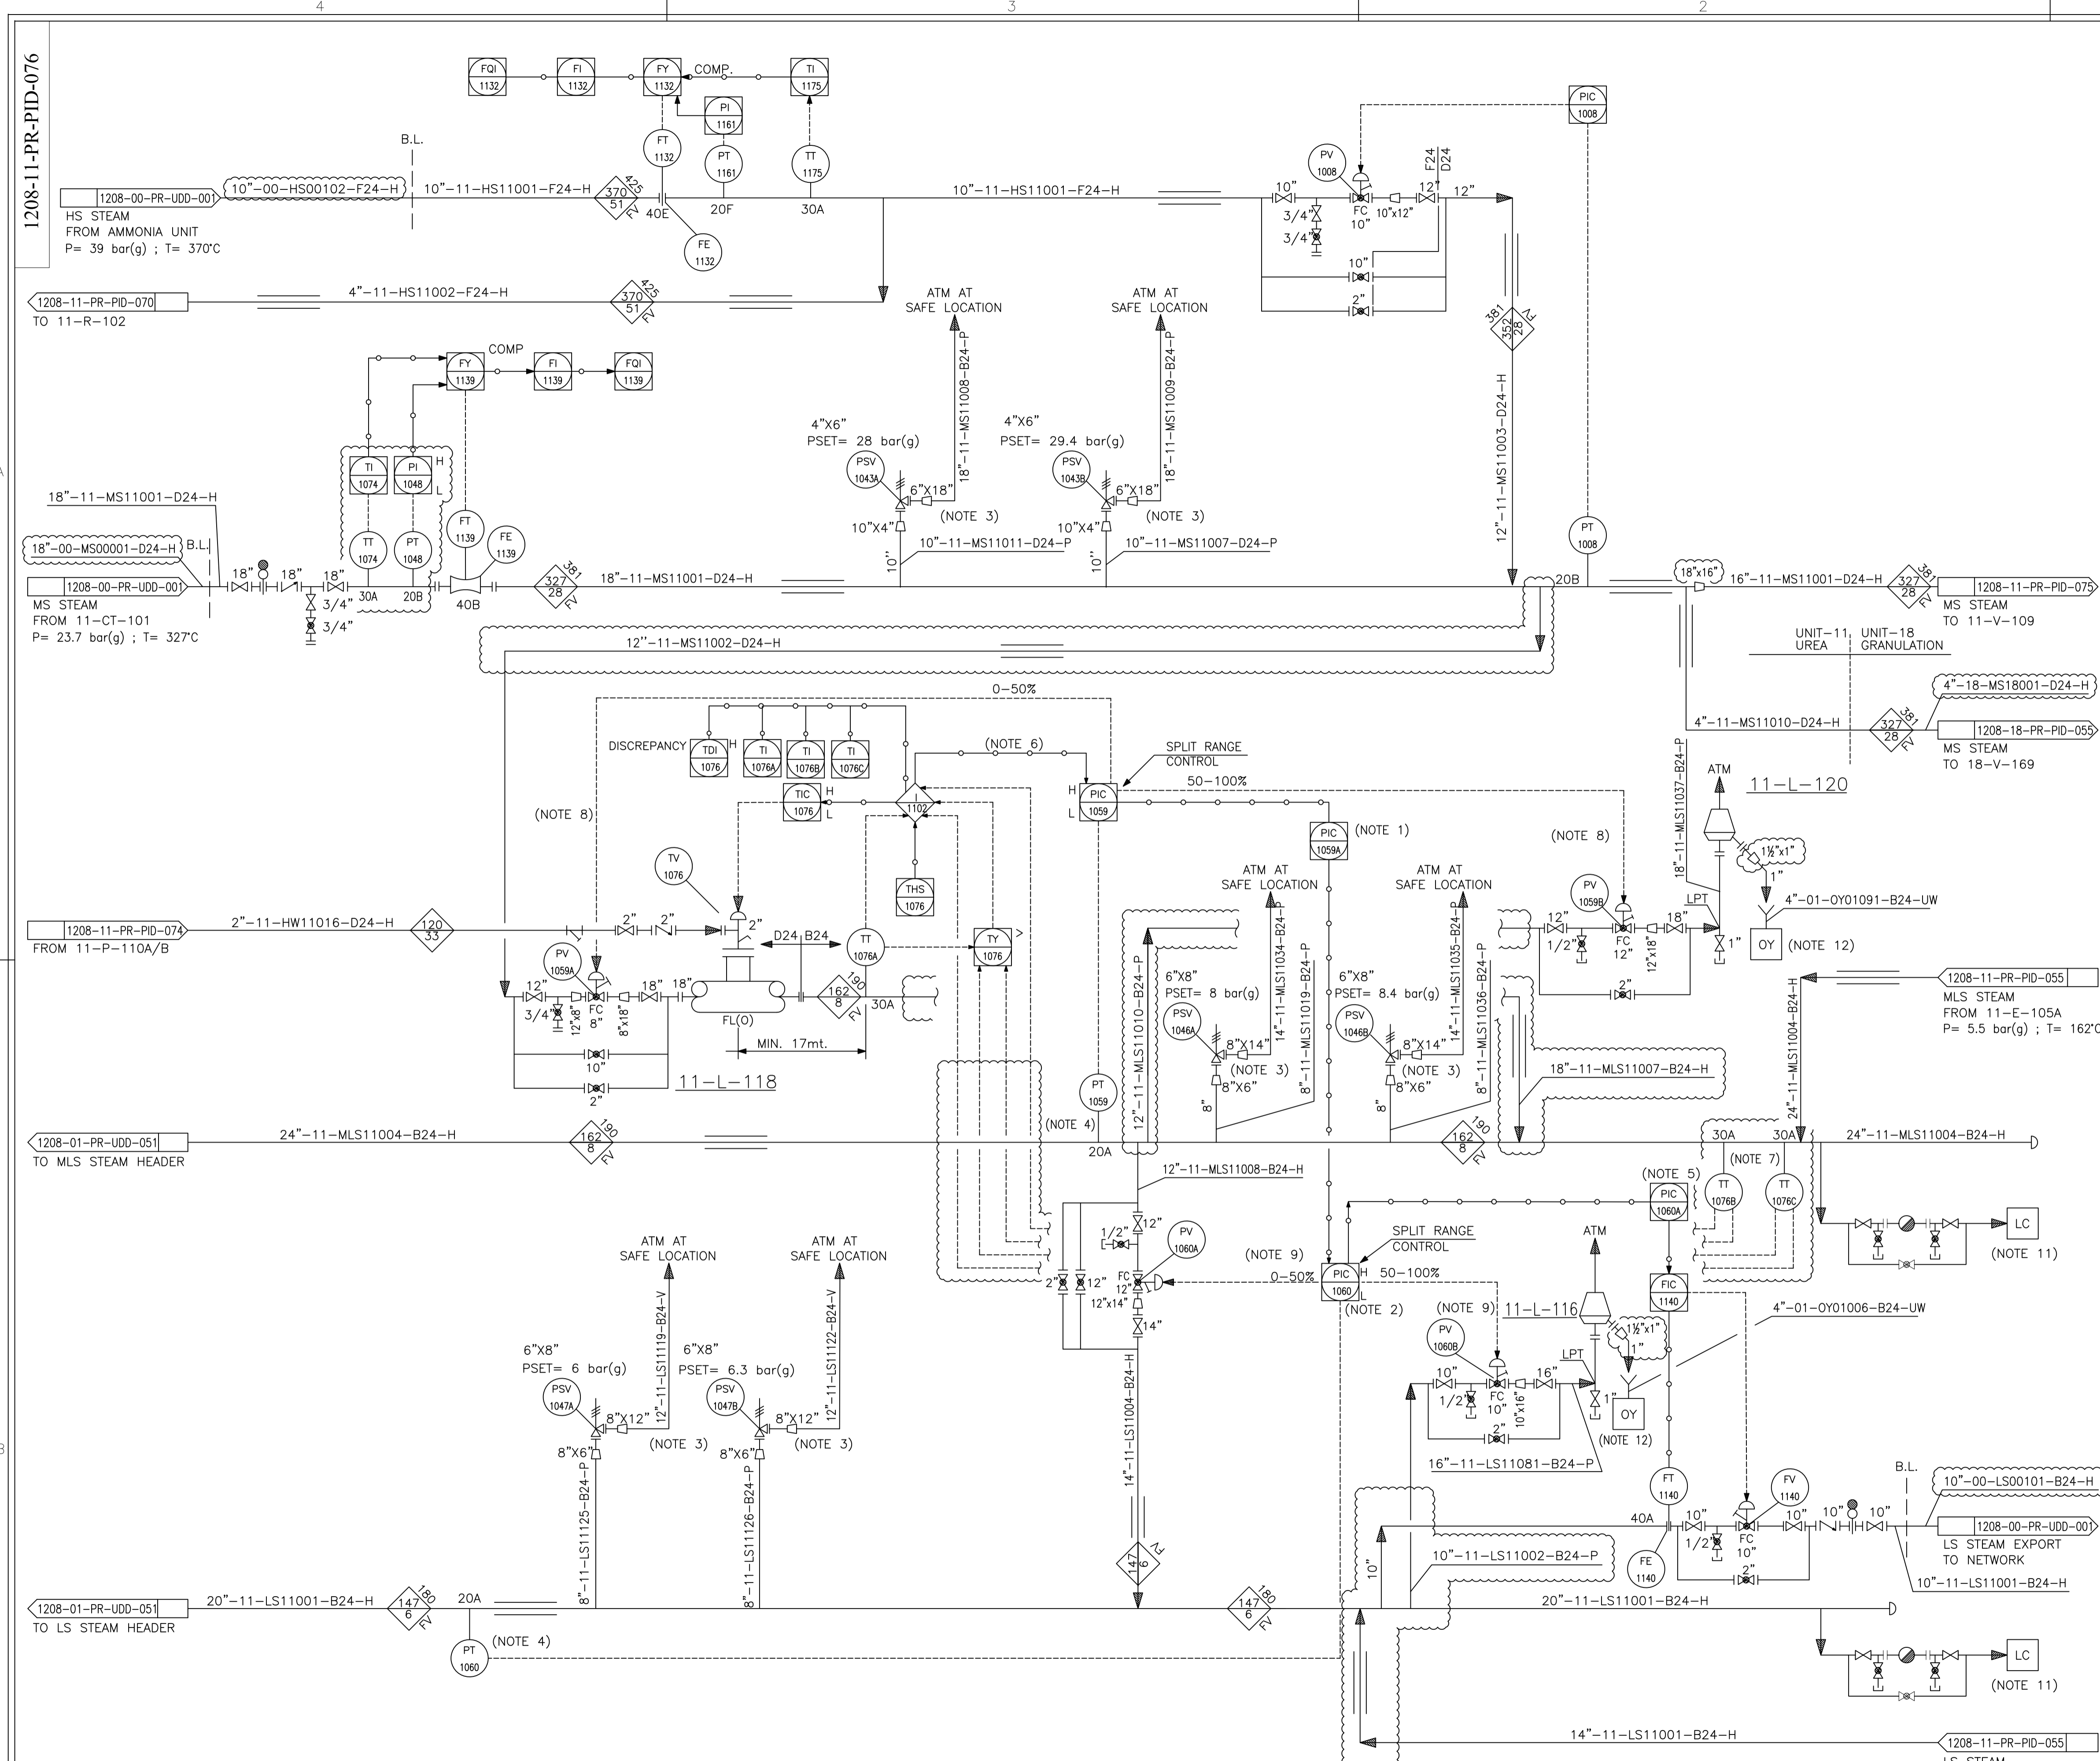

REFERENCE DRAWING	DWG. NO.
SYMBOLS AND IDENTIFICATIONS	1208-01-PR-PID-051-01

- NOTES:**
- 1) IN CASE OF HIGH PRESSURE ON MLS HEADER, THE CONTROLLER PIC-1059 SHALL GIVE SIGNAL TO PV-1059B TO OPEN, IN CASE THE PRESSURE CONTINUES TO INCREASE THE CONTROLLER SHALL GIVE THE SIGNAL TO PV-1060A TO OPEN.
 - 2) PV-1060 A/B SHALL BE OPERATED SEPARATELY WHEN THE PRESSURE CONTROLLER IS IN MANUAL MODE.
 - 3) DRIP HOLE $\phi = 1/2"$ AT LOWEST POINT AND SHALL BE PIPED TO GRADE.
 - 4) PT-1059 AND PT-1060 TO BE LOCATED MINIMUM 20 METERS FROM VENT TAPPING.
 - 5) PV-1060 IS PROVIDED IN ORDER TO GIVE A SIGNAL TO OVERRIDE THE FIC-1140 CLOSING THE VALVE, WHEN THE PRESSURE OF LS HEADER IS DECREASING, EVEN IF PV-1060A IS FULLY OPEN.
 - 6) FORCE TO MINIMUM OUTPUT TO CLOSE PV-1059A.
 - 7) TT-1076B AND TT-1076C TO BE LOCATED ON MLS STEAM HEADER.
 - 8) PV-1059A/B OPERATE IN SPLIT RANG AS SHOWN:

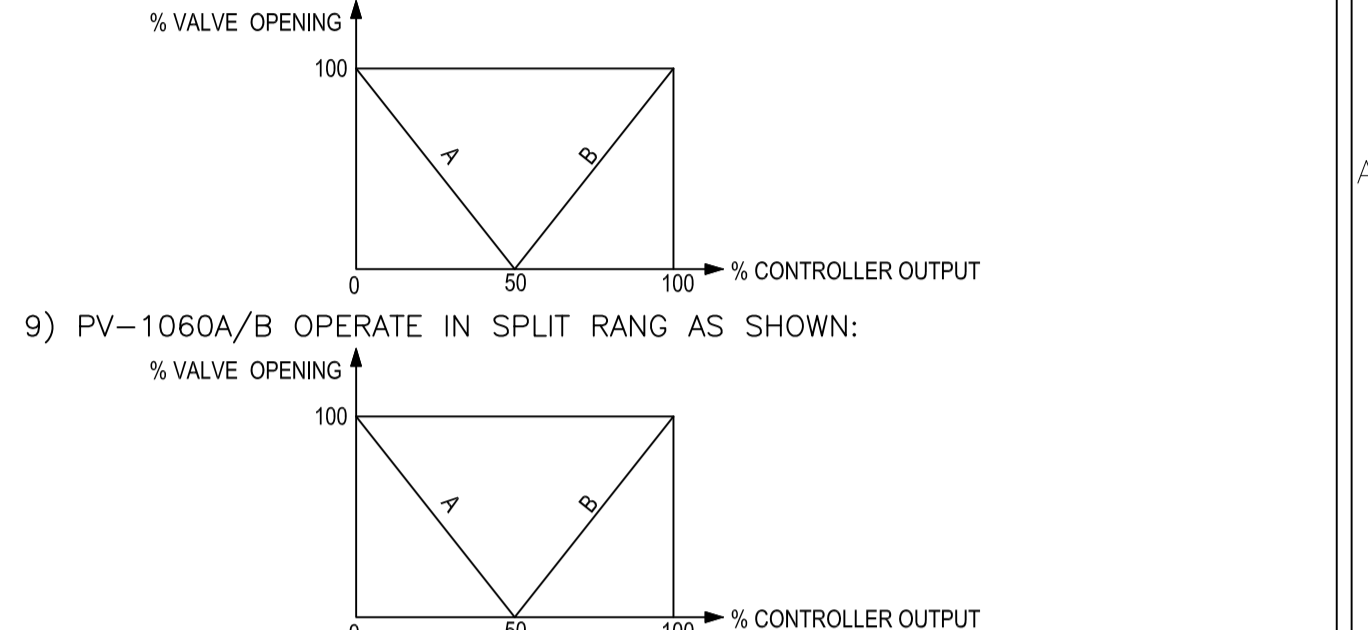

- GENERAL NOTES:**
- 1) FOR SYMBOLS AND OTHER DETAILS PLEASE REFER TO PID 1208-01-PR-PID-051.
 - 2) FOR ALL "CD" LINES THE FLANGES ARE TO BE LOCATED AT MINIMUM DISTANCE FROM GRADE. ALL "CD" LINES SHALL HAVE SLOPE TO ENSURE FREE DRAINING TOWARDS 11-TK-104 TANK.
 - 3) SAFETY AND CONTROL VALVE IN/OUT LINES AND RELATED BYPASS LINE SIZE TO BE VERIFIED DURING ENGINEERING PHASE, AFTER CONTROL VALVES AND SAFETY VALVES SELECTION.
 - 4) CONTRACTOR
 - 5) WHERE IT'S INDICATED "MIN" OR "MINIMUM DISTANCE" THE LENGTH OF THE INTERESTED PIPE TO BE KEPT AS SHORT AS POSSIBLE (ABOUT ONE HUNDRED MILLIMETERS) IN ORDER TO PREVENT DEAD ZONE.
 - 6) FOR THE DESCRIPTION OF ATTRIBUTES OF HYDRAULIC CONSTRAINTS OF LINES (SELF DRAINING, SLOPE, GRAVITY FLOW, ETC.) REFER TO DOC. "GENERAL REQUIREMENTS FOR PIPING" WHERE SPECIFIC REQUIREMENTS ARE INDICATED THAT PIPING SHALL FOLLOW. NO EXCEPTIONS ARE ALLOWED.
 - 7) ALL DRIP RINGS MUST BE INSTALLED TO HAVE THE RELEVANT TAPPING IN THE BOTTOM PART (THE LOWEST POINT). NO EXCEPTIONS ARE ALLOWED.
 - 8) ALL CHECK VALVES HAVE TO BE INSTALLED IN VERTICAL POSITION, UNLESS VENDOR DIFFERENT INDICATIONS.
 - 9) MECHANIZATION OF PIPING AND INSTRUMENTATION HAS BEEN PERFORMED ACCORDING WITH LICENSOR'S STANDARDS AS MINIMUM REQUIREMENT AND IT SHALL BE COMPLETED BY ENGINEERING CONTRACTOR.
 - 10) ALL INSTRUMENT IN THIS PAGE HAVE PREFIX NO. OF 11. FOR EXAMPLE 11-FT-1139.
 - 11) FOR STEAM AND CONDENSATE LINES CONTINUATION REFER TO DWG.: 1208-01-PR-UPD-051.
 - 12) FOR OILY WATER DRAINAGE CONTINUATION REFER TO DWG.: 1208-01-PR-UPD-055.

EQUIPMENT LIST

11-L-116
11-L-118
11-L-120

LICENSOR REF. : P66

DE	EXT	AFC	A
Eng. Phase	Purpose of Distribution (POD)	Purpose of Issue (POI)	Owner's Action
04	07.01.2024	APPROVED FOR CONSTRUCTION	M.Fakhrani A.Azma A.Azma M.Sarani
03	02.09.2023	APPROVED FOR CONSTRUCTION	M.Fakhrani A.Azma A.Azma M.Sarani
02	23.11.2022	APPROVED FOR CONSTRUCTION (WITH HOLD)	M.Fakhrani M.Yazdani A.Azma M.Sarani
01	12.06.2018	APPROVED FOR CONSTRUCTION (WITH HOLD)	M.Yazdani A.Azma A.Azma M.Sarani
00	04.04.2017	ISSUED FOR ENGINEERING	F.Mirzae A.Habibi A.Azma M.Sarani

THIS DOCUMENT IS THE PROPERTY OF HFC. IT IS CONFIDENTIAL AND ALL RIGHTS RESERVED. NEITHER THE WHOLE NOR PART OF THIS DOCUMENT MAY BE DISCLOSED TO ANY THIRD PARTY. REPRODUCED, STORED IN ANY RETRIEVAL SYSTEM OR TRANSMITTED IN ANY FORM OR BY ANY MEANS WITHOUT THE PRIOR WRITTEN CONSENT OF HFC.

OWNER:

MC:

EPCC CONTRACTOR:

PROJECT: HENGAM FERTILIZER PROJECT

TITLE: PIPING AND INSTRUMENTATION DIAGRAM
STEAM SYSTEM 2 of 2

SCALE: N.T.S	OWNER PROJECT NO.: NA	DWG. NO.:
REV.:	DATE:	DESCRIPTION:
PREPARED BY:	CHECKED BY:	APPROVED BY:
PROJECT:	REV.:	SIZE:

1208-11-PR-PID-076 04 A1

11-L-116	11-L-118	11-L-120
L.P. STEAM SILENCER	M.P. STEAM DESUPERHEATER	M.L.P. STEAM SILENCER
FLOW RATE : 45500 kg/hr	OUTLET STEAM FLOW RATE : 62300 kg/hr	FLOW RATE : 78000 kg/hr
DESIGN PRESS. : 5 barg	DESIGN PRESS. (WATER SIDE/STEAM SIDE): 33/28 barg	DESIGN PRESS. : 5 barg
DESIGN TEMP. : 180°C	DESIGN TEMP. : 381°C	DESIGN TEMP. : 190°C
INSULATION : NO	INSULATION : YES	INSULATION : NO

REFERENCE DRAWING	DWG. NO.
SYMBOLS AND IDENTIFICATIONS	1208-01-PR-PID-051-01

- NOTES:
- 1) ALL PUMPS CONNECTIONS DEFINED AS PER PUMP MFR SELECTION.

- GENERAL NOTES:
- 1) FOR SYMBOLS AND OTHER DETAILS PLEASE REFER TO PID. 1208-01-PR-PID-051
 - 2) FOR ALL "CD" LINES THE FLANGES ARE TO BE LOCATED AT MINIMUM DISTANCE FROM GRADE. ALL "CD" LINES SHALL HAVE SLOPE TO ENSURE FREE DRAINING TOWARDS 11-TK-104 TANK.
 - 3) SAFETY AND CONTROL VALVE IN/OUT LINES AND RELATED BY-PASS LINE SIZE TO BE VERIFIED DURING ENGINEERING PHASE, AFTER CONTROL VALVES AND SAFETY VALVES SELECTION.
 - 4) MFR
 CONTRACTOR
 - 5) WHERE IT'S INDICATED "MIN" OR "MINIMUM DISTANCE" THE LENGTH OF THE INTERESTED PIPE TO BE KEPT AS SHORT AS POSSIBLE (ABOUT ONE HUNDRED MILLIMETERS) IN ORDER TO PREVENT DEAD ZONE.
 - 6) FOR THE DESCRIPTION OF ATTRIBUTES OF HYDRAULIC CONSTRAINTS OF LINES (SELF DRAINING, SLOPE, GRAVITY FLOW, ETC.) REFER TO DOC. "GENERAL REQUIREMENTS FOR PIPING" WHERE SPECIFIC REQUIREMENTS ARE INDICATED THAT PIPING SHALL FOLLOW. NO EXCEPTIONS ARE ALLOWED.
 - 7) ALL DRIP RINGS MUST BE INSTALLED TO HAVE THE RELEVANT TAPPING IN THE BOTTOM PART (THE LOWEST POINT). NO EXCEPTIONS ARE ALLOWED.
 - 8) ALL CHECK VALVES HAVE TO BE INSTALLED IN VERTICAL POSITION, UNLESS VENDOR DIFFERENT INDICATIONS.
 - 9) MECHANIZATION OF PIPING AND INSTRUMENTATION HAS BEEN PERFORMED ACCORDING WITH LICENSOR'S STANDARDS AS MINIMUM REQUIREMENT AND IT SHALL BE COMPLETED BY ENGINEERING CONTRACTOR.
 - 10) ALL INSTRUMENT IN THIS PAGE HAVE PREFIX NO. OF 11. FOR EXAMPLE 11-FI-1032.
 - 11) FOR OILY WATER DRAINAGE CONTINUATION REFER TO DWG.: 1208-01-PR-UDD-055.
 - 12) FOR CHEMICAL DRAINAGE CONTINUATION REFER TO DWG.: 1208-01-PR-UDD-056.
 - 13) FOR CLOSE DRAINAGE CONTINUATION REFER TO DWG.: 1208-01-PR-UDD-057.
 - 14) FOR NITROGEN/NATURAL GAS LINES CONTINUATION REFER TO DWG.: 1208-01-PR-UDD-052.
 - 15) FOR FLARE CONTINUATION REFER TO DWG.: 1208-97-SA-PID-014.

HOLD
- DELETED
- DELETED

EQUIPMENT LIST	
11-P-125A/B	11-TK-125

LICENSOR REF. : P67

DE	EXT	AFC	A
Eng. Phase	Purpose of Distribution (POD)	Purpose of Issue (POI)	Owner's Action

REV.	ISSUE DATE	DESCRIPTION	PREPARED BY	CHECKED BY	APPROVED BY	PROJECT
04	08.01.2024	APPROVED FOR CONSTRUCTION	M.Fakhrabi	A.Azma	A.Azma	M.Sarafi
03	03.09.2023	APPROVED FOR CONSTRUCTION	M.Fakhrabi	A.Azma	A.Azma	M.Sarafi
02	22.11.2022	APPROVED FOR CONSTRUCTION (WITH HOLD)	M.Fakhrabi	M.Yadavparahi	A.Azma	M.Sarafi
01	12.06.2018	APPROVED FOR CONSTRUCTION (WITH HOLD)	M.Yadavparahi	A.Azma	A.Azma	M.Sarafi
00	04.04.2017	ISSUED FOR ENGINEERING	F.Mizani	A.Habibi	A.Azma	M.Sarafi

OWNER:


MC:

EPCC CONTRACTOR:

PROJECT: HENGAM FERTILIZER PROJECT

TITLE: PIPING AND INSTRUMENTATION DIAGRAM OFF SPEC TANK AND PUMPS

SCALE: 1:1	OWNER PROJECT NO.: NA	DWG. NO.: 1208-11-PR-PID-077	REV. 04	SIZE: A1
------------	-----------------------	------------------------------	---------	----------

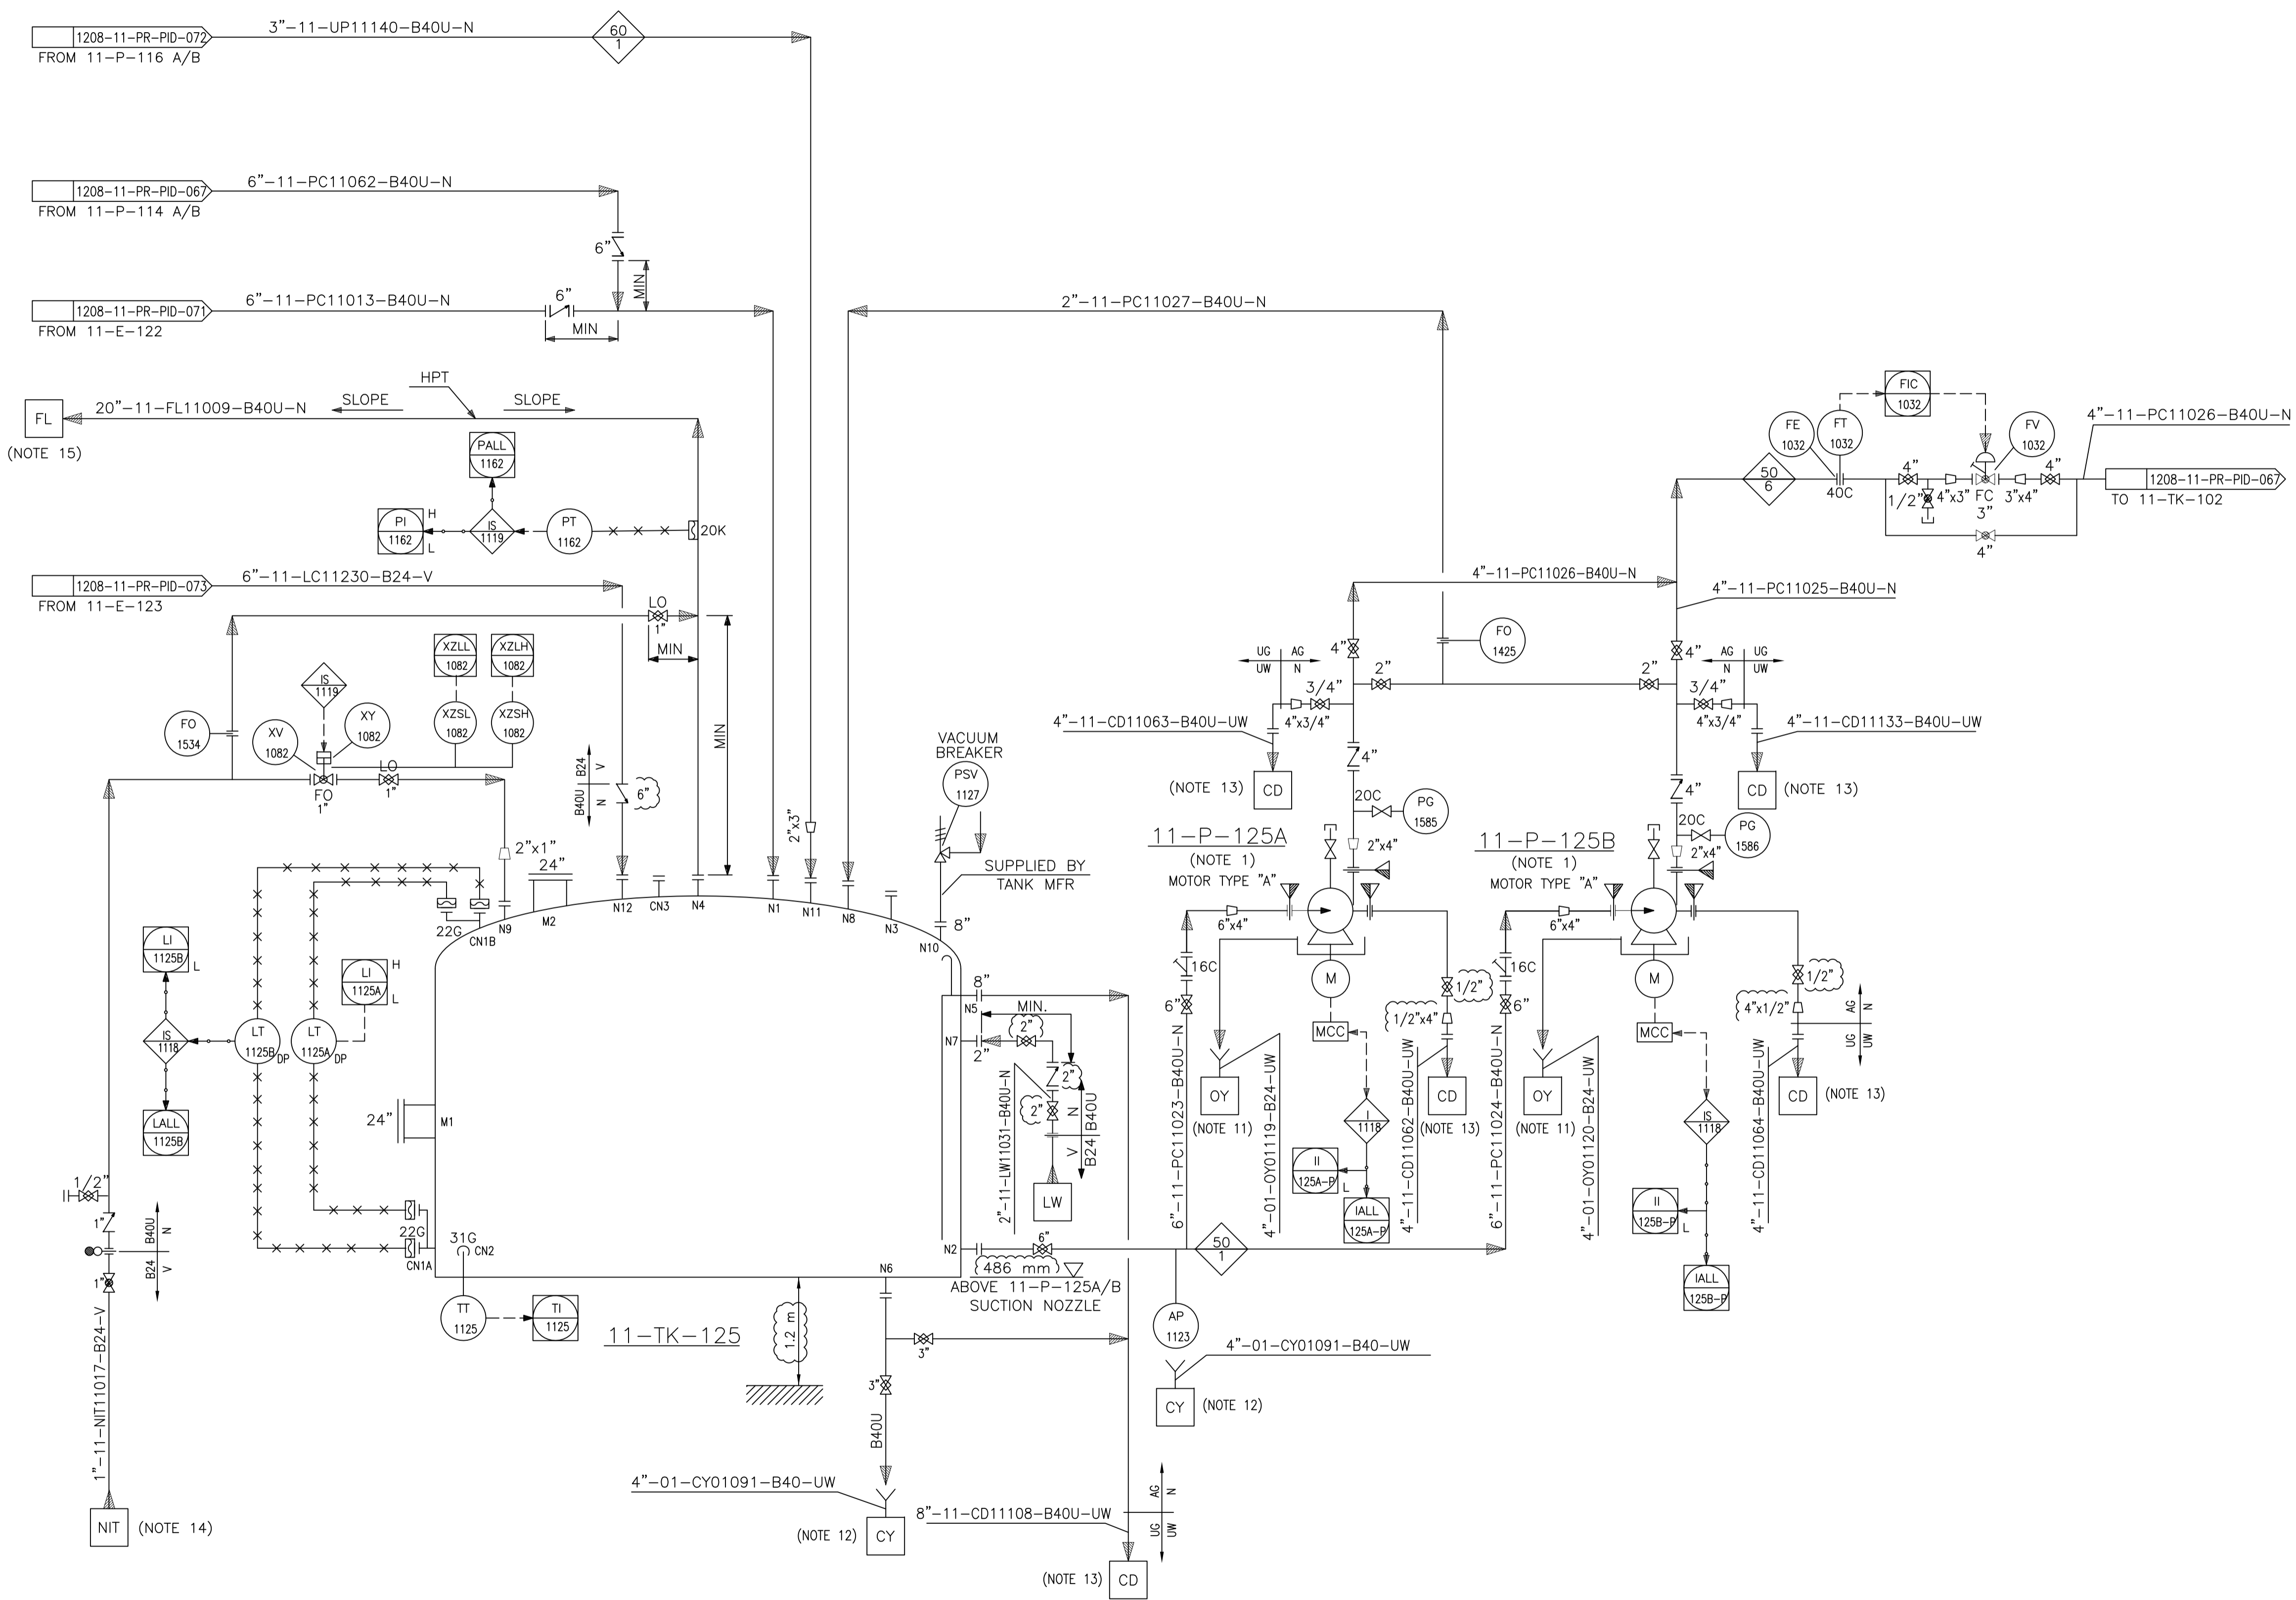

11-P-125A/B	11-TK-125
PROCESS OFF SPEC RECOVERY PUMPS	PROCESS OFF SPEC TANK
RATED CAPACITY : 40 m ³ /hr	I.D. x T.L.TL : 13800 x 7000 mm
SPECIFIC GRAVITY : 0.988	DESIGN PRESS. : HYDROSTATIC+0.172 barg
DIFF. PRESSURE : 3.8 bar	DESIGN TEMP. : 100°C
INSULATION : NO	INSULATION : NO
TRIM LINE NO. : 11-PC11064-B40U-N	TRIM LINE NO. : 11-PC11036-B40U-N

- NOTES:
- 1) THE LINES SIZE OF THE MINIMUM FLOW LINE OF THE PUMP VERIFIED BASED ON PUMP SELECTION.
 - 2) ALL PUMPS CONNECTIONS DEFINED AS PER PUMP MFR SELECTION.

- GENERAL NOTES:
- 1) FOR SYMBOLS AND OTHER DETAILS PLEASE REFER TO DOC. 1208-01-PR-PID-051.
 - 2) FOR ALL "CD" LINES THE FLANGES ARE TO BE LOCATED AT MINIMUM DISTANCE FROM GRADE. ALL "CD" LINES SHALL HAVE SLOPE TO ENSURE FREE DRAINING TOWARDS 11-TK-104 TANK.
 - 3) SAFETY AND CONTROL VALVE IN/OUT LINES TO BE VERIFIED DURING ENGINEERING PHASE, AFTER CONTROL VALVES AND SAFETY VALVES SELECTION.
 - 4) MFR CONTRACTOR
 - 5) WHERE IT'S INDICATED "MIN" OR "MINIMUM DISTANCE" THE LENGTH OF THE INTERESTED PIPE TO BE KEPT AS SHORT AS POSSIBLE (ABOUT ONE HUNDRED MILLIMETERS) IN ORDER TO PREVENT DEAD ZONE.
 - 6) FOR THE DESCRIPTION OF ATTRIBUTES OF HYDRAULIC CONSTRAINTS OF LINES (SELF DRAINING, SLOPE, GRAVITY FLOW, ETC.) REFER TO DOC. "GENERAL REQUIREMENTS FOR PIPING" WHERE SPECIFIC REQUIREMENTS ARE INDICATED THAT PIPING SHALL FOLLOW. NO EXCEPTIONS ARE ALLOWED.
 - 7) ALL DRIP RINGS MUST BE INSTALLED TO HAVE THE RELEVANT TAPPING IN THE BOTTOM PART (THE LOWEST POINT). NO EXCEPTIONS ARE ALLOWED.
 - 8) ALL CHECK VALVES HAVE TO BE INSTALLED IN VERTICAL POSITION, UNLESS VENDOR DIFFERENT INDICATIONS.
 - 9) MECHANIZATION OF PIPING AND INSTRUMENTATION HAS BEEN PERFORMED ACCORDING WITH LICENSOR'S STANDARDS AS MINIMUM REQUIREMENT AND IT SHALL BE COMPLETED BY ENGINEERING CONTRACTOR.
 - 10) ALL INSTRUMENT IN THIS PAGE HAVE PREFIX NO. OF 11. FOR EXAMPLE 11-LV-1210.
 - 11) FOR OILY WATER DRAINAGE CONTINUATION REFER TO DWG.: 1208-01-PR-UDD-055.
 - 12) FOR CHEMICAL DRAINAGE CONTINUATION REFER TO DWG.: 1208-01-PR-UDD-056.
 - 13) FOR NITROGEN/NATURAL GAS LINES CONTINUATION REFER TO DWG.: 1208-01-PR-UDD-052.
 - 14) FOR UREA BLOW DOWN NETWORK REFER TO DWG.: 1208-01-SA-UDD-003.
 - 15) FOR COOLING WATER SUPPLY/RETURN CONTINUATION REFER TO DWG.: 1208-01-PR-UDD-053

HOLD
- DELETED
- DELETED

EQUIPMENT LIST	
11-E-170	11-P-170A/B
11-V-170	

LICENSOR REF. : P68

DE	EXT	AFC	A			
Eng. Phase	Purpose of Distribution (POD)	Purpose of Issue (POI)	Owner's Action			
04	01.01.2024	APPROVED FOR CONSTRUCTION	M.Fahrasi A.Azma A.Azma M.Sareri			
03	02.09.2023	APPROVED FOR CONSTRUCTION	M.Fahrasi A.Azma A.Azma M.Sareri			
02	22.11.2022	APPROVED FOR CONSTRUCTION (WITH HOLD)	M.Fahrasi M.Yazdani A.Azma M.Sareri			
01	12.06.2018	APPROVED FOR CONSTRUCTION (WITH HOLD)	M.Yazdani A.Azma A.Azma M.Sareri			
00	04.04.2017	ISSUED FOR ENGINEERING	F.Mezari A.Habibi A.Azma M.Sareri			
REV.	ISSUE DATE	DESCRIPTION	PREPARED BY	CHECKED BY	APPROVED BY	PROJECT

THIS DOCUMENT IS THE PROPERTY OF HFC. IT IS CONFIDENTIAL AND ALL RIGHTS RESERVED. NEITHER THE WHOLE NOR PART OF THIS DOCUMENT MAY BE DISCLOSED TO ANY THIRD PARTY. REPRODUCED, STORED IN ANY RETRIEVAL SYSTEM OR TRANSMITTED IN ANY FORM OR BY ANY MEANS WITHOUT THE PRIOR WRITTEN CONSENT OF HFC.

OWNER:


MC:

EPCC CONTRACTOR:

PROJECT: HENGAM FERTILIZER PROJECT

TITLE: PIPING AND INSTRUMENTATION DIAGRAM
DEMINERALIZED WATER CLOSED CIRCUIT

SCALE: N.T.S	OWNER PROJECT NO.: NA	DWG. NO.:	REV.:	SIZE:
1/1	PIDEC PROJECT NO.: 1208	1208-11-PR-PID-078	04	A1

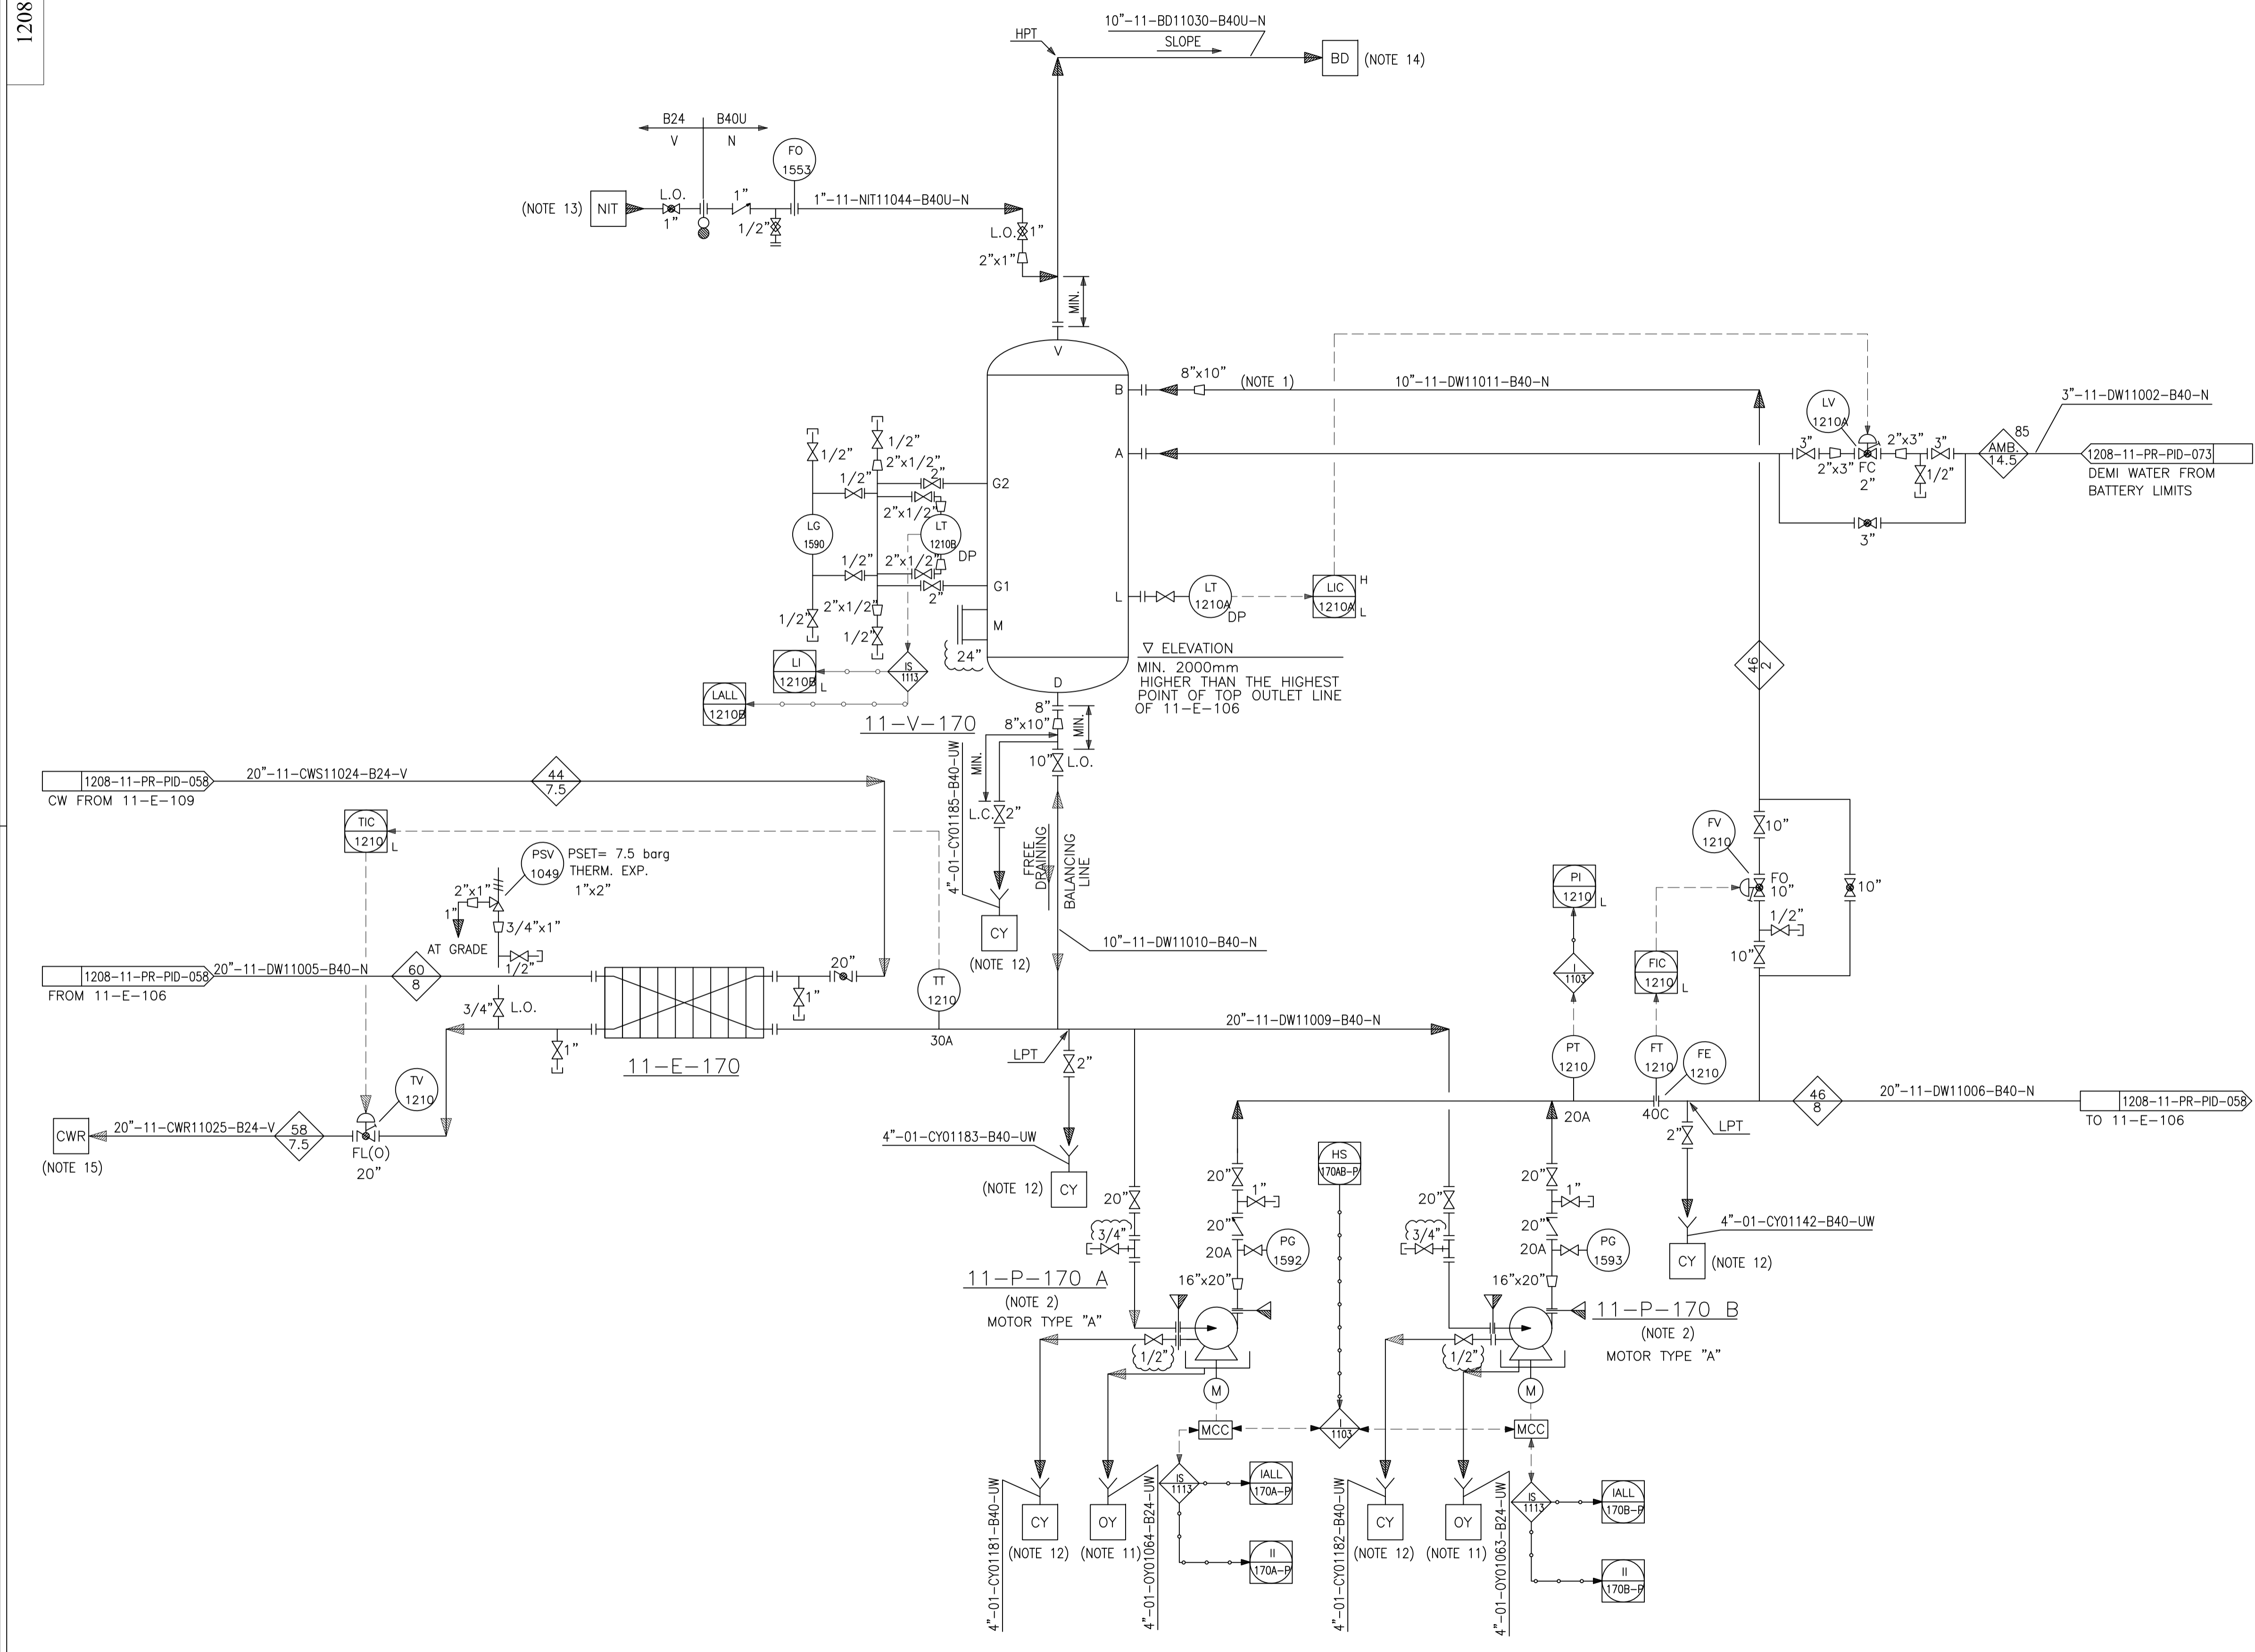


11-E-170	11-P-170 A/B	11-V-170
CLOSED CIRCUIT DEMINERALIZED WATER COOLER	CLOSED CIRCUIT DEMINERALIZED WATER PUMPS	CLOSED CIRCUIT DEMINERALIZED WATER EXPANSION DRUM
TYPE : PLATE EXCHANGER	RATED CAPACITY : 1625 m3/hr	I.D x T.L.TL : 1800 x 2000 mm
LENGTH X WIDTH X HEIGHT : 4200X1780X3540mm	SPECIFIC GRAVITY : 0.99	DESIGN PRESS. : 3.5 barg
DESIGN PRESS. SIDE A/B : 8/7.5 barg	DIFF. PRESSURE : 2.5 bar	DESIGN TEMP. : 90°C
DESIGN TEMP. SIDE A/B : 90/85°C	INSULATION : NO	INSULATION : NO
INSULATION : NO	TRIM LINE NO. : 11-DW11013-B40-N	TRIM LINE NO. : 11-DW11012-B40-N

- NOTES:**
- 1) VALVES TO BE OPERABLE FROM CLOSER PLATFORM.
 - 2) TWO PHASE FLOW REINFORCED SUPPORT.
 - 3) 11-V-111 TO BE GROUNDED.
 - 4) TANGENTIAL INLET CONNECTIONS.
 - 5) ELEVATION OF 11-V-111 STACK IS ABOUT 60 m ABOVE GROUND LEVEL.
 - 6) MINIMUM DISTANCE BETWEEN PIPE BOTTOM TANGENT LINES.
 - 7) 3500 mm.
 - 8) MAX. TEMPERATURE OF BD HEDER AND BD SEPARATOR IS 265°C.

- GENERAL NOTES:**
- 1) FOR SYMBOLS AND OTHER DETAILS PLEASE REFER TO DOC. 1208-01-PR-PID-051.
 - 2) FOR ALL "CD" LINES THE FLANGES ARE TO BE LOCATED AT MINIMUM DISTANCE FROM GRADE. ALL "CD" LINES SHALL HAVE SLOPE TO ENSURE FREE DRAINING TOWARDS 11-TK-104 TANK.
 - 3) SAFETY AND CONTROL VALVE IN/OUT LINES AND RELATED BY-PASS LINE SIZE TO BE VERIFIED DURING ENGINEERING PHASE, AFTER CONTROL VALVES AND SAFETY VALVES SELECTION.
 - 4) MFR CONTRACTOR
 - 5) WHERE IT'S INDICATED "MIN" OR "MINIMUM DISTANCE" THE LENGTH OF THE INTERESTED PIPE TO BE KEPT AS SHORT AS POSSIBLE (ABOUT ONE HUNDRED MILLIMETERS) IN ORDER TO PREVENT DEAD ZONE.
 - 6) FOR THE DESCRIPTION OF ATTRIBUTES OF HYDRAULIC CONSTRAINTS OF LINES (SELF DRAINING, SLOPE, GRAVITY FLOW, ETC.) REFER TO DOC. "GENERAL REQUIREMENTS FOR PIPING" WHERE SPECIFIC REQUIREMENTS ARE INDICATED THAT PIPING SHALL FOLLOW. NO EXCEPTIONS ARE ALLOWED.
 - 7) ALL DRIP RINGS MUST BE INSTALLED TO HAVE THE RELEVANT TAPPING IN THE BOTTOM PART (THE LOWEST POINT). NO EXCEPTIONS ARE ALLOWED.
 - 8) ALL CHECK VALVES HAVE TO BE INSTALLED IN VERTICAL POSITION, UNLESS VENDOR DIFFERENT INDICATIONS.
 - 9) MECHANIZATION OF PIPING AND INSTRUMENTATION HAS BEEN PERFORMED ACCORDING WITH LICENSOR'S STANDARDS AS MINIMUM REQUIREMENT AND IT SHALL BE COMPLETED BY ENGINEERING CONTRACTOR.
 - 10) FOR CLOSE DRAINAGE CONTINUATION REFER TO DWG.: 1208-01-PR-UPD-057.
 - 11) FOR STEAM AND CONDENSATE LINES CONTINUATION REFER TO DWG.: 1208-01-PR-UPD-051.

HOLD:
- DELETED

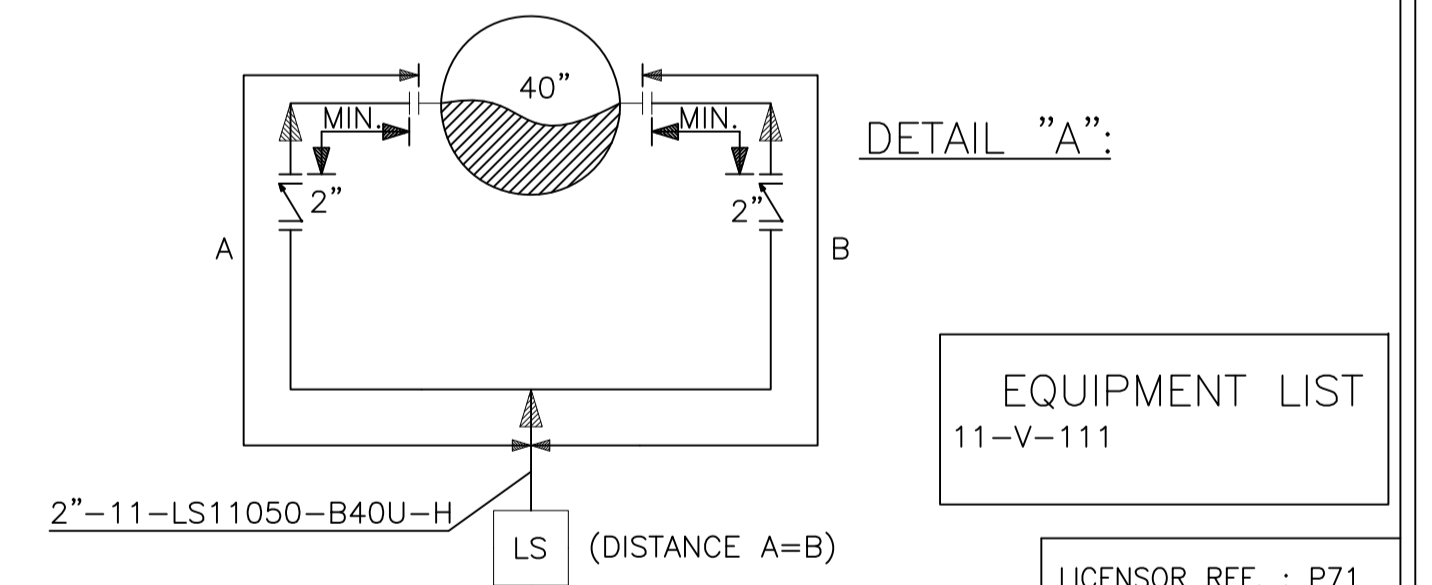

DE	EXT	AFC	A
Eng. Phase	Purpose of Distribution (POD)	Purpose of Issue (POI)	Owner's Action

REV.	ISSUE DATE	DESCRIPTION	PREPARED BY	CHECKED BY	APPROVED BY	PROJECT
04	01.01.2024	APPROVED FOR CONSTRUCTION	M.Fahrasi	A.Azma	A.Azma	M.Sarani
03	03.09.2023	APPROVED FOR CONSTRUCTION	M.Fahrasi	A.Azma	A.Azma	M.Sarani
02	22.11.2022	APPROVED FOR CONSTRUCTION	M.Fahrasi	M.Yazdani	A.Azma	M.Sarani
01	12.06.2018	APPROVED FOR CONSTRUCTION (WITH HOLD)	M.Yazdani	A.Azma	A.Azma	M.Sarani
00	19.09.2017	ISSUED FOR ENGINEERING	F.Mizani	A.Habibi	A.Azma	M.Sarani

OWNER:

MC:


EPCC CONTRACTOR:

PROJECT: HENGAM FERTILIZER PROJECT

TITLE: PIPING AND INSTRUMENTATION DIAGRAM BLOW DOWN SYSTEM

SCALE: N.T.S. OWNER PROJECT NO.: NA DWG. NO.: 1208-11-PR-PID-079 REV. SIZE: 04 A1


PIDEC PROJECT NO.: 1208

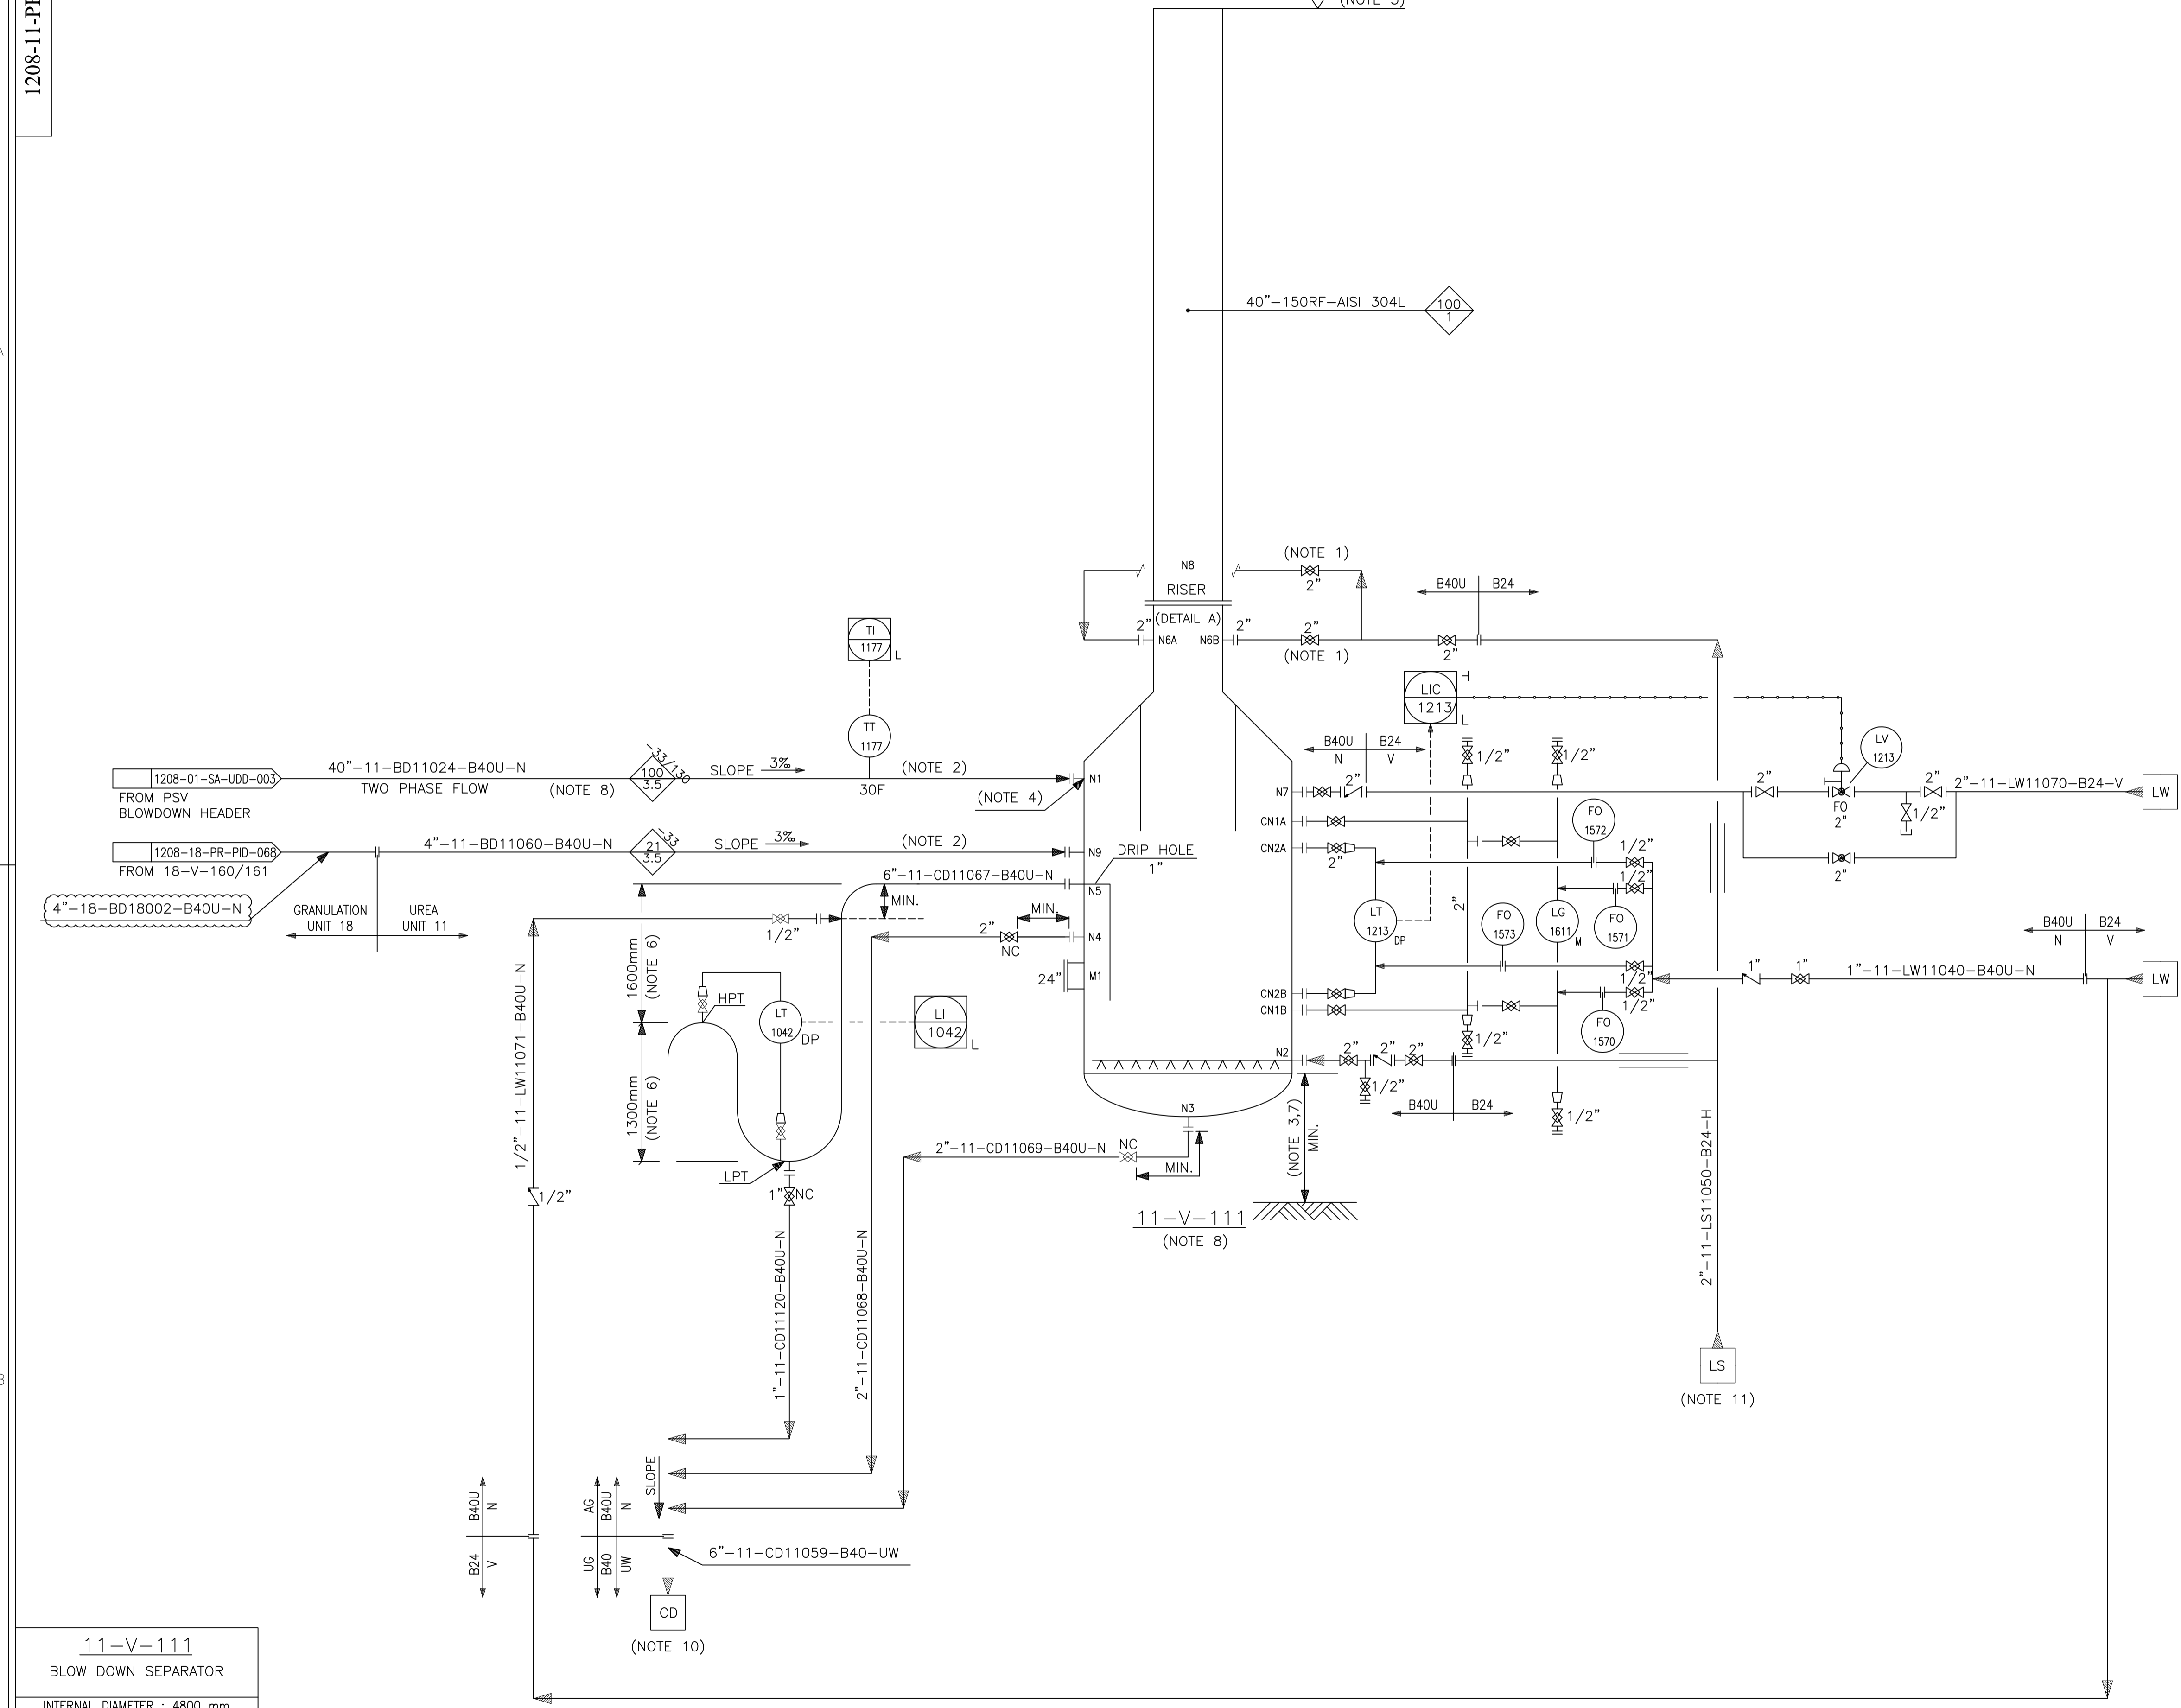

11-V-111
BLOW DOWN SEPARATOR
INTERNAL DIAMETER : 4800 mm
TL-TL LENGTH : 9406mm
MATERIAL : AISI 304L
DESIGN PRESSURE : 3.5 barg
DESIGN TEMPERATURE : 130 °C
TYPE : VERTICAL
INSULATION : NO
TRIM LINE NO. : 11-CD11079-B40U-N


1208-11-PR-PID-080

PIPING ARRANGEMENT 1

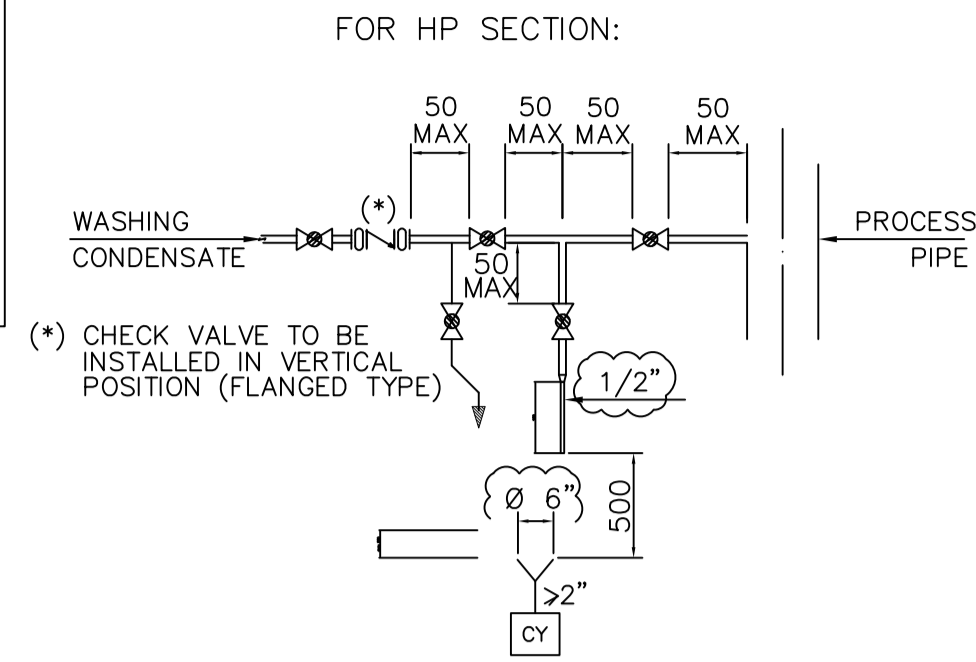



(*) CHECK VALVE TO BE INSTALLED IN VERTICAL POSITION (FLANGED TYPE)

FOR MP, LP AND VACUUM SECTIONS:

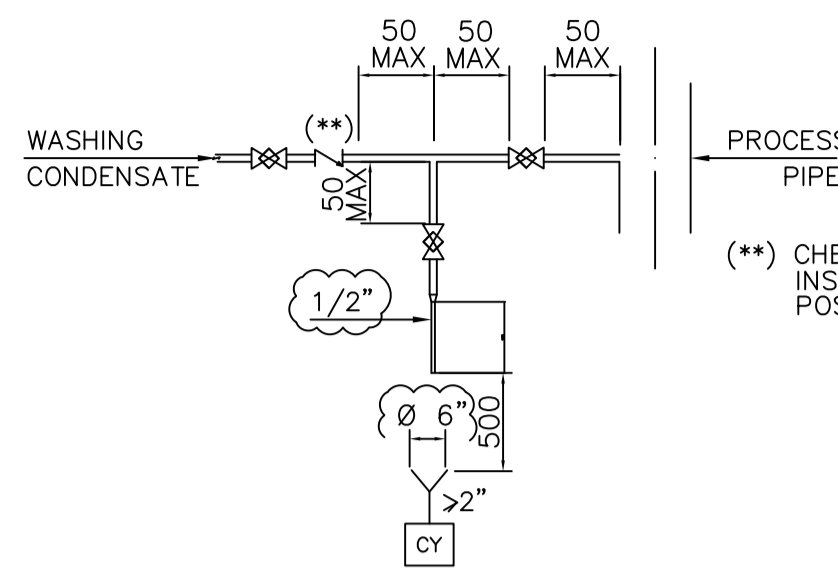

(**) CHECK VALVE TO BE INSTALLED IN VERTICAL POSITION (WELDED TYPE)

REPRESENTATION ON PROCESS PID

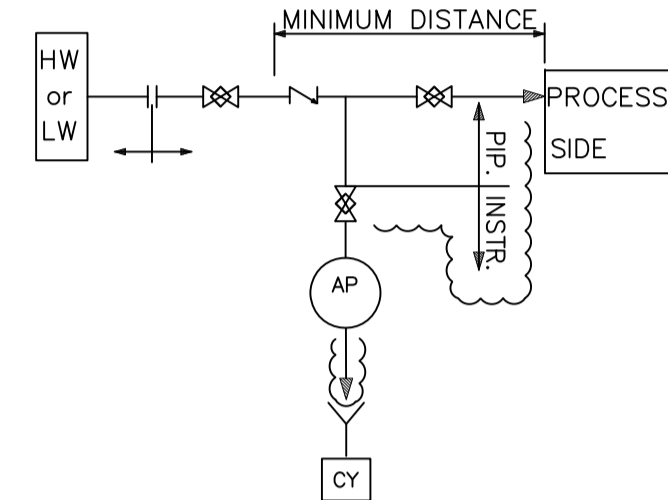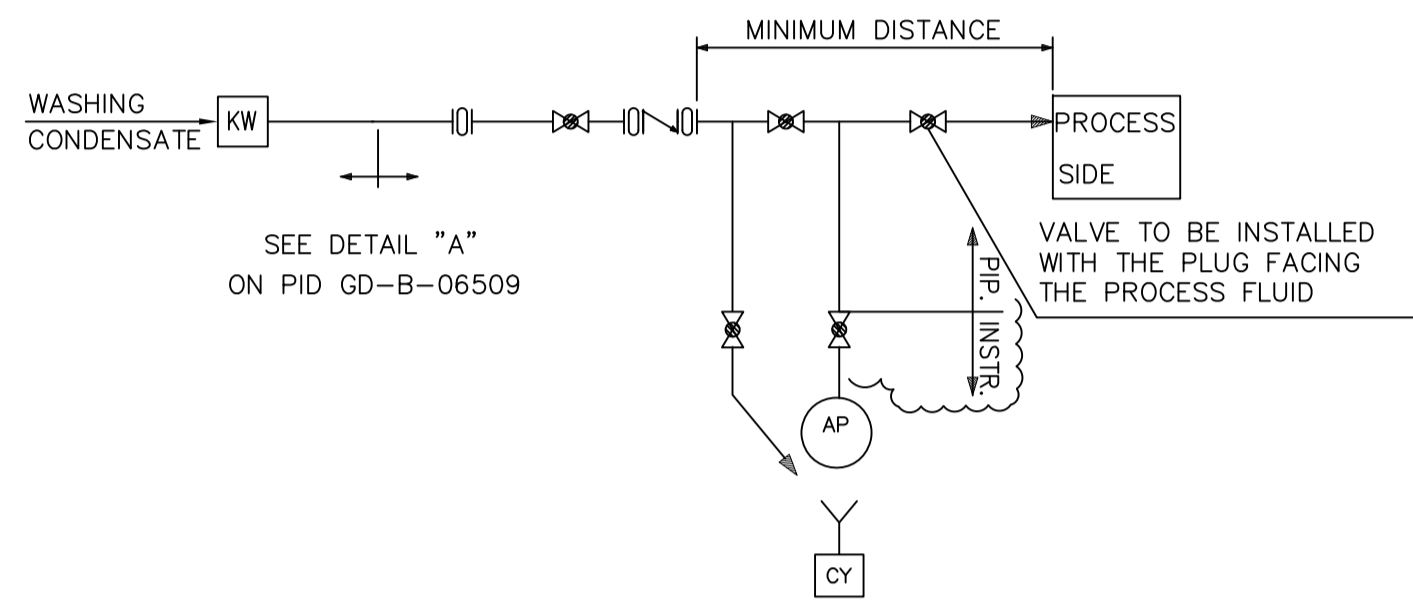


SAMPLE CONNECTION	PROCESS P&ID	VALVES TYPE	DESIGN PRESS bar (g)	OPERATING TEMPERATURE °C
AP-1103	1208-11-PR-PID-056	GLOBE	192	155
AP-1104	1208-11-PR-PID-053	GLOBE	192	188
AP-1105	1208-11-PR-PID-054	GLOBE	192	204


SAMPLE CONNECTION	PROCESS P&ID	VALVES TYPE	DESIGN PRESS bar (g)	OPERATING TEMPERATURE °C
UREA UNIT - 11				
AP-1106	1208-11-PR-PID-057	PLUG	31	160
AP-1107 A/B	1208-11-PR-PID-052	PLUG	31	79
AP-1110	1208-11-PR-PID-061	PLUG	12	148
AP-1112	1208-11-PR-PID-063	PLUG	12	44
AP-1114	1208-11-PR-PID-065	PLUG	12	102
AP-1115	1208-11-PR-PID-068	PLUG	12	104
AP-1120	1208-11-PR-PID-066	PLUG	12	135
AP-1121	1208-11-PR-PID-068	PLUG	12	150
GRANULATION UNIT - 18				
AP-2501	1208-18-PR-PID-067	PLUG	12	48
AP-2502	1208-18-PR-PID-072	PLUG	12	50
AP-2508	1208-18-PR-PID-051	PLUG	12	135
AP-2510	1208-18-PR-PID-062	PLUG	12	50
AP-2511	1208-18-PR-PID-063	PLUG	12	43
AP-2512	1208-18-PR-PID-070	PLUG	12	50

PIPING ARRANGEMENT 2

FOR PROCESS CONDENSATE TREATMENT SECTION AND AMMONIA WATER SOLUTION:

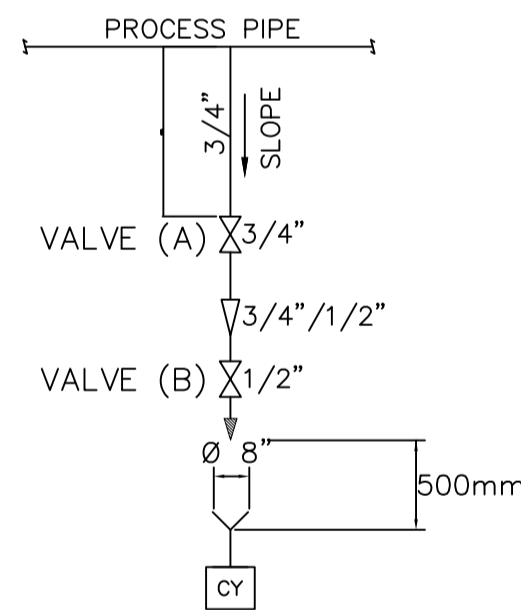


REPRESENTATION ON PROCESS PID

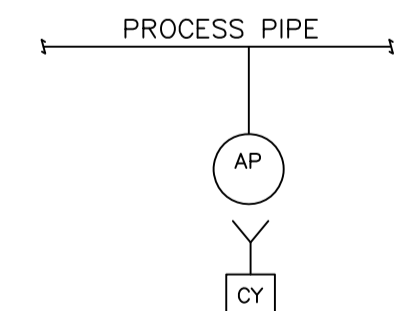

SAMPLE CONNECTION	PROCESS P&ID	DESIGN PRESS bar (g)	OPER. TEMP. °C	VALVE TYPE (A)	VALVE TYPE (B)
AMMONIA WATER SOLUTION					
AP-1111	1208-11-PR-PID-060	24	50	BALL	GLOBE
PROCESS CONDENSATE TREATMENT SECTION					
AP-1116	1208-11-PR-PID-067	1	50	PLUG	GLOBE
AP-1123	1208-11-PR-PID-077	1	50	PLUG	GLOBE


PIPING ARRANGEMENT 3

TYPICAL FOR CO2 GAS SAMPLING (O2 ANALYZER)

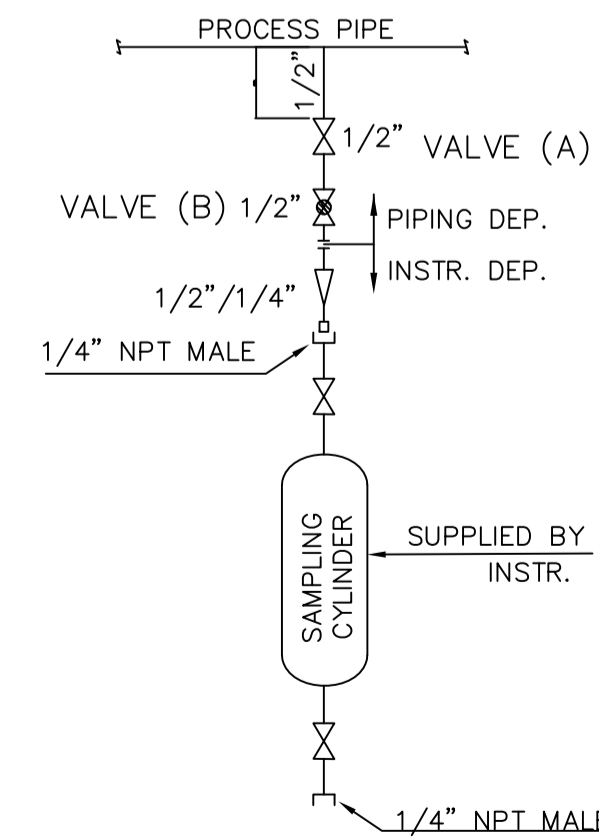

PIPING ARRANGEMENT 4

FOR AMMONIA IN MP AND LP SECTION

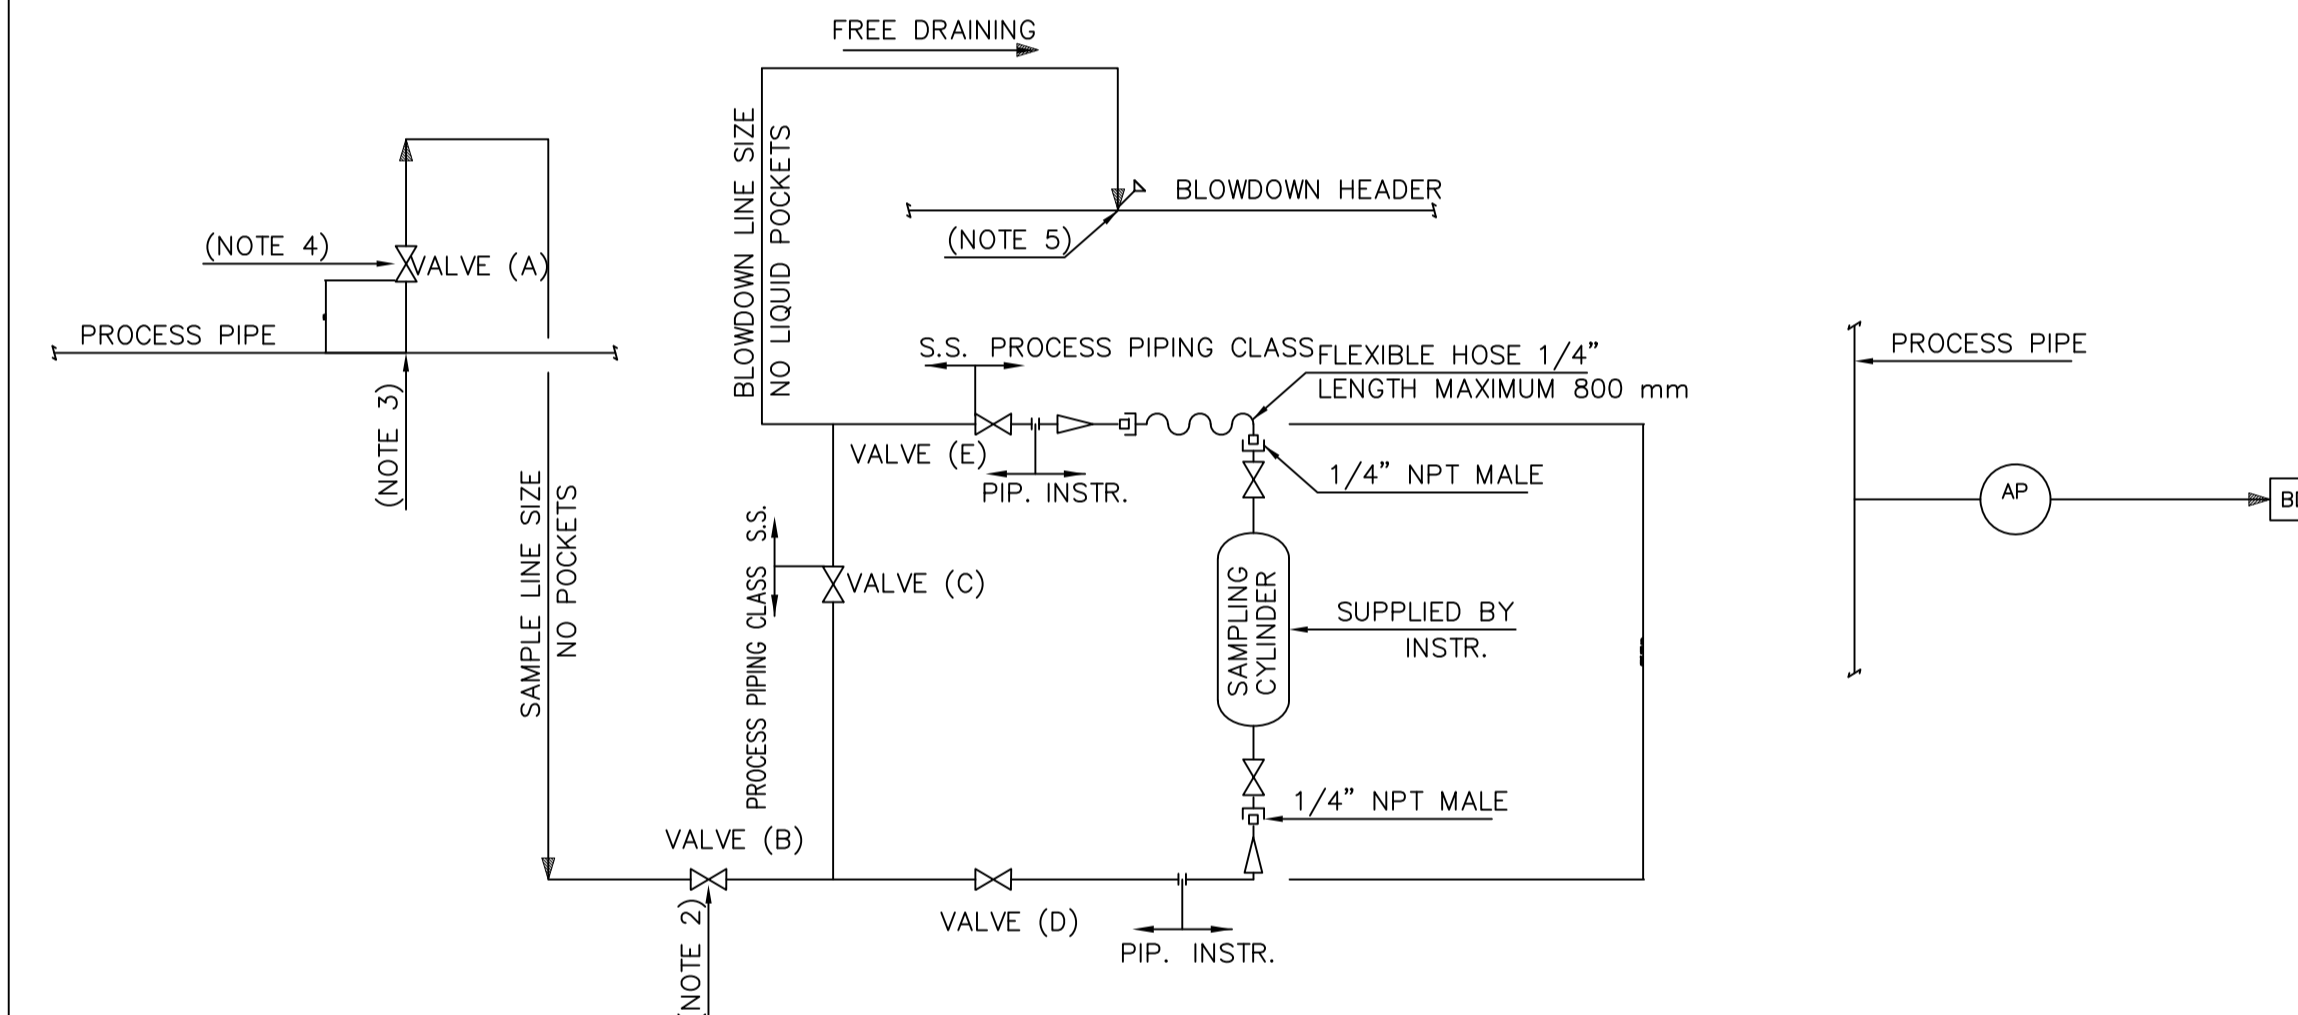

SAMPLE CONNECTION	PROCESS P&ID	SAMPLE LINE SIZE	BLOW DOWN LINE SIZE	OPERATING PRESSURE bar (g)	DESIGN PRESSURE bar (g)	TYPE VALVE (A)	TYPE VALVE (B)	TYPE VALVE (C)	TYPE VALVE (D)	TYPE VALVE (E)	VALVE SIZE
AP-1102	1208-11-PR-PID-059	1/2"	1/2"	24	30	BALL	BALL	BALL	BALL	BALL	1/2"
AP-1109	1208-11-PR-PID-060	1/2"	1/2"	18.8	24	BALL	BALL	BALL	BALL	BALL	1/2"
AP-1113	1208-11-PR-PID-063	1/2"	1/2"	3.2	7	PLUG	PLUG	PLUG	PLUG	PLUG	1/2"

REFERENCE DRAWING

DWG. NO.

SYMBOLS AND IDENTIFICATIONS

1208-01-PR-PID-051-01


NOTES:

- 1) FOR SAMPLING PROCEDURE REFER TO ANALYTICAL MANUAL PLAN.
- 2) TO BE PROVIDED ONLY IF UPSTREAM ISOLATION VALVE (MINIMUM DISTANCE FROM PROCESS PIPE) IS NOT OPERABLE SIMULTANEOUSLY WITH INLET, OUTLET AND BY-PASS VALVE FROM THE SAMPLING CYLINDER.
- 3) CONNECTING ON THE UPPER TANGENT LINE FOR GAS AND LOWER TANGENT LINE FOR LIQUID.
- 4) VALVE ACCESSIBLE BY OPERATORS.
- 5) CONNECTING ON THE UPPER TANGENT LINE. BLOWDOWN HEADER ELEVATION TO BE LOWER THAN RELEVANT PROCESS LINE WHERE SAMPLE IS RECOVERED.

GENERAL NOTES:

- 1) FOR LEGEND AND TYPICAL DETAILS PLEASE REFER TO P&ID 1208-01-PR-PID-051.
- 2) FOR INSULATION LIMITS, REQUIREMENT AND VALVES (TYPE, DIAMETER, PIPING CLASS AND QUANTITY) REFER TO PROCESS P&IDS.

REPRESENTATION ON PROCESS PID

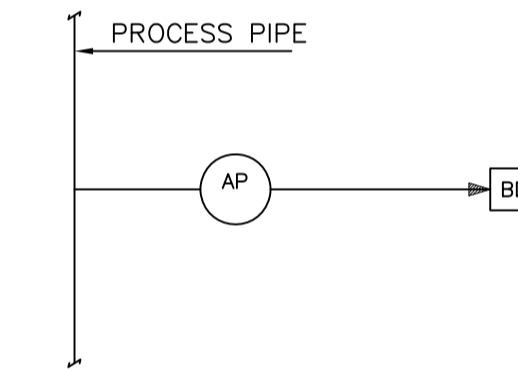

LICENSOR REF. : P72

DE	EXT	AFC	A
Eng. Phase	Purpose of Distribution (POD)	Purpose of Issue (POI)	Owner's Action

REV.	ISSUE DATE	DESCRIPTION	PREPARED BY	CHECKED BY	APPROVED BY	PROJECT
02	26.11.2022	APPROVED FOR CONSTRUCTION	M.Fakhrul	M.Yasirpanah	A.Azma	M.Sarafi
01	12.06.2018	APPROVED FOR CONSTRUCTION (WITH HOLD)	M.Yasirpanah	A.Azma	A.Azma	M.Sarafi
00	04.04.2017	ISSUED FOR ENGINEERING	F.Mizal	A.Habibi	A.Azma	M.Sarafi

OWNER:

MC:

EPCC CONTRACTOR:


PROJECT: HENGAM FERTILIZER PROJECT

TITLE: PIPING AND INSTRUMENTATION DIAGRAM SAMPLE CONNECTION DETAIL PART 1

SCALE: N.T.S	OWNER PROJECT NO.: NA	DWG. NO.:	REV.:	SIZE:
SHT.: 1 OF 1	PIDEC PROJECT NO.: 1208	1208-11-PR-PID-080	02	A1

PIPING ARRANGEMENT 5


PROCESS CONDENSATE TREATMENT SECTION

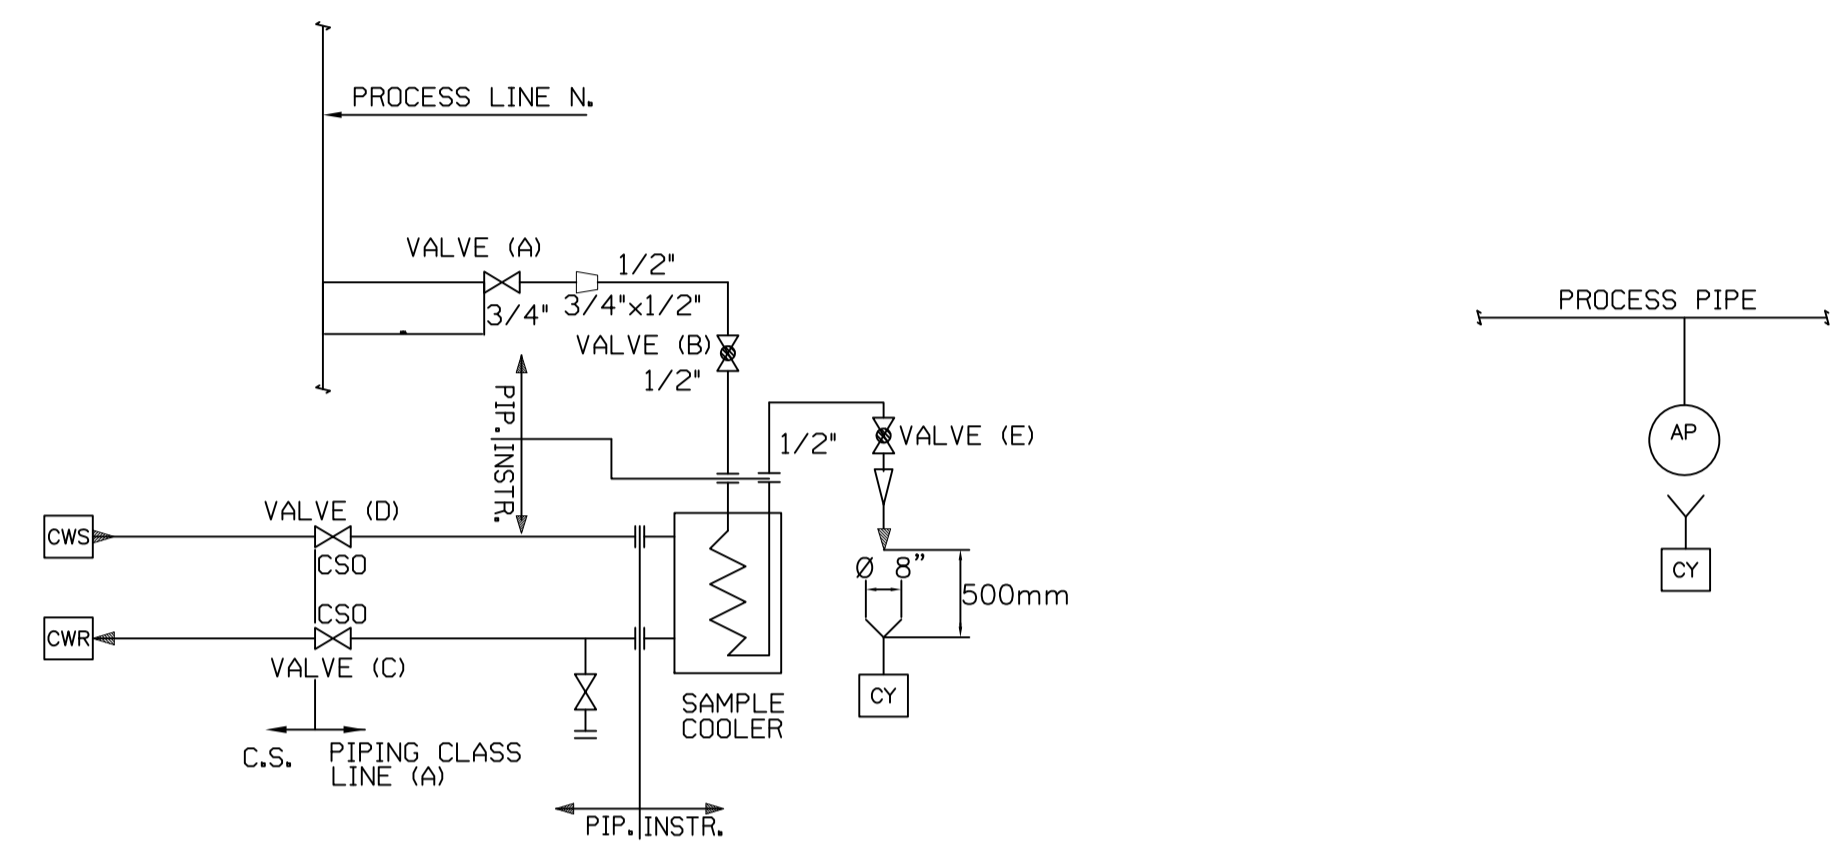


SAMPLE CONNECTION	PROCESS P&ID	OPERATING TEMPERATURE % C	DESIGN PRESSURE bar (g)	VALVE (A)	VALVE (B)	VALVE (C)	VALVE (D)	VALVE (E)
UREA UNIT - 11								
AP-1117	1208-11-PR-PID-069	147	7	GATE	GLOBE	GATE	GATE	GLOBE
AP-1118	1208-11-PR-PID-070	165	45	GATE	GLOBE	GATE	GATE	GLOBE
GRANULATION UNIT - 18								
AP-2515	1208-18-PR-PID-066	95	6	GATE	GLOBE	GATE	GATE	GLOBE

PIPING ARRANGEMENT 6

LIQUID AMMONIA FROM P-101 A/B SEAL SYSTEM

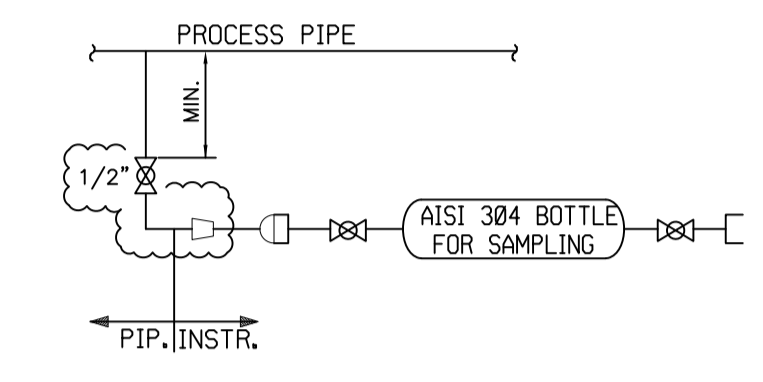

REPRESENTATION ON PROCESS PID

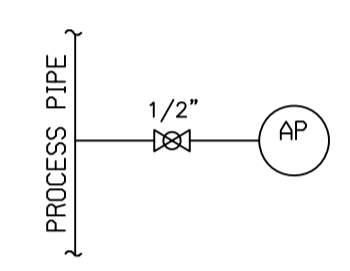

SAMPLE CONNECTION	PROCESS P&ID	OPERATING TEMPERATURE % C	DESIGN PRESSURE bar (g)	VALVE TYPE
AP-1125A	1208-11-PR-PID-051	36	24	BALL
AP-1125B	1208-11-PR-PID-051	36	24	BALL

THE FOLLOWING SAMPLE CONNECTIONS USE THE OUTLET CONNECTION OF THE RELEVANT ANALYZER FOR THEIR CHECKING, IF ANY.

MINIMUM DISTANCE OF 500 mm BETWEEN CY FUNNEL AND ANALYZER OUTLET CONNECTION SHALL BE ENSURED.

SAMPLE CONNECTION	PROCESS P&ID	CONDUCTIVITY METER
AP-1108	1208-11-PR-PID-055	AT-1005A
AP-1119	1208-11-PR-PID-071	AT-1006
AP-1122	1208-11-PR-PID-073	AT-1004
AP-1126	1208-11-PR-PID-055	AT-1005B
AP-1127	1208-11-PR-PID-075	AT-1003

NOTES:

GENERAL NOTES:

- 1) FOR LEGEND AND TYPICAL DETAILS PLEASE REFER TO P&ID 120-01-PR-PID-051.
- 2) FOR INSULATION LIMITS, REQUIREMENT AND VALVES (TYPE, DIAMETER, PIPING CLASS AND QUANTITY) REFER TO PROCESS P&IDS.

LICENSOR REF. : P73

DE	EXT	AFC	A
Eng. Phase	Purpose of Distribution (POD)	Purpose of Issue (POI)	Owner's Action

REV.	ISSUE DATE	DESCRIPTION	PREPARED BY	CHECKED BY	APPROVED BY	PROJECT
03	01.01.2024	APPROVED FOR CONSTRUCTION	M.Fakhrasi	A.Azma	A.Azma	M.Saremi
02	26.11.2022	APPROVED FOR CONSTRUCTION	M.Fakhrasi	M.Yazdaniarani	A.Azma	M.Saremi
01	12.06.2018	APPROVED FOR CONSTRUCTION (WITH HOLD)	M.Yazdaniarani	A.Azma	A.Azma	M.Saremi
00	04.04.2017	ISSUED FOR ENGINEERING	F.Mizani	A.Habibi	A.Azma	M.Saremi

OWNER:

MC:

EPCC CONTRACTOR:

PROJECT: HENGAM FERTILIZER PROJECT

TITLE: PIPING AND INSTRUMENTATION DIAGRAM
SAMPLE CONNECTION DETAIL PART 2

SCALE: N.T.S. OWNER PROJECT NO.: NA DWG. NO.: 1208-11-PR-PID-081 REV. 03 SIZE: A1

PIDEC PROJECT NO.: 1208

THIS DOCUMENT IS THE PROPERTY OF HFC. IT IS CONFIDENTIAL AND ALL RIGHTS RESERVED. NEITHER THE WHOLE NOR PART OF THIS DOCUMENT MAY BE DISCLOSED TO ANY THIRD PARTY. REPRODUCED, STORED IN ANY RETRIEVAL SYSTEM OR TRANSMITTED IN ANY FORM OR BY ANY MEANS WITHOUT THE PRIOR WRITTEN CONSENT OF HFC.